SITE PLAN
for
R. VOELKER
SUBLOT 145 LAKE BREEZE PARK
MADISON TOWNSHIP
LAKE CO., OHIO
1" = 20' MAR 1974

Milton A. Boardower
Registered Surveyor #247

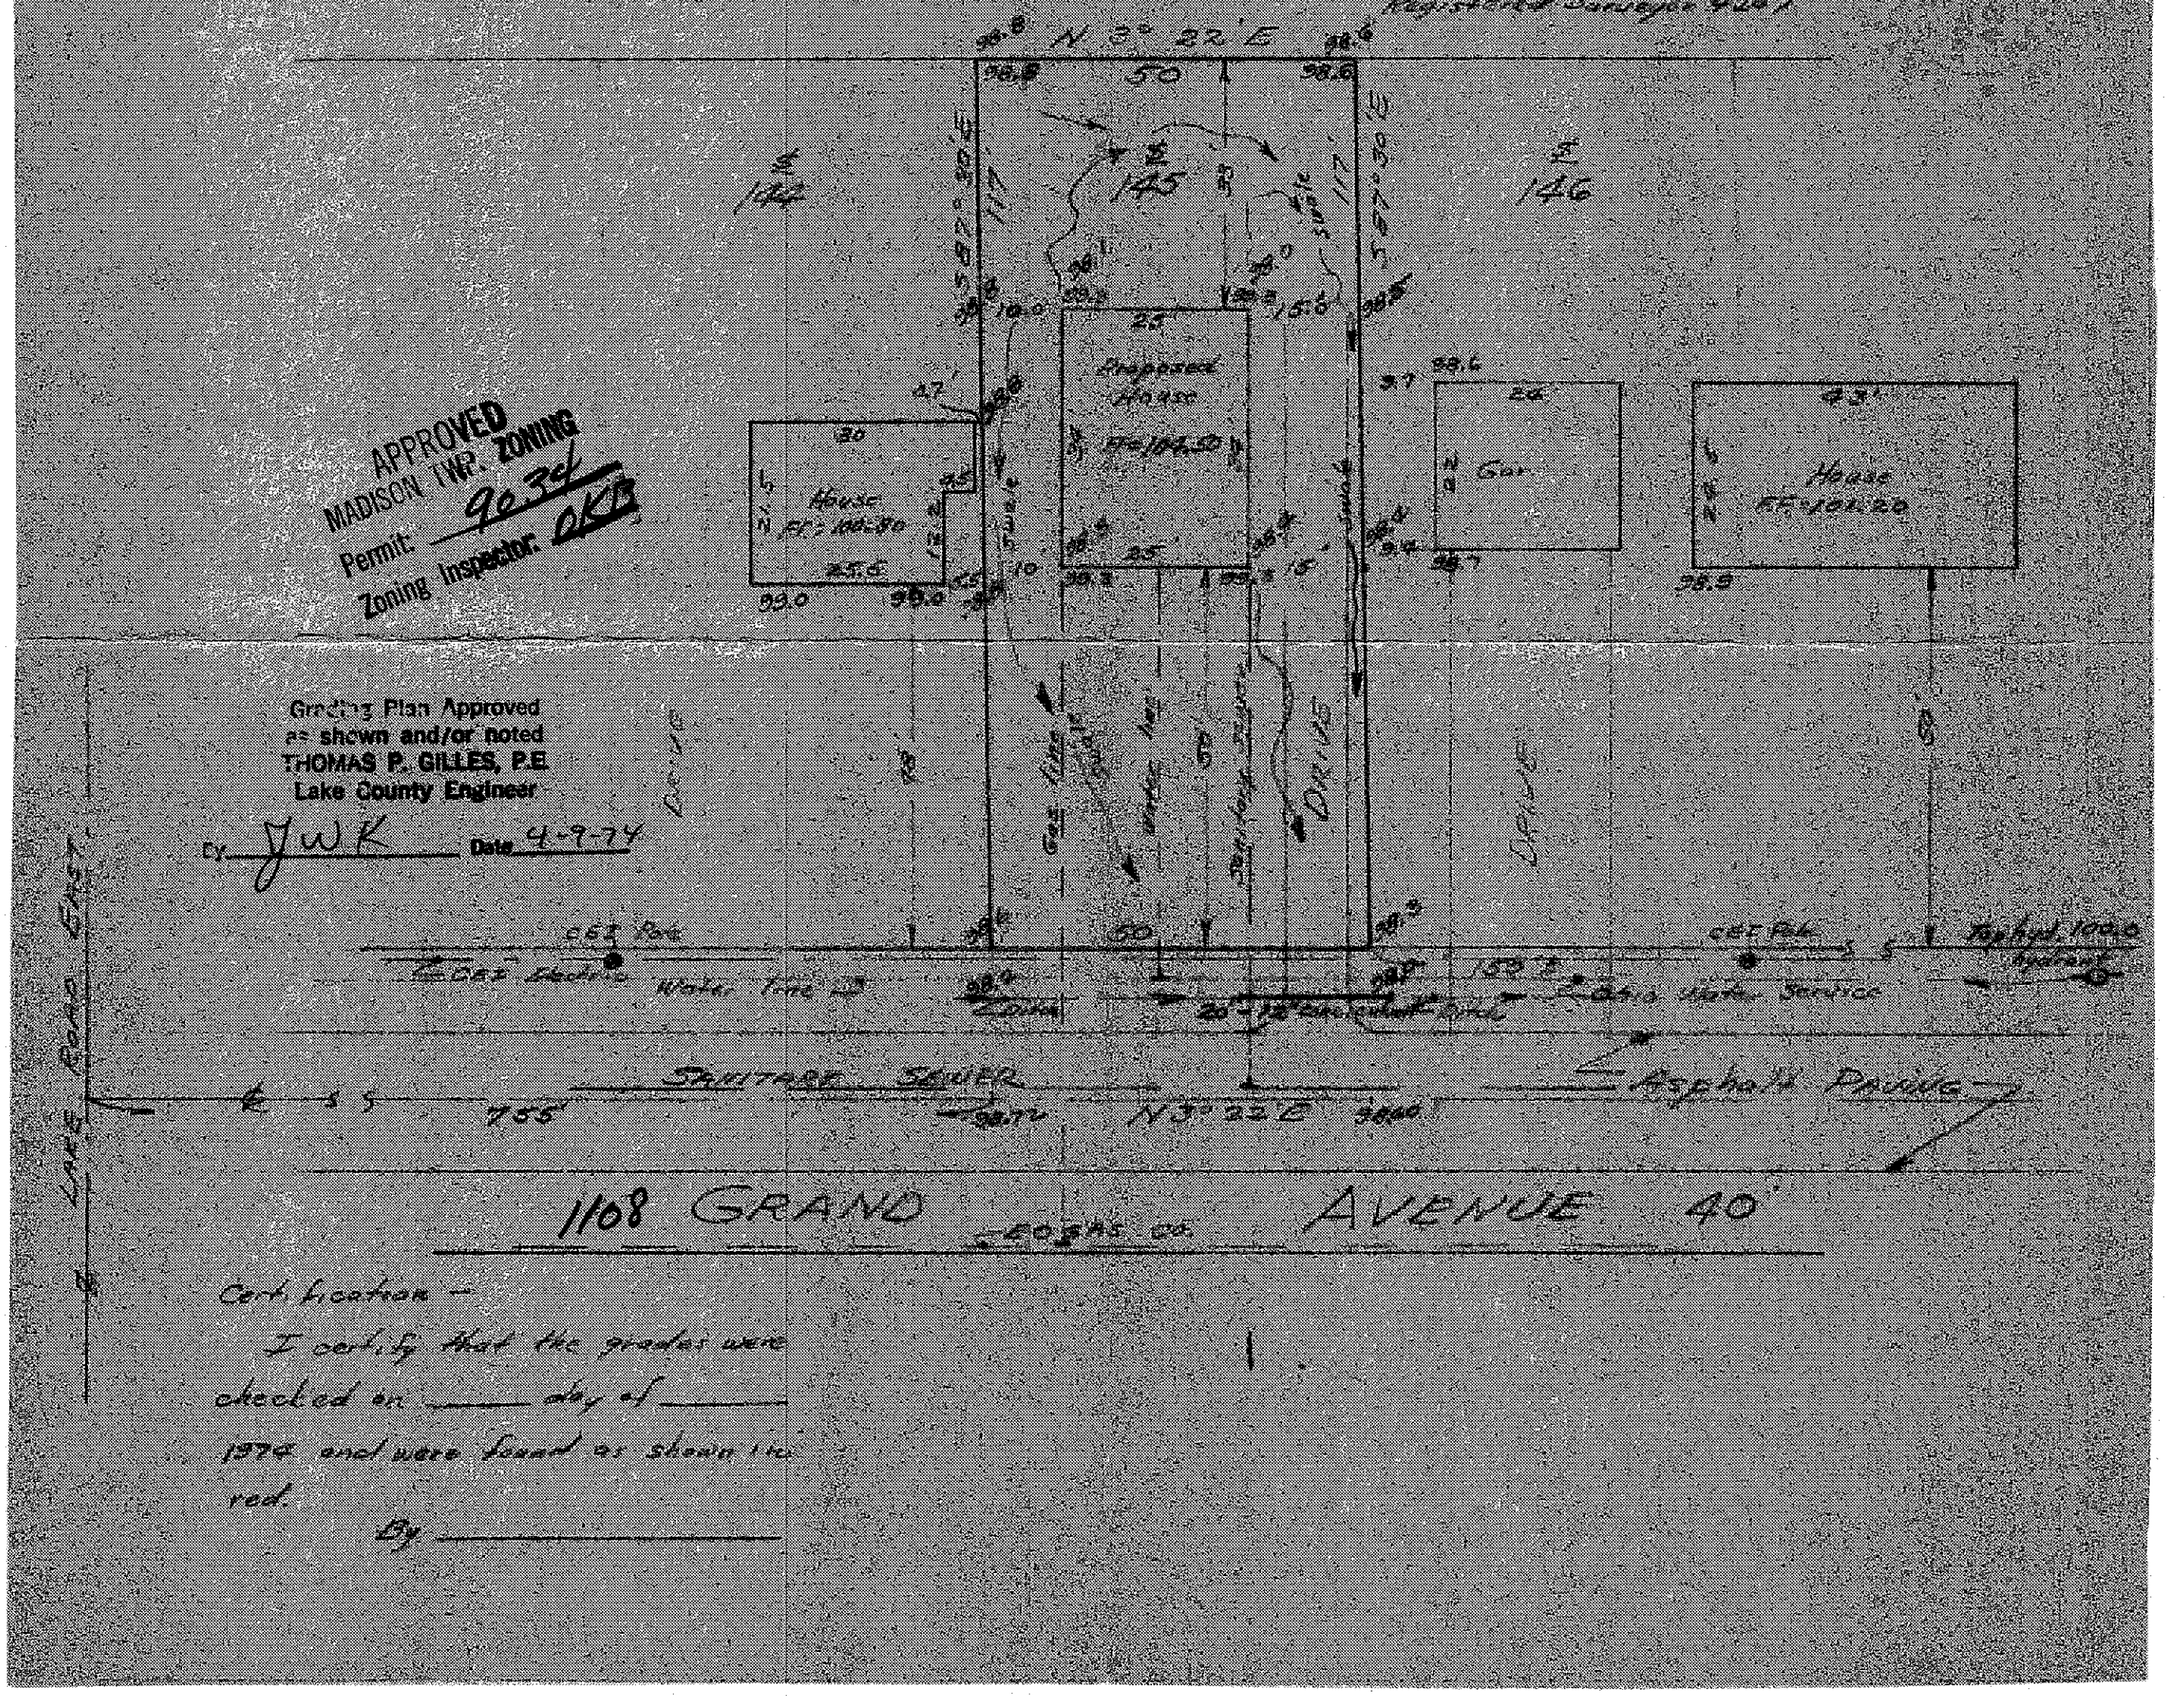

APPROVED
MADISON TWP. ZONING
Permit: 96 34
Zoning Inspector: OKB

Grading Plan Approved
as shown and/or noted
THOMAS P. GILLES, P.E.
Lake County Engineer
By JWK Date 4-9-74

Certification —

I certify that the grades were checked on ____ day of ____ 1974 and were found as shown hereon.

By ____