APPROVED
MADISON TWP. ZONING
Permit: 1259
Zoning Inspector: UL
JUN. 18 1990

Grading Plan Approved
as shown and/or noted
THOMAS P. GILLES, P.E.
Lake County Engineer
By GJH Date 6/18/90

SITE PLAN FOR BRIAN DODRILL
SUBLOT 152 LAKE BREEZE PARK
LAKE COUNTY, O. VOL I PG 79
LOT 16 TRACT I MADISON TWP.

• DENOTES 1/2" ϕ IRON PIN
99.87 EXISTING ELEV.
98.23 PROPOSED ELEV.
—101— EXISTING CONTOUR ELEV.
----99-- PROPOSED CONTOUR ELEV.
℄ PROPERTY LINE e/p EDGE PAV'T
℄ RIVER LINE R/W RIGHT OF WAY

JIM PETER LAND SURVEY
4759 CROSBY-COOK RD
ROME, O. 44085

I THE UNDERSIGNED HEREBY CERTIFY TH
THE TOPOGRAPHY SHOWN HEREON, INDIC
BY ONE FOOT CONTOURS AND ELEVATIONS
REPRESENTS AN ACTUAL TOPOGRAPHIC SU
MADE BY ME ON THE 13 DAY OF JUNE,
1990, AND THAT THE ELEVATIONS WERE
TAKEN AT APPROPRIATE INTERVALS AND TH
AS OF THIS DATE THEY EXISTED AS INDIC
HEREON.

STATE OF OHIO
JAMES M. PETER
6420
REGISTERED SURVEYOR
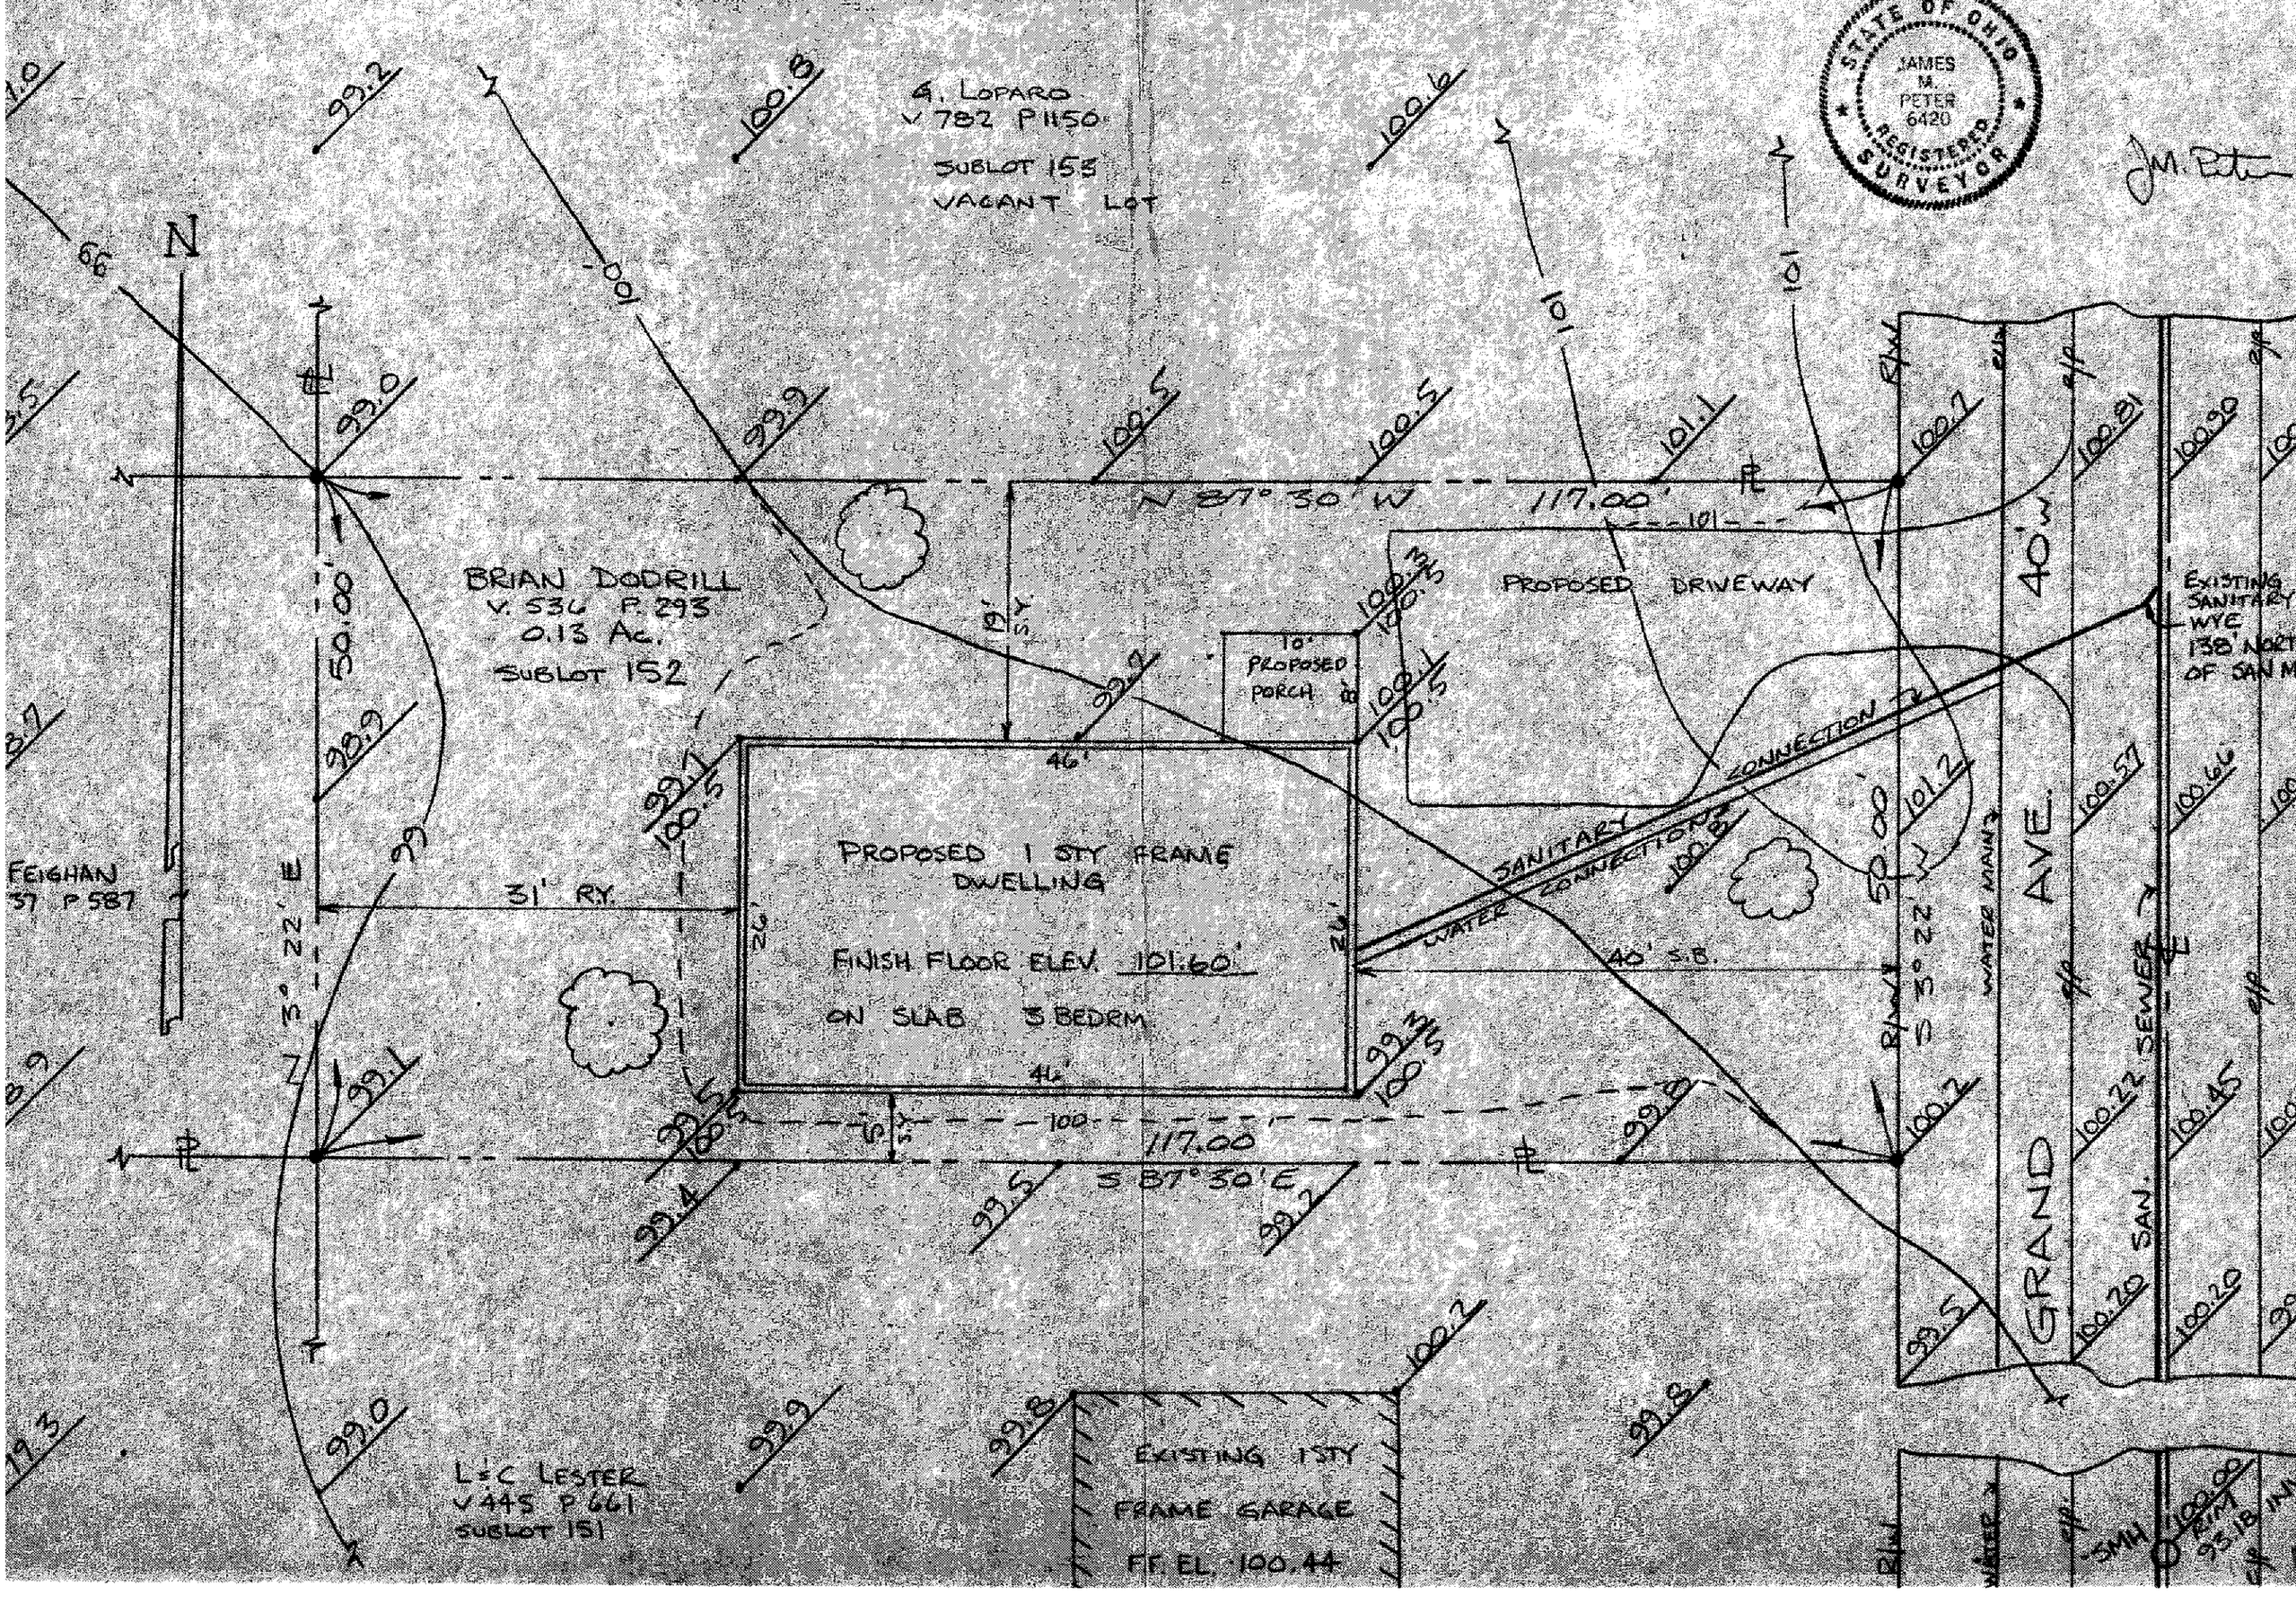
J.M. Peter