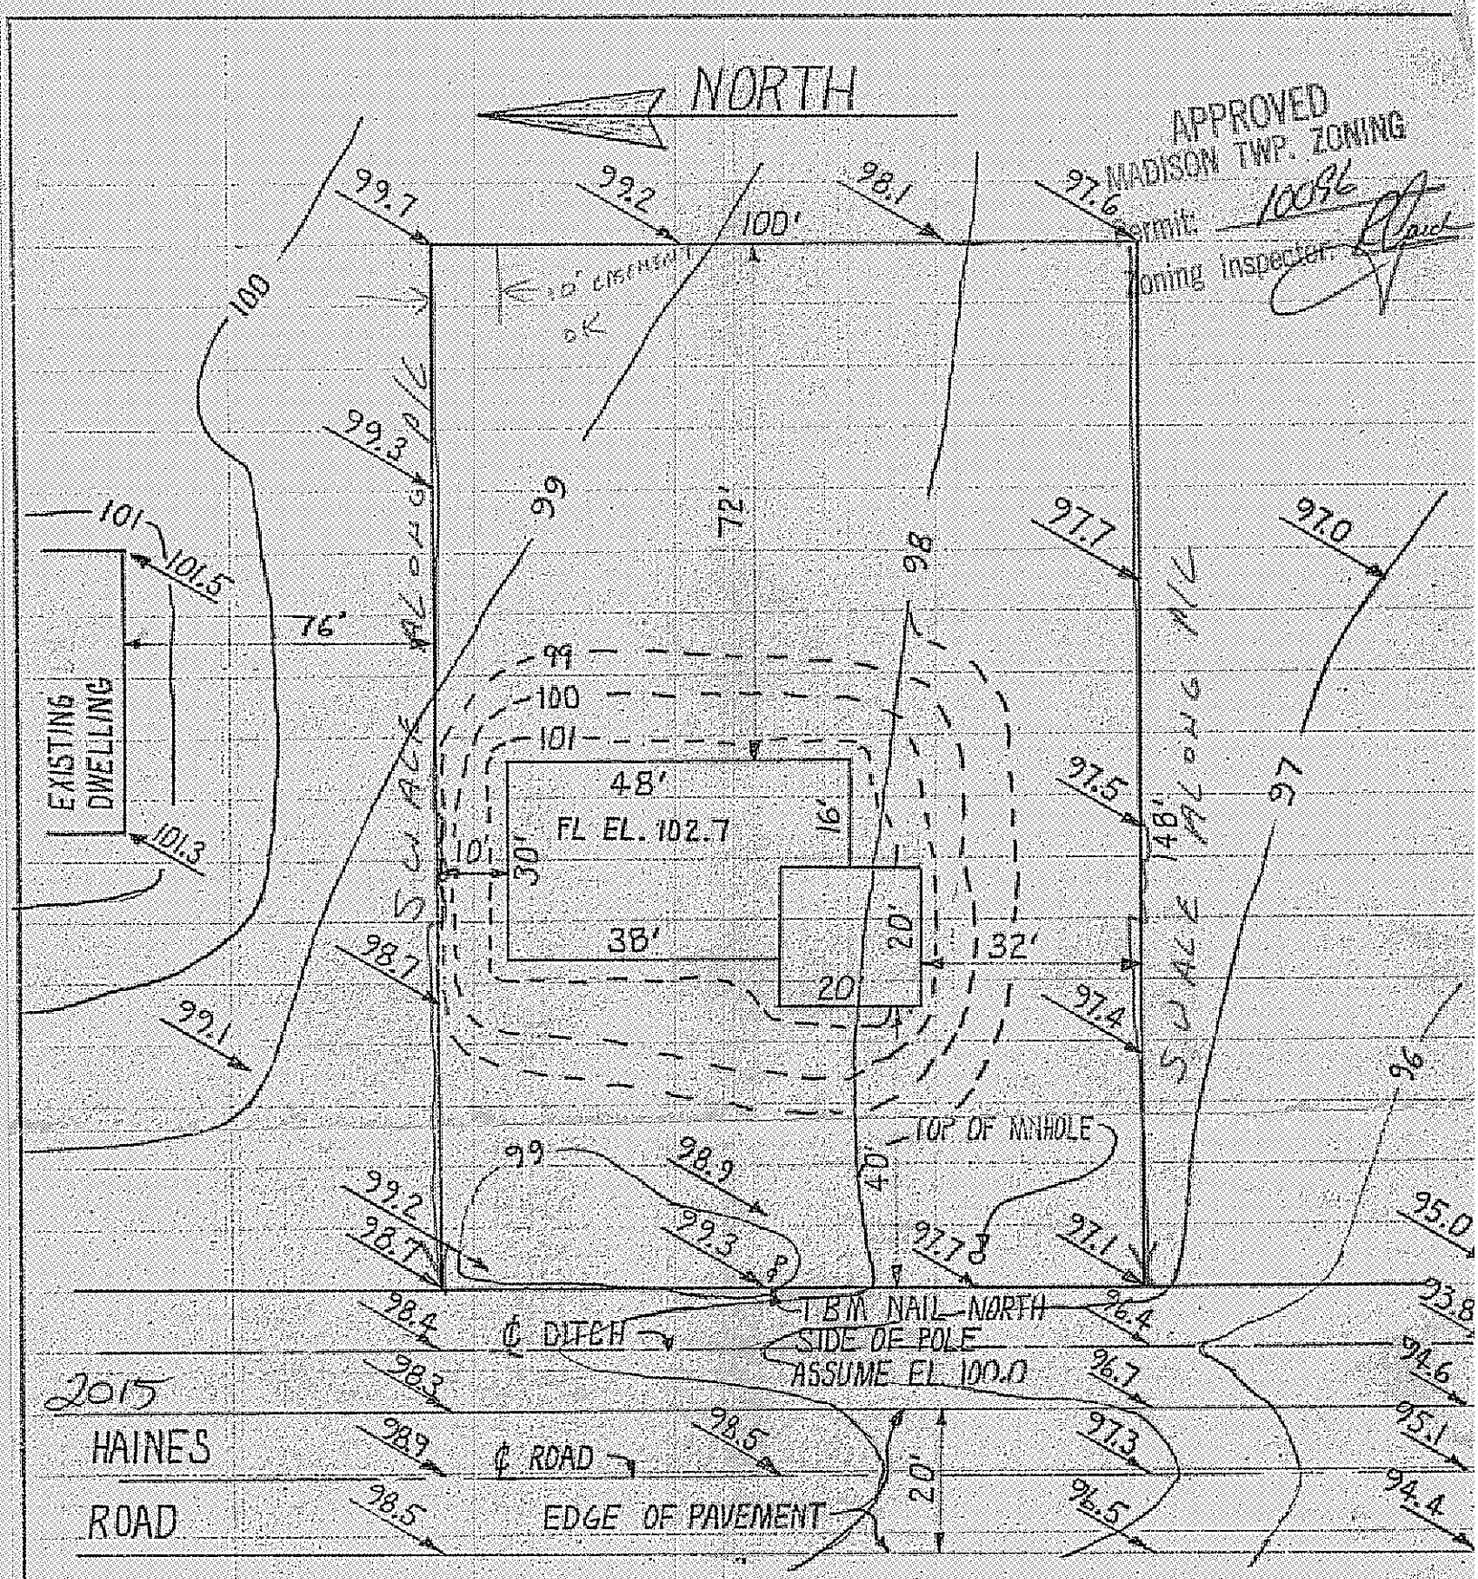

SITE PLAN

M.H. Drive Culvert 15" Dia.

MADISON TOWNSHIP, LAKE COUNTY, OHIO
LOT NO. 15 IN THE RAY ZIRKLE SUBDIVISION NO. 2
PART OF ORIGINAL LOT NO. 16, TRACT NO. 4
LAKE COUNTY RECORDS VOLUME 5 PAGE 3

Grading Plan Approved as shown and/or noted
THOMAS P. GILLES, P.E.
Lake County Engineer
By TPG Date 12 APR 2

4 BEDROOMS, 2 1/2 BATHS, FULL BASEMENT, 2 STORY, 2000 SQ. FT.

--- INDICATES PROPOSED CONTOURS
—— INDICATES EXISTING CONTOURS
99.1 → INDICATES EXISTING GRADE

OWNER: DON F. COOPER
6223 CAMPBELL, MADISON, OH.

THIS PLAN IS CORRECT TO THE BEST OF MY KNOWLEDGE AND BELIEF

Thomas Hammond
REGISTERED SURVEYOR

6335
REG. NO.