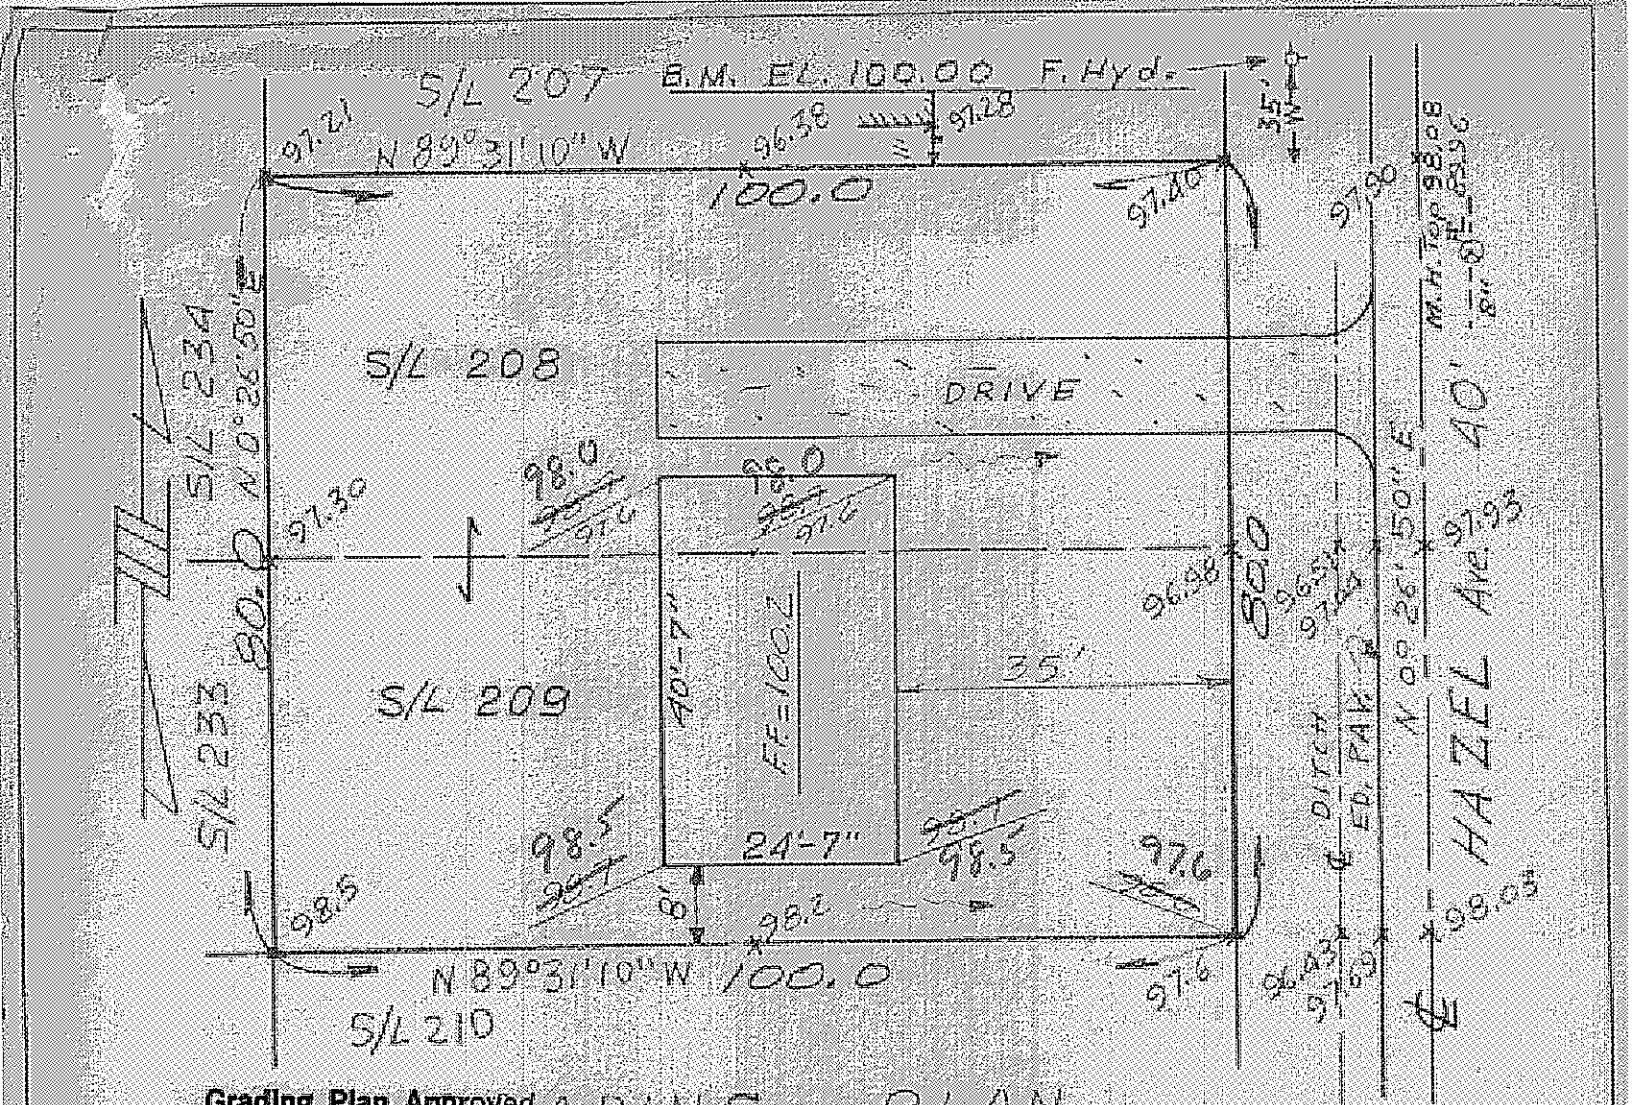

Grading Plan Approved
as shown and/or noted
THOMAS P. GILLES, P.E.
Lake County Engineer

By [signature] Date 17 Aug 72

GRADING PLAN
FOR
GINGER CONSTR. CO.
S/L 208 & 209 MADISON GOLF LAKELAND
MADISON TWP. - LAKE COUNTY, OHIO
SCALE: 1" = 20' JUNE 1972

APPROVED
MADISON TWP. ZONING
Permit: 8595
Zoning Inspector: OKB

AS BUILT CERTIFICATION

I HEREBY CERTIFY THAT THE CIRCLED GRADES ARE EXISTING FINSH — GRADES CHECKED IN THE FIELD ON _____ 197__ SURVEY IS CORRECTED TO THE BEST OF MY KNOWLEDGE AND BELIEF.

FULLERTON - KERR & ASSOC.

by _____
REG. SURVEYOR N.

1446