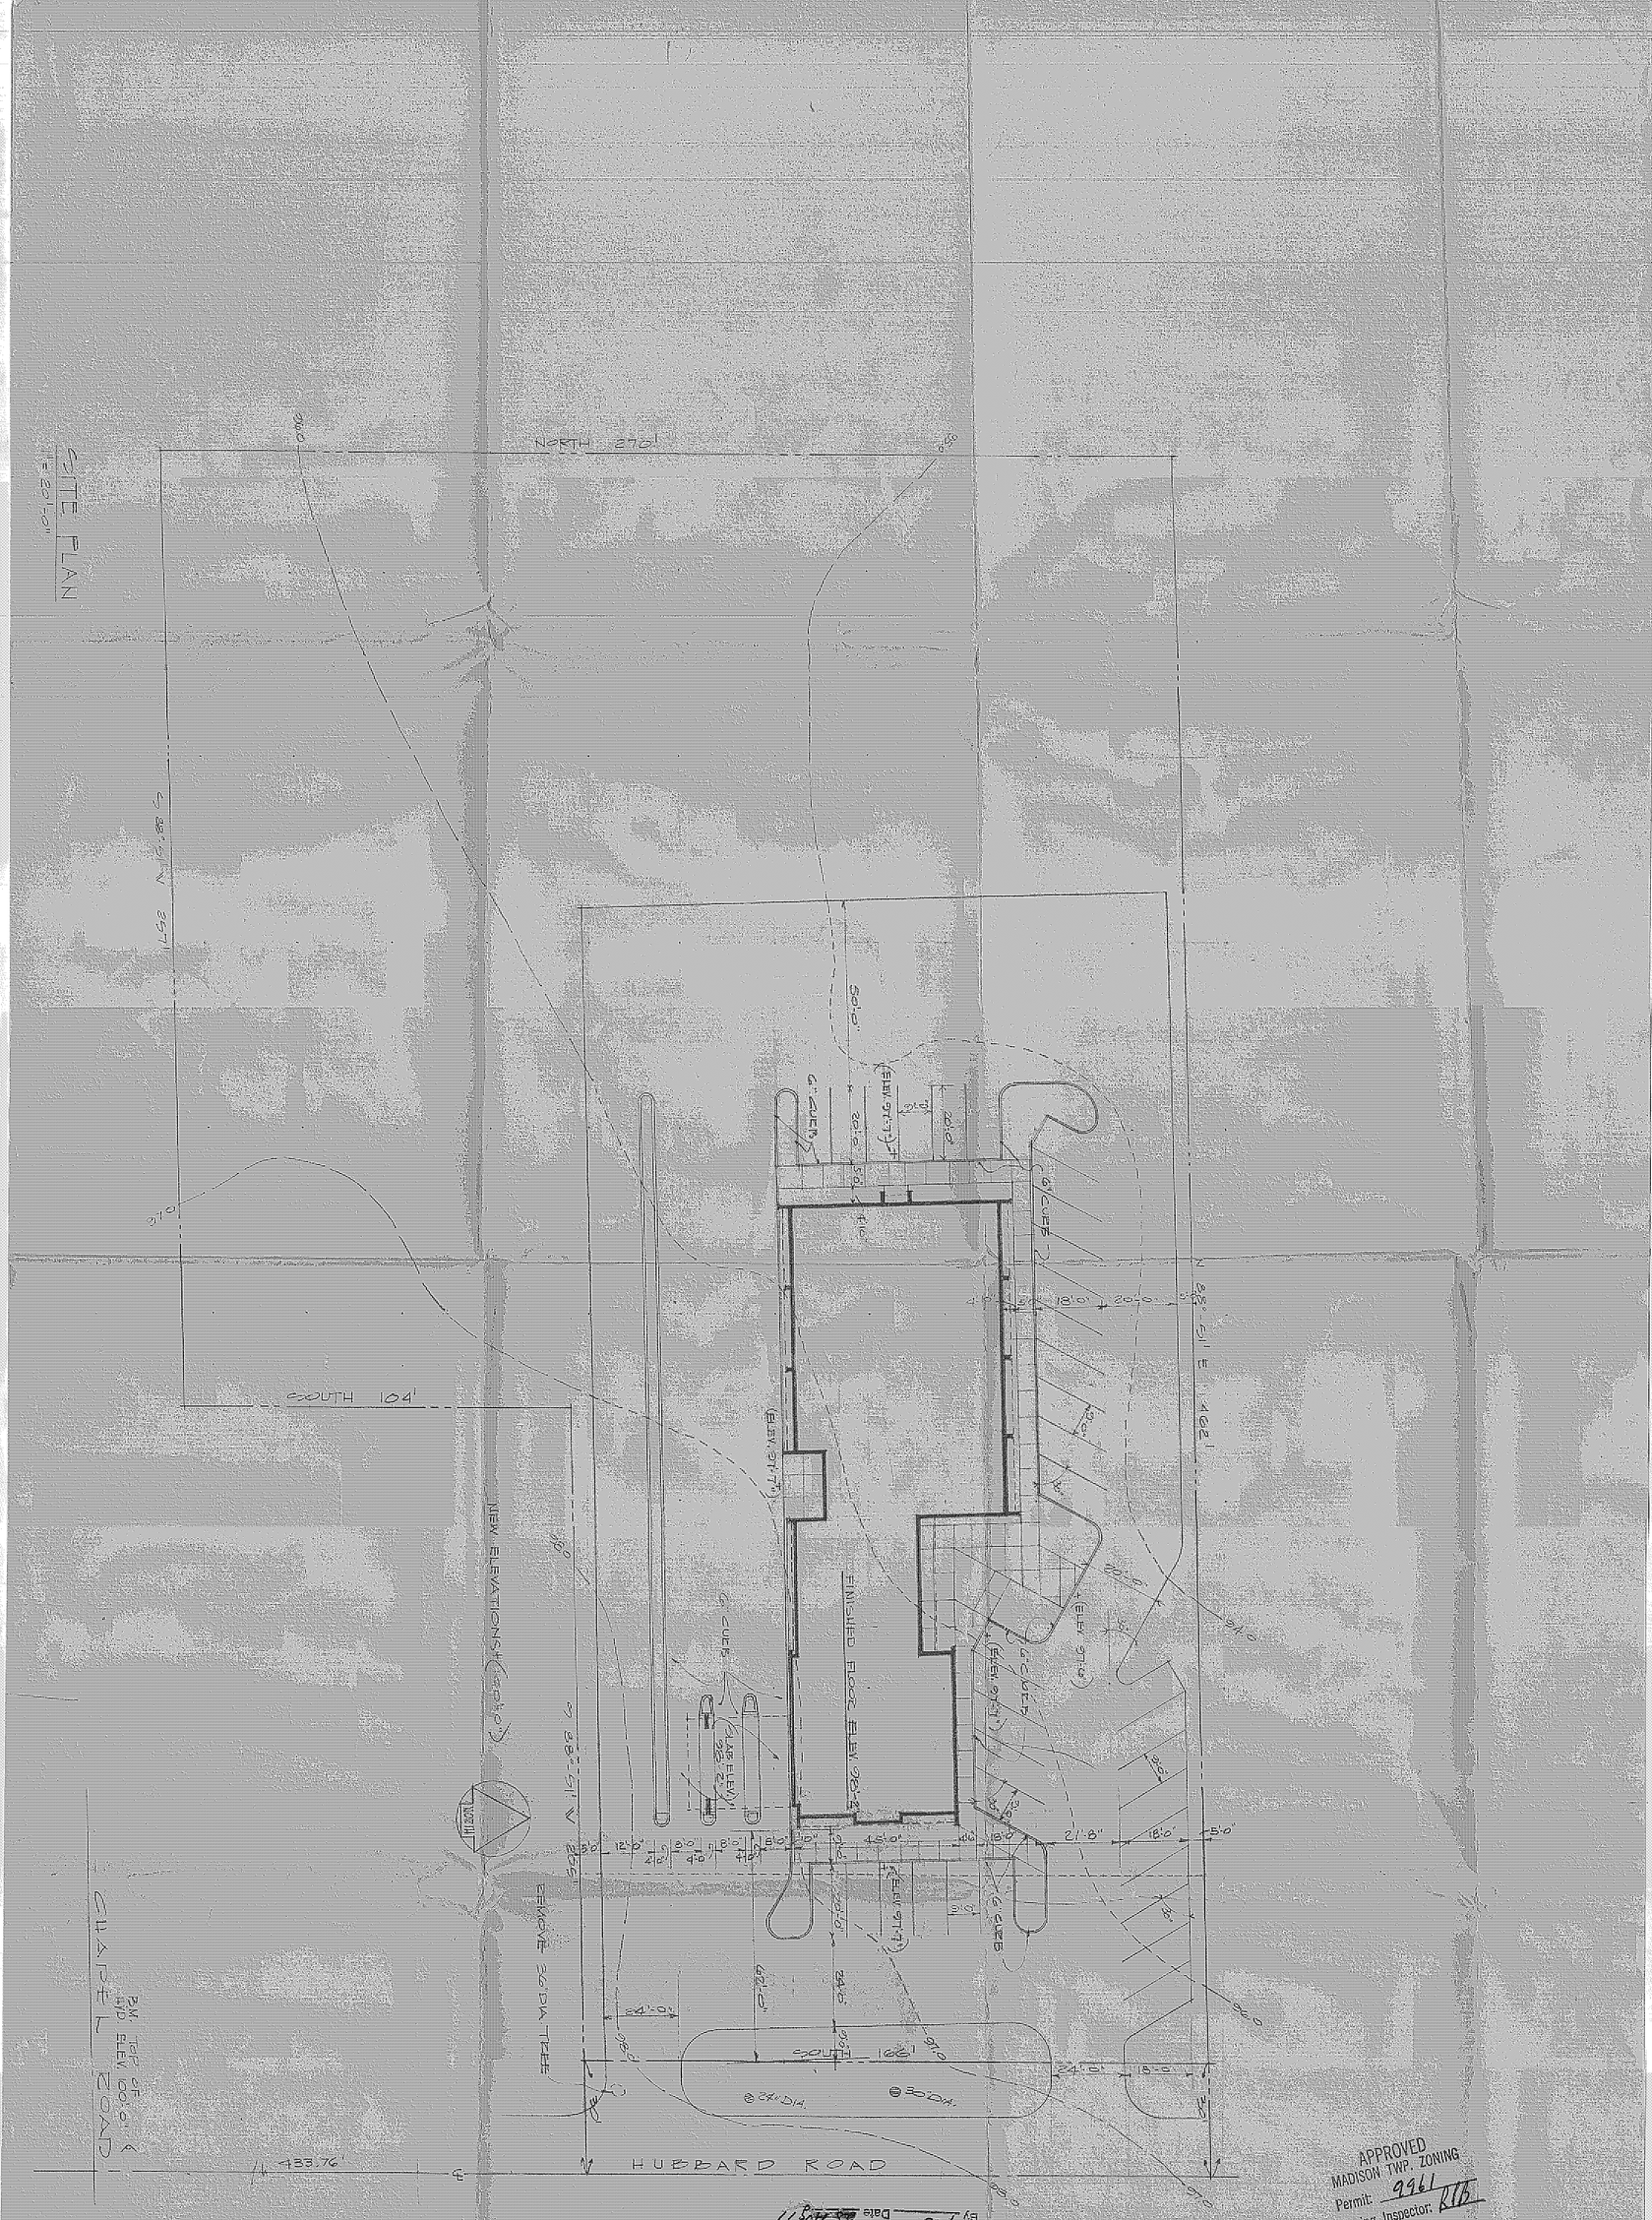

Grading Plan Approved
as shown and/or noted
THOMAS P. GILLES, P.E.
Lake County Engineer
By TJG Date 05 Aug 77

Surveyor
FRANK J. TURO
S-005279

APPROVED
MADISON TWP. ZONING
Permit: 9961
Zoning Inspector: RTB

SHEET No.	SCALE: 1"=20'-0"	DATE:
A-1	JOB No.: 7709	REV.
	DRN. BY: HR	
	CHKD. BY: JFK	

SITE PLAN

Bank & Commercial Building
HUBBARD ROAD NORTH MADISON, OHIO

RICE & STEWART ARCHITECTS
111 NORTH ST. CLAIR STREET PAINESVILLE, OHIO 44077