Grading Plan Approved
as shown and/or noted
THOMAS P. GILLES, P.E.
Lake County Engineer
By _____ Date 5-13-86

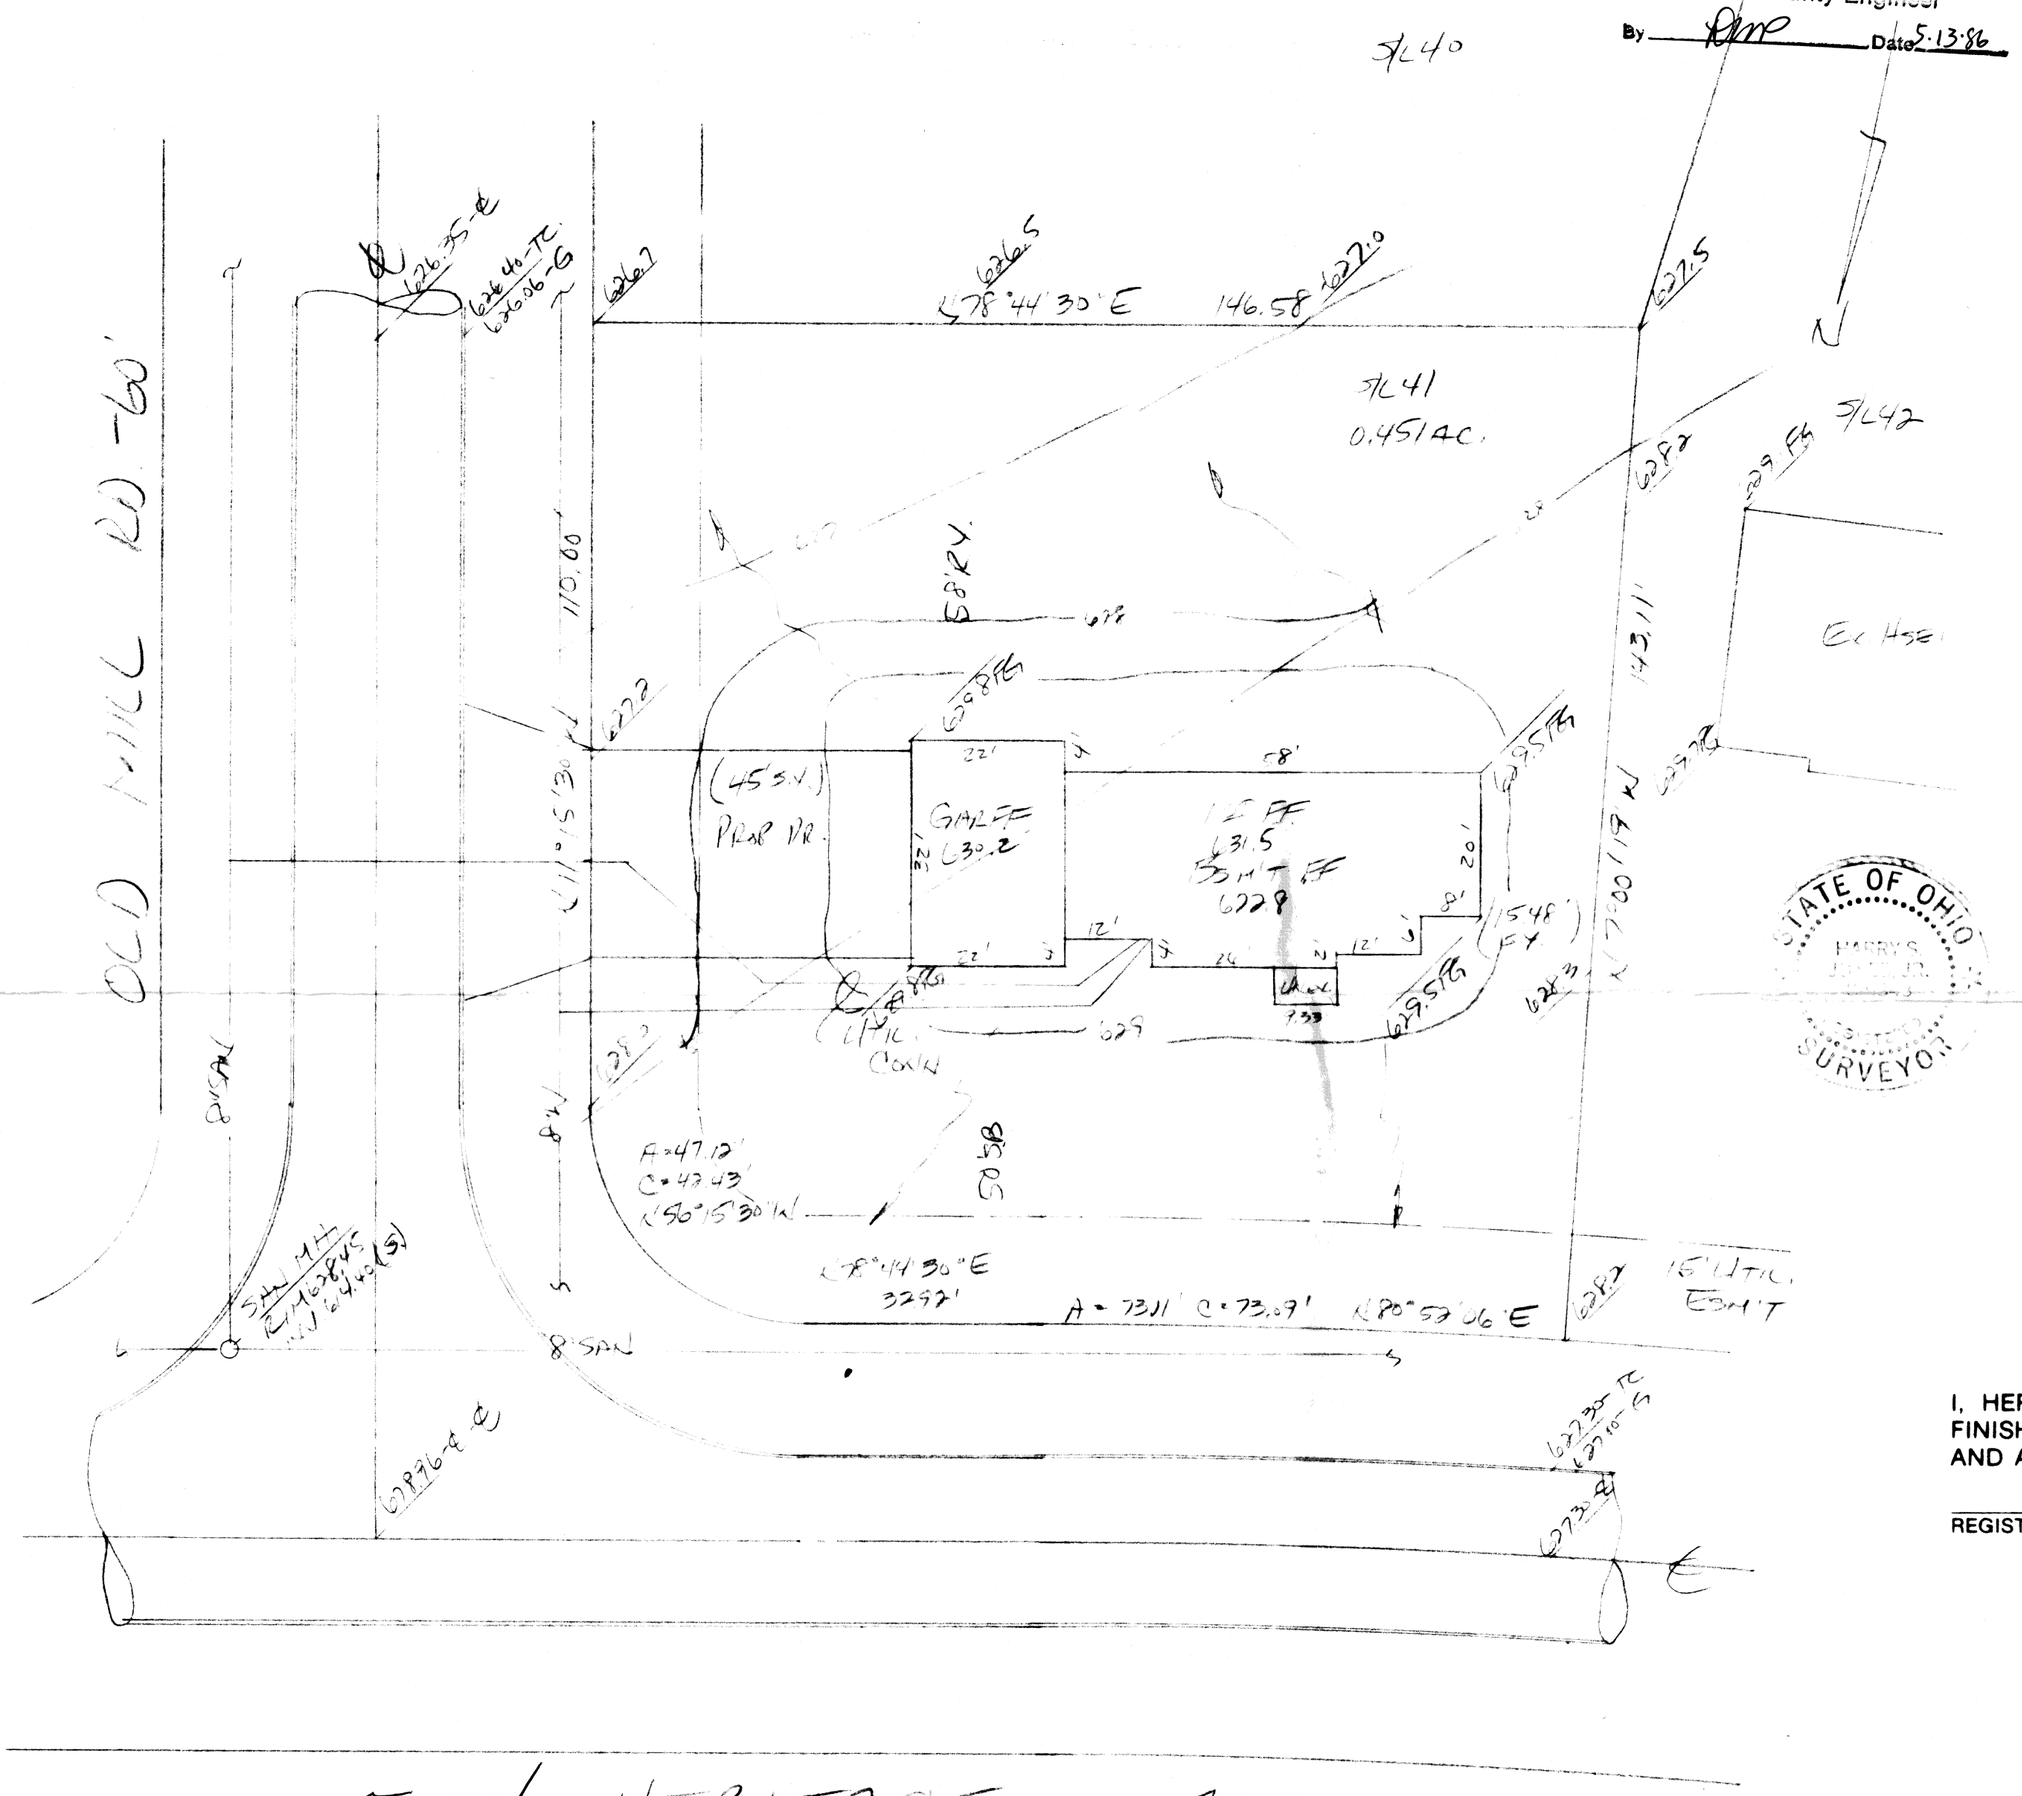


5734 HERITAGE AVE. - 60'

# SITE PLAN

MADISON LAKE COUNTY, OHIO
TOWNSHIP

for: RAY ZIRKLE
CLIENT OWNER

5865 SHORE DR. MADISON
ADDRESS STREET CITY ZIP

| | | | |
|---|---|---|---|
| RAY ZIRKLE SUB. | | LOT | TRACT |
| SUBDIVISION | NAME | | |
| V-3 | VOL. - PG. | VOLUME | PAGE |
| 41 | HERITAGE AVE | PERM. PARCEL NO. | STREET |
| SUBLOT NO. | STREET | | |

## LEGEND

SANITARY MANHOLE
STORM MANHOLE
INLET OR CATCH BASIN
HYDRANT
EXISTING CONTOURS
PROPOSED CONTOURS
EXIST. ELEV. 100.0 / 100.0 PROP. ELEV.
WATER VALVE (GAS)
WATER METER (GAS)
AS BUILT ELEVATION 100.0
INDICATES DIRECTION OF SURFACE DRAINAGE

## REMARKS

ALL BOUNDARY DATA SHOWN WAS OBTAINED FROM (DEEDS, RECORDED SUBDIVISION PLAT OR OTHER PUBLIC RECORDS)

LOCATIONS AS SHOWN OF ADJACENT WELLS AND SEPTIC TANKS OBTAINED FROM LAKE COUNTY HEALTH DEPARTMENT

## DESIGN CERTIFICATION

THIS PLAT WAS PREPARED BY ME, AND IS CORRECT TO THE BEST OF MY KNOWLEDGE AND BELIEF.

NAME SURVEYOR REGISTRATION NO. 6363

## CHECK LIST

NO. OF BEDROOMS
DIMENSIONS
BEARINGS
TIE TO NEAREST STREET
SUBLOT NO. PARCEL NO.
SURROUNDING OWNERS
BLDG. DIMENSIONS FIN. GR.
BLDG. TIES FL'R. GRADES
APRON TYPE WIDTH THICKNESS
SIDEWALK TYPE WIDTH THICKNESS
CULVERT TYPE DIA., LENGTH
ROCK OUTCROPPINGS
WATER MAIN SIZE, LOCATION
SAN. SEWER SIZE % GR. LOC.
SAN. MH. CAST. ELEV. INV. ELEV.
SAN. CONN. SIZE, LOC. DEPTH
STORM SEWER SIZE % GR. LOC.
STORM MH. CAST ELEV. INV. ELEV.
PAV'T TYPE GRADE CURBS
GAS LINE LOC. SIZE PRESSURE
SEPTIC TANK LOCATION & DUPLICATION AREA
WELL LOCATION
ISOLATION RADIUS FROM WELL

| REVISIONS | | | | | |
|---|---|---|---|---|---|
| NO. | DATE | BY | PLAN PREPARED BY: BABCOCK • JONES & ASSOCIATES, INC. PAINESVILLE, OHIO | | |
| 1 | | | | | |
| 2 | | | | | |
| 3 | | | DRAWN BY | SCALE 1" = 20' | PHONE NO. 357-1811 |
| 4 | | | CHK'D. | DATE 5/2/86 | DRAWING NO. |
| 5 | | | CREW CHIEF | APP'D. | 86-086 |

## "AS BUILT" CERTIFICATION

I, HEREBY CERTIFY THAT THE CIRCLED GRADES ARE EXISTING FINISH GRADES CHECKED IN THE FIELD ON _____, 19____ AND ARE CORRECT TO THE BEST OF MY KNOWLEDGE AND BELIEF.

REGISTERED SURVEYOR REG. NO.

TBM - RIM SAN. MH
ELEV. = 628.45

APPROVED
MADISON TWP. ZONING
Permit: 11814
Zoning Inspector: R. Saunders