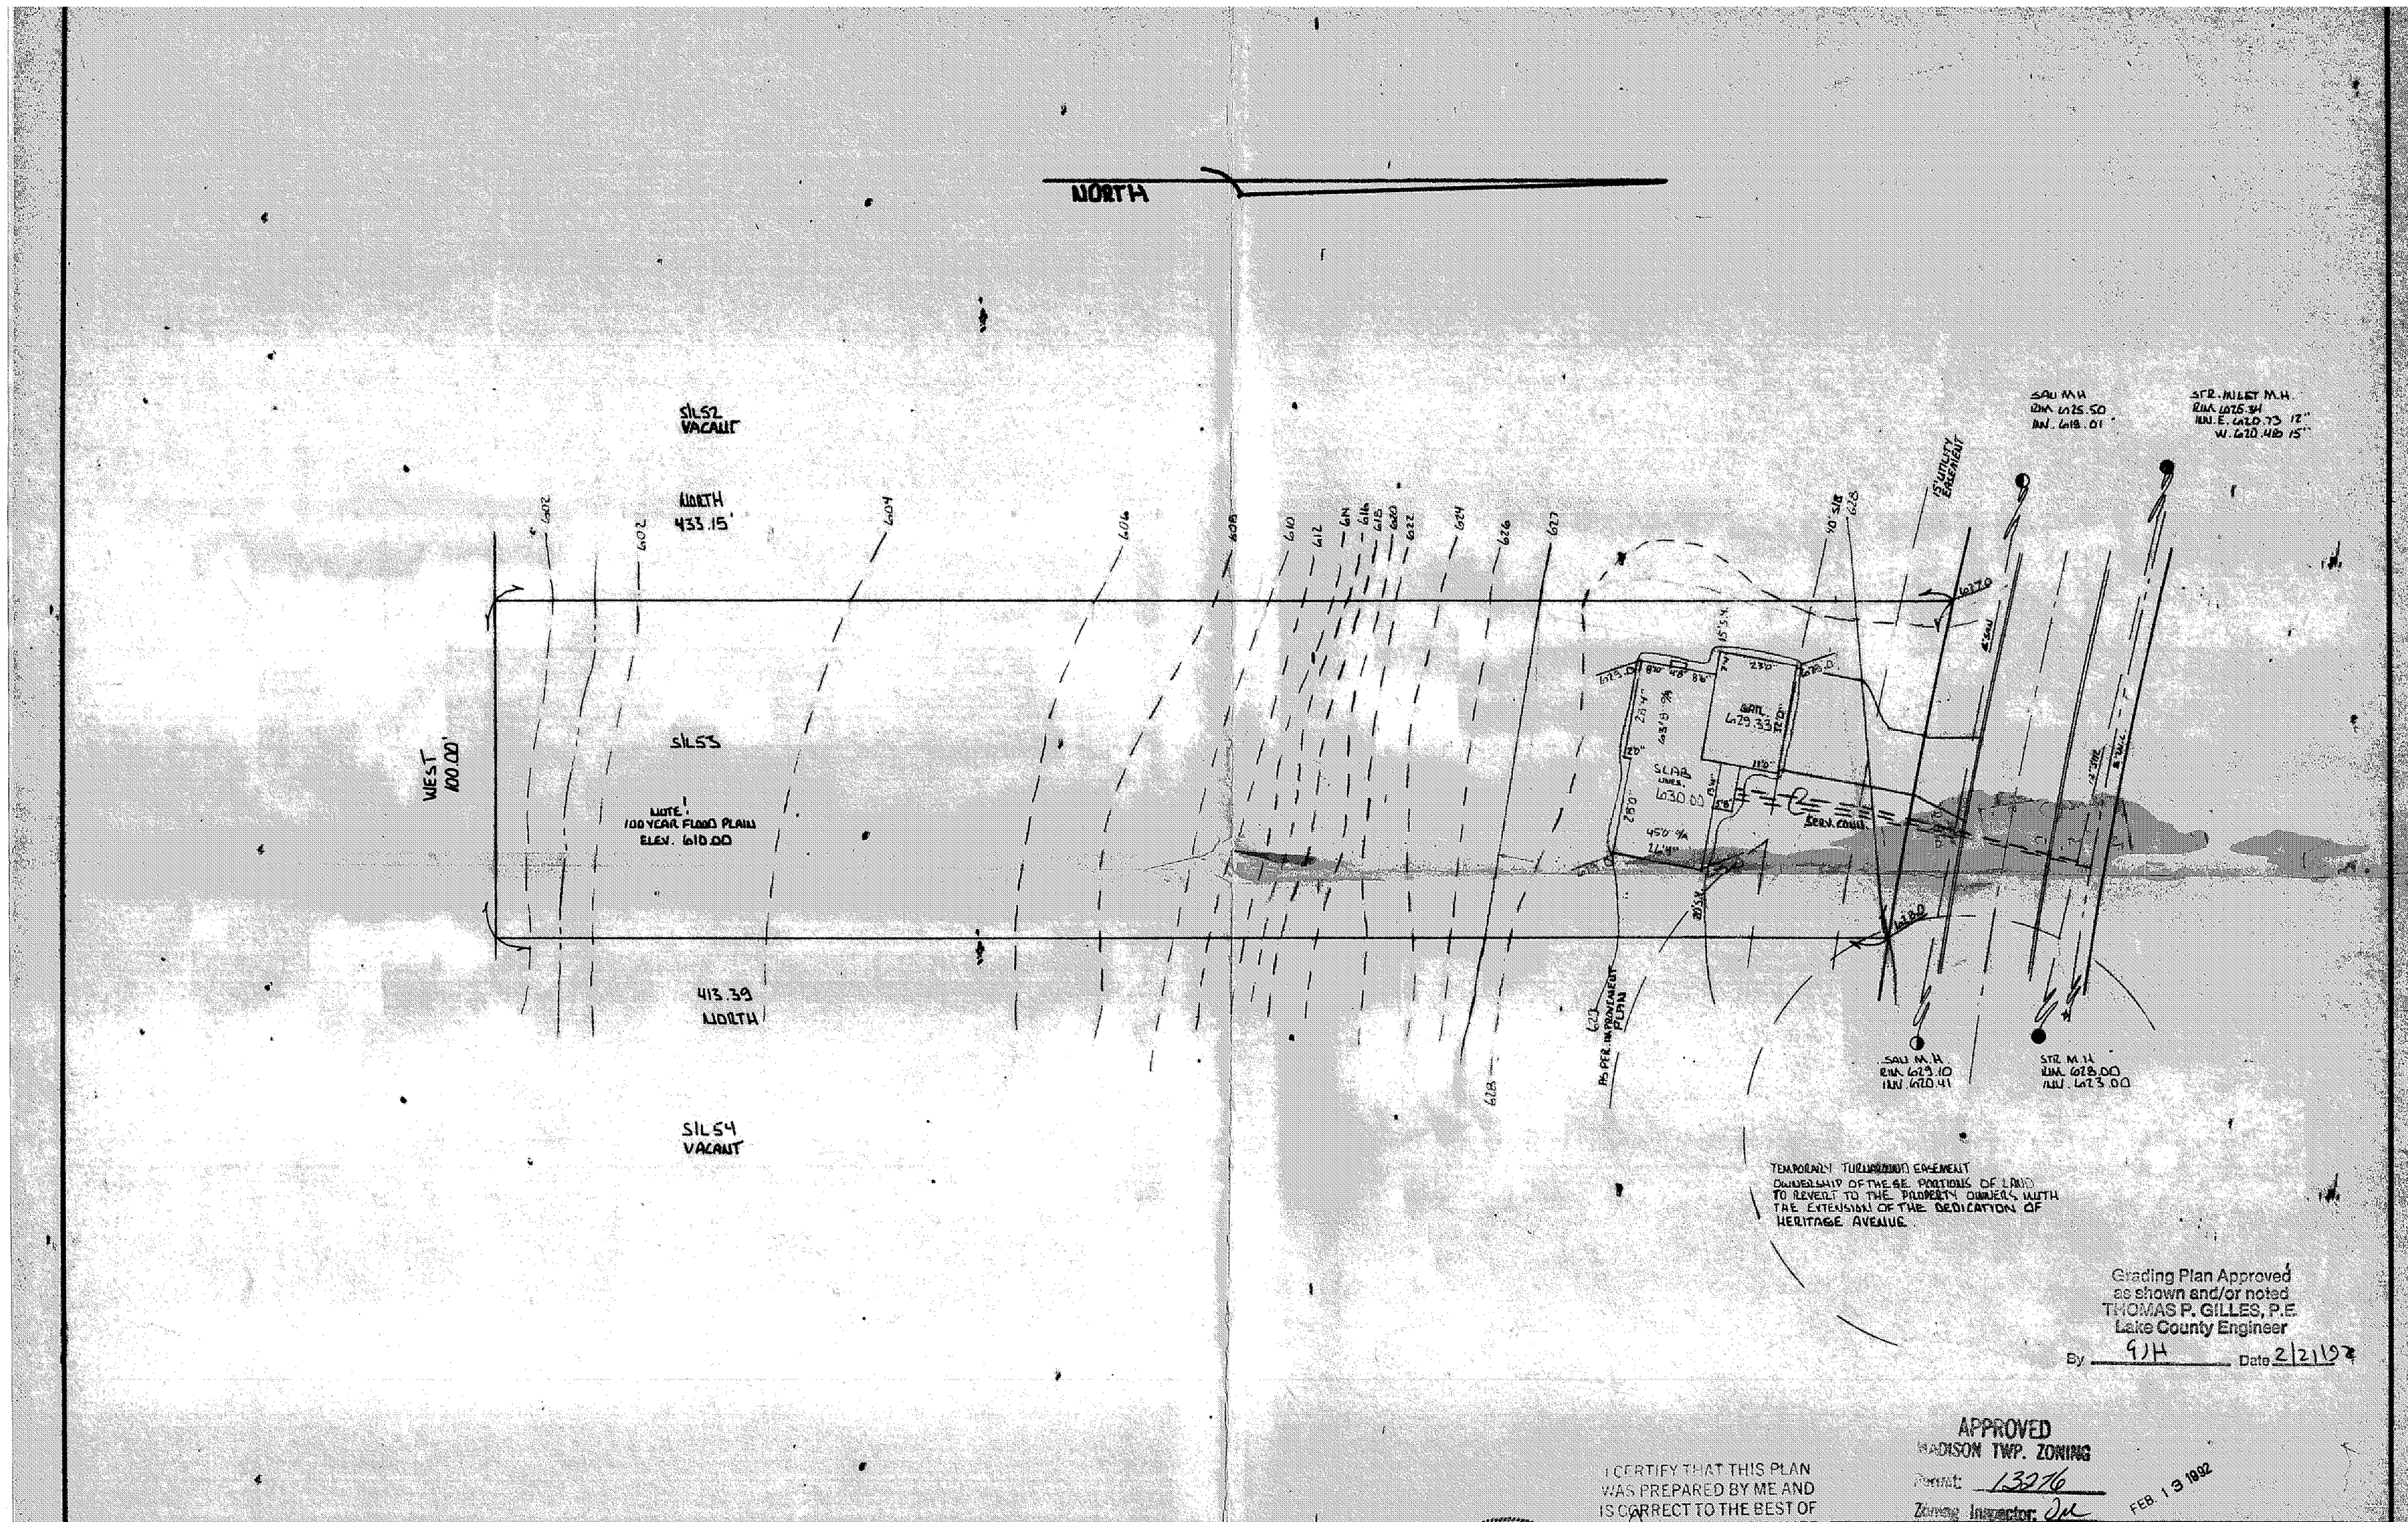

Grading Plan Approved
as shown and/or noted
THOMAS P. GILLES, P.E.
Lake County Engineer
By 9JH Date 2/21/92

APPROVED
MADISON TWP. ZONING
Permit: 13276
Zoning Inspector: JM
FEB. 13 1992

I CERTIFY THAT THIS PLAN
WAS PREPARED BY ME AND
IS CORRECT TO THE BEST OF
MY KNOWLEDGE AND BELIEF

STATE OF OHIO
JOHN
CLOUD
SKONIECZNY
S-6356
REGISTERED
SURVEYOR

REG. SURVEYOR #6356

JOHN C. SKONIECZNY
7739 VIEWMOUNT DR.
PAINESVILLE, OHIO 44077
PH. 352-7742

SITE PLAN FOR: SIMMONS HOMES

SCALE: 1" = 30'	APPROVED BY	DRAWN BY FJH
DATE: JULY 92		

BEING SUBLOT 53 IN THE HERITAGE HILL ESTATES SUBDIVISION
TOWNSHIP OF MADISON, LAKE COUNTY, OHIO

92-1347

DRAWING NUMBER 92-963