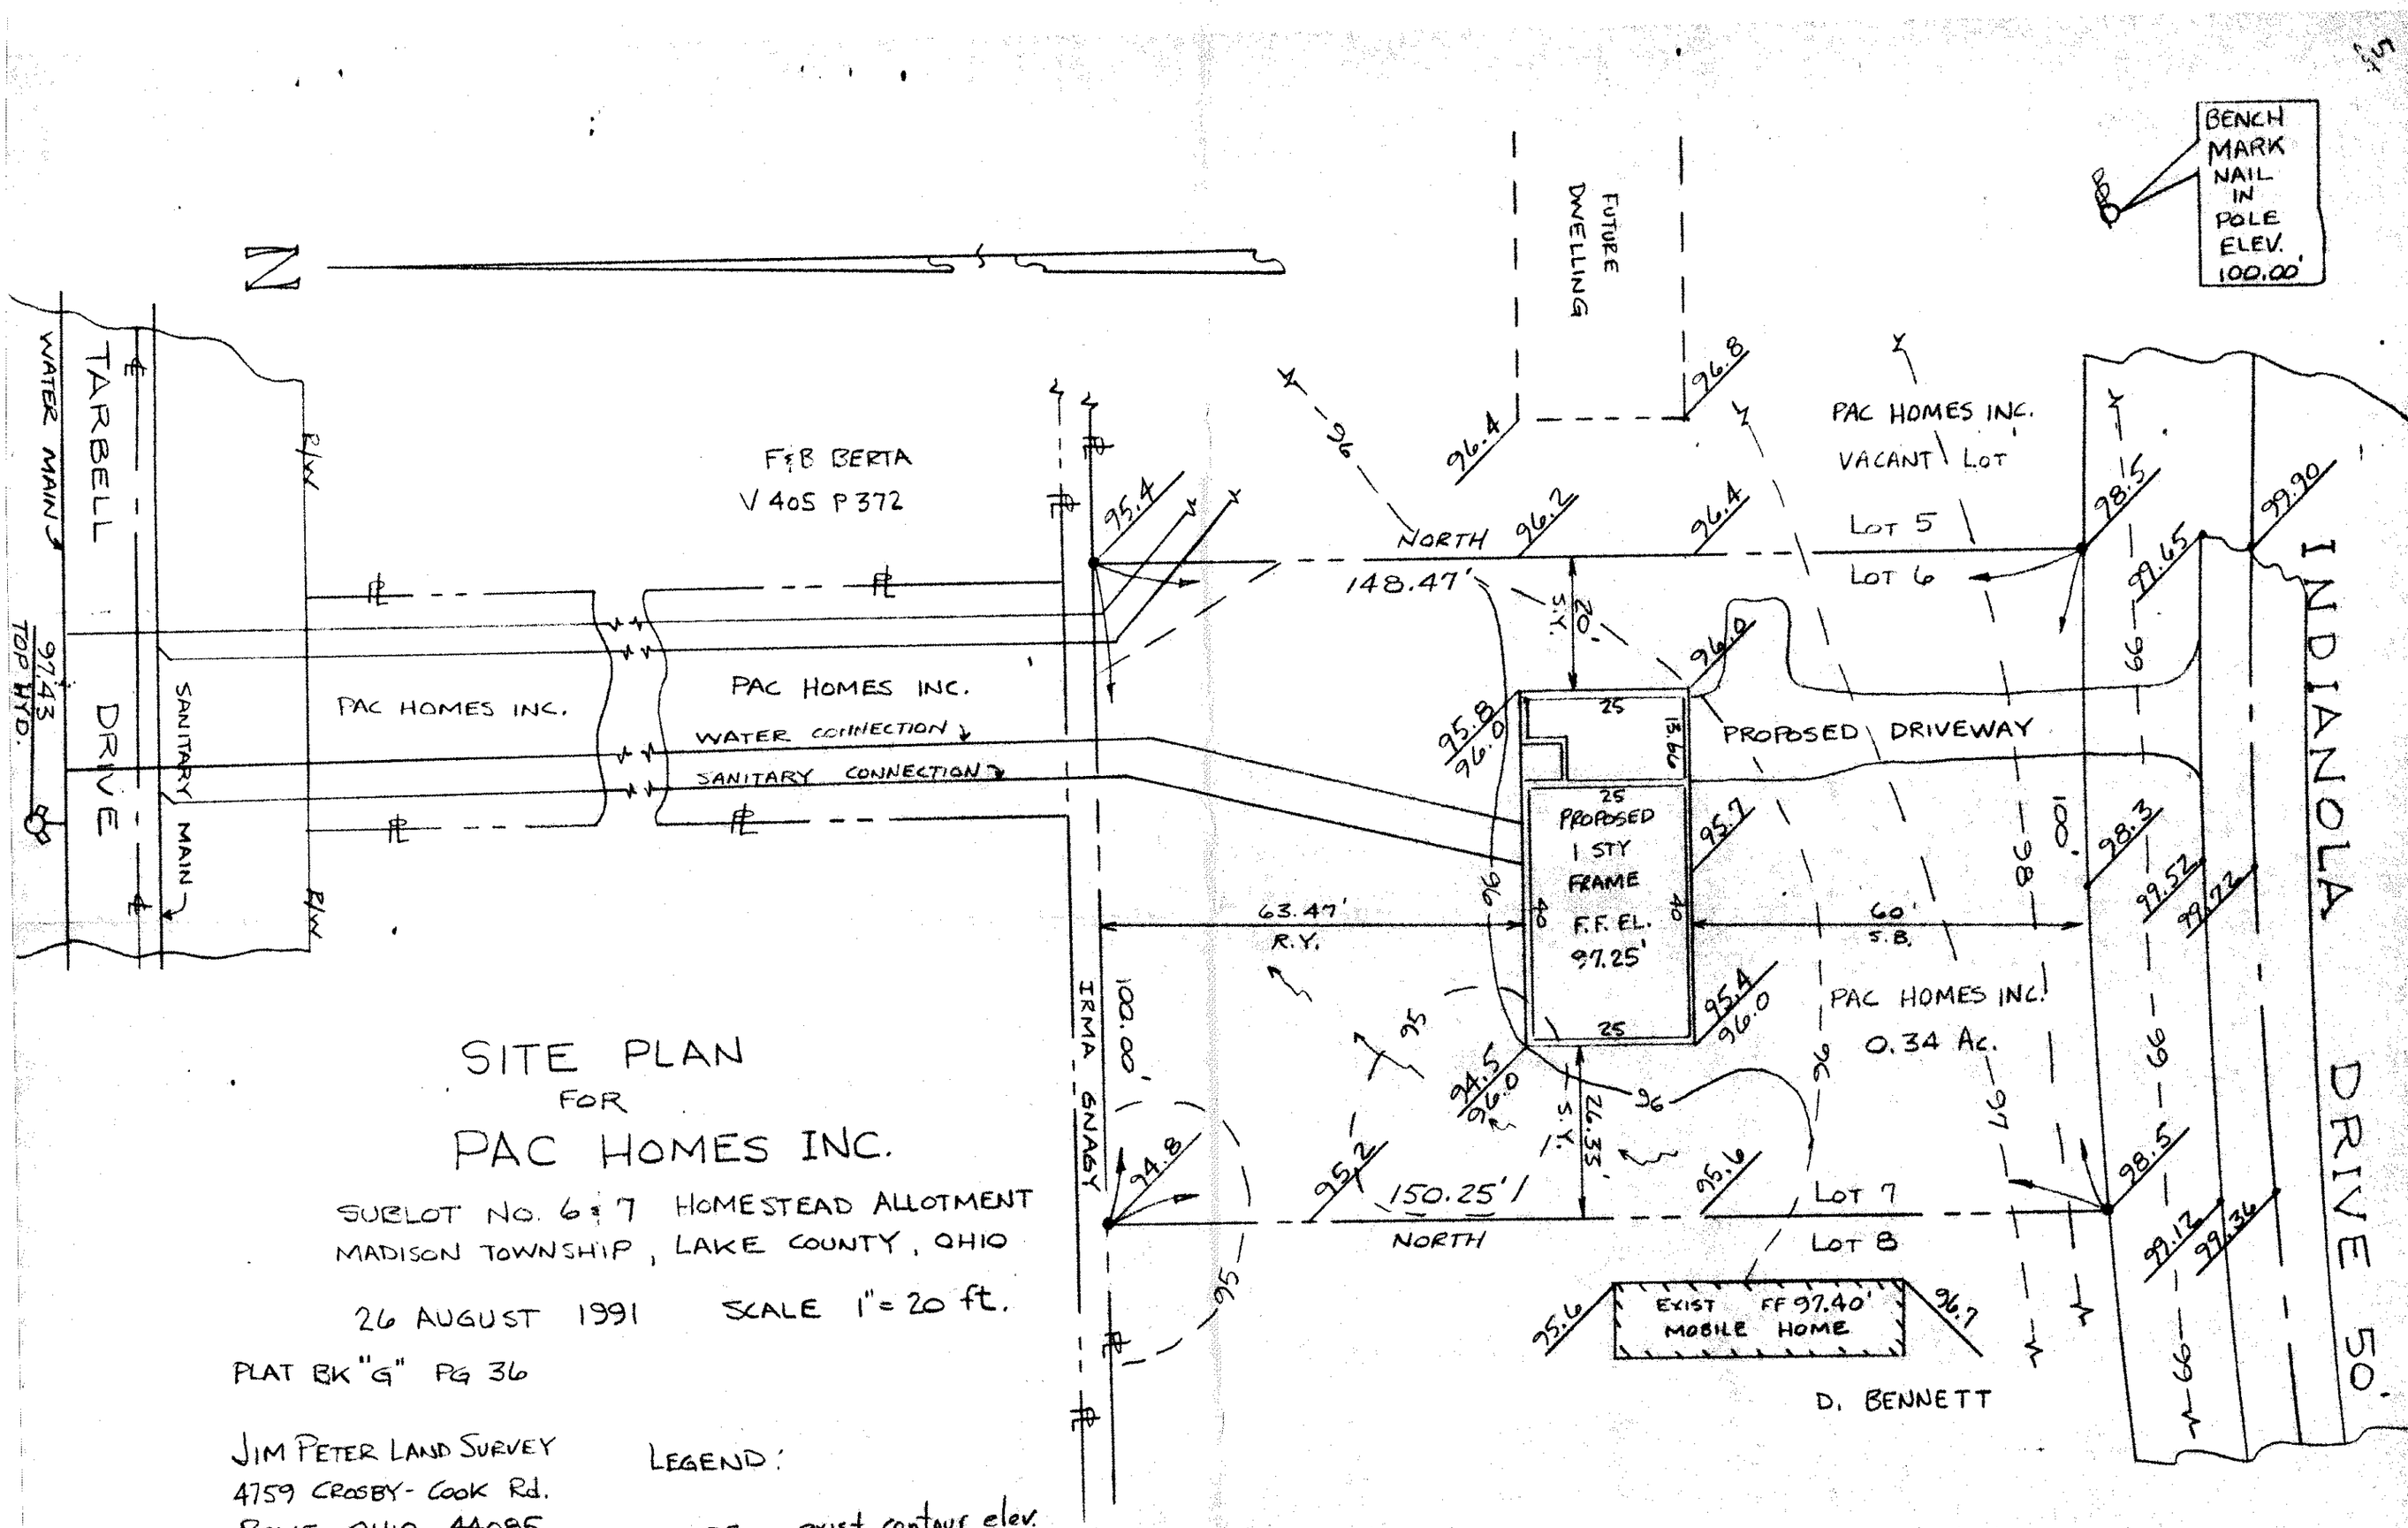

SITE PLAN
FOR
PAC HOMES INC.

SUBLOT NO. 6 & 7 HOMESTEAD ALLOTMENT
MADISON TOWNSHIP, LAKE COUNTY, OHIO

26 AUGUST 1991 SCALE 1" = 20 ft.

PLAT BK "G" PG 36

JIM PETER LAND SURVEY
4759 CROSBY-COOK Rd.
ROME, OHIO 44085

LEGEND:

--- 97 --- exist contour elev.
—98— proposed contour elev.
—ft— property line
Denotes ½" ϕ iron rebar

STATE OF OHIO JAMES PETER REGISTERED SURVEYOR

SEP. 18 1991

APPROVED
MADISON TWP. ZONING
Permit: 13183
Zoning Inspector: JK

Grading Plan Approved as shown and/or noted
THOMAS P. GILLES, P.E.
Lake County Engineer
By GH Date 9/19/91
PROVIDE POSITIVE DRAINAGE FOR REAR OF LOT.

Job # 910813