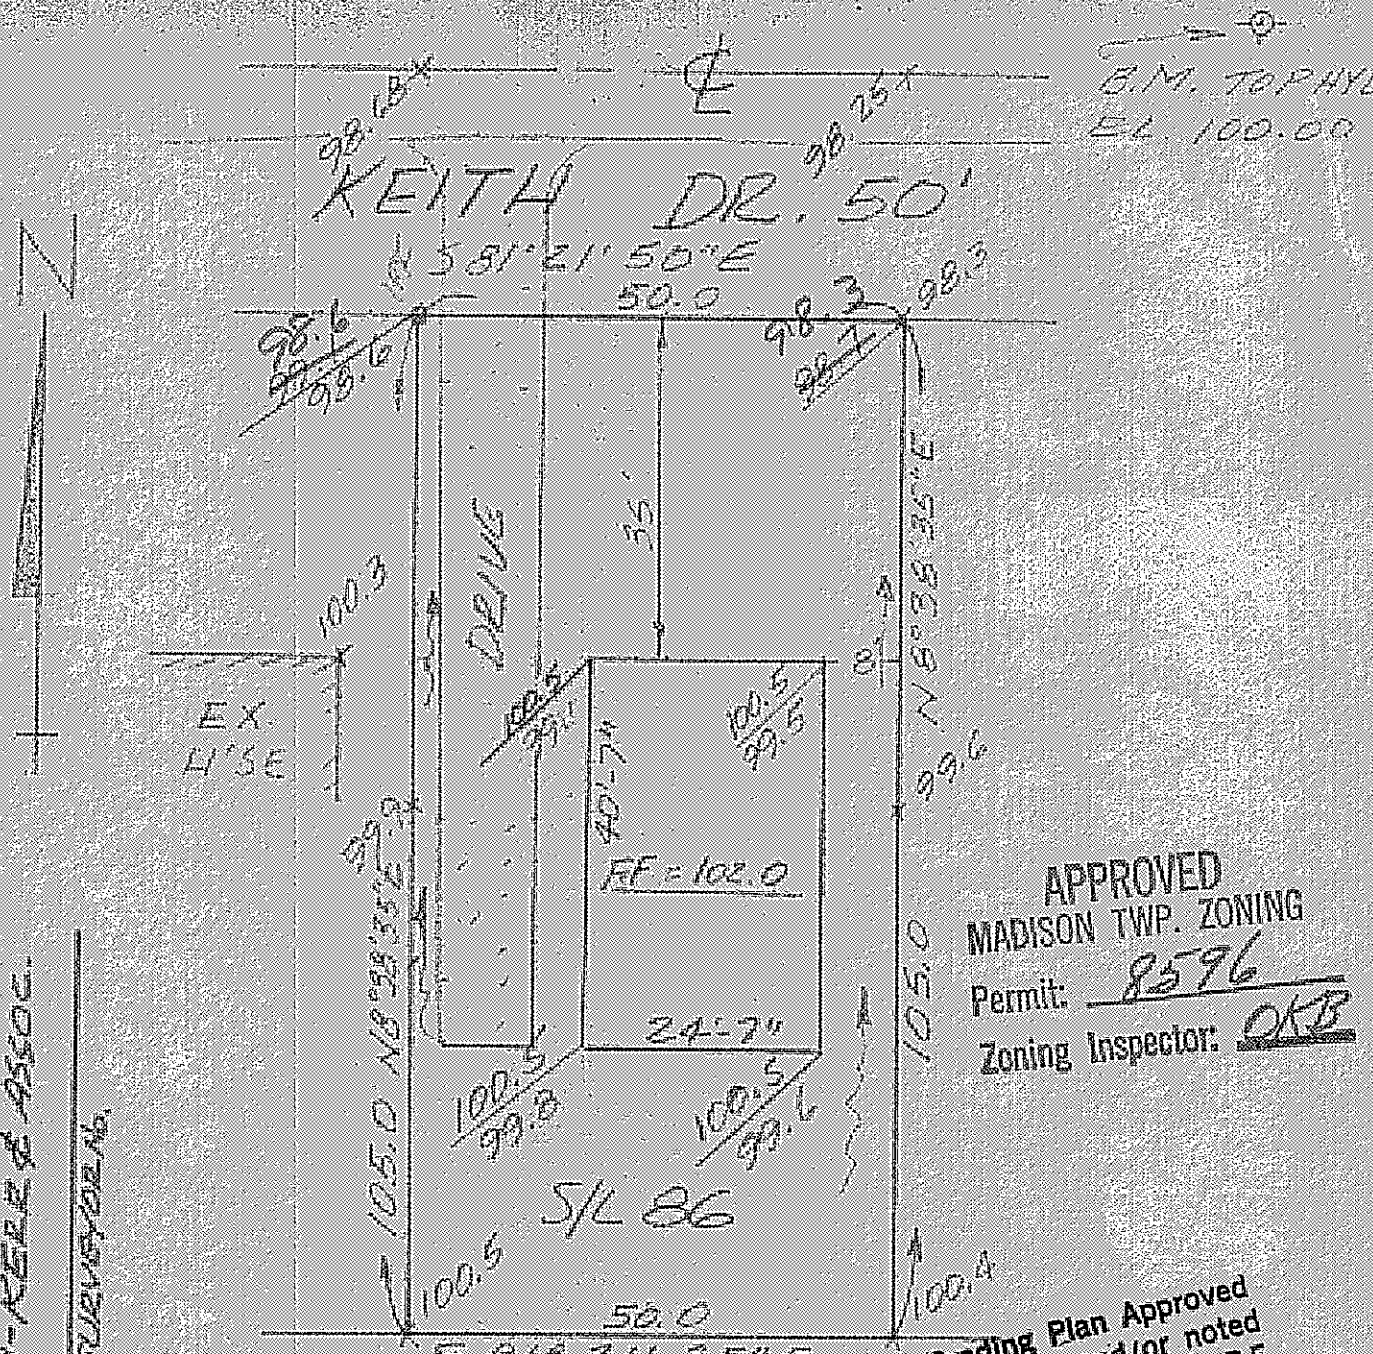

APPROVED
MADISON TWP. ZONING
Permit: 8596
Zoning Inspector: OKB

Grading Plan Approved as shown and/or noted
THOMAS P. GILLES, P.E.
Lake County Engineer
17 Aug 72

I HEREBY CERTIFY THAT THE CIRCLED GRADES ARE EXISTING FINISH GRADES CHECKED IN THE FIELD ON 1/97
SURVEY, IS CORRECT TO THE BEST OF MY KNOWLEDGE AND BELIEF
FULLERTON-KERR & ASSOC.

GRADING PLAN
OVERCONST. CO.
S/L 86 MADISON GOLF LAKELAND
MADISON TWP. — LAKE CO. OHIO
SCALE: 1" = 20' — MAY, 1972

NOTE: UNDERLINED EL. ARE FINISHED GRADE

FULLERTON-KERR AND ASSOCIATES
REGISTERED ENGINEERS AND SURVEYORS
PAINESVILLE, OHIO

5934