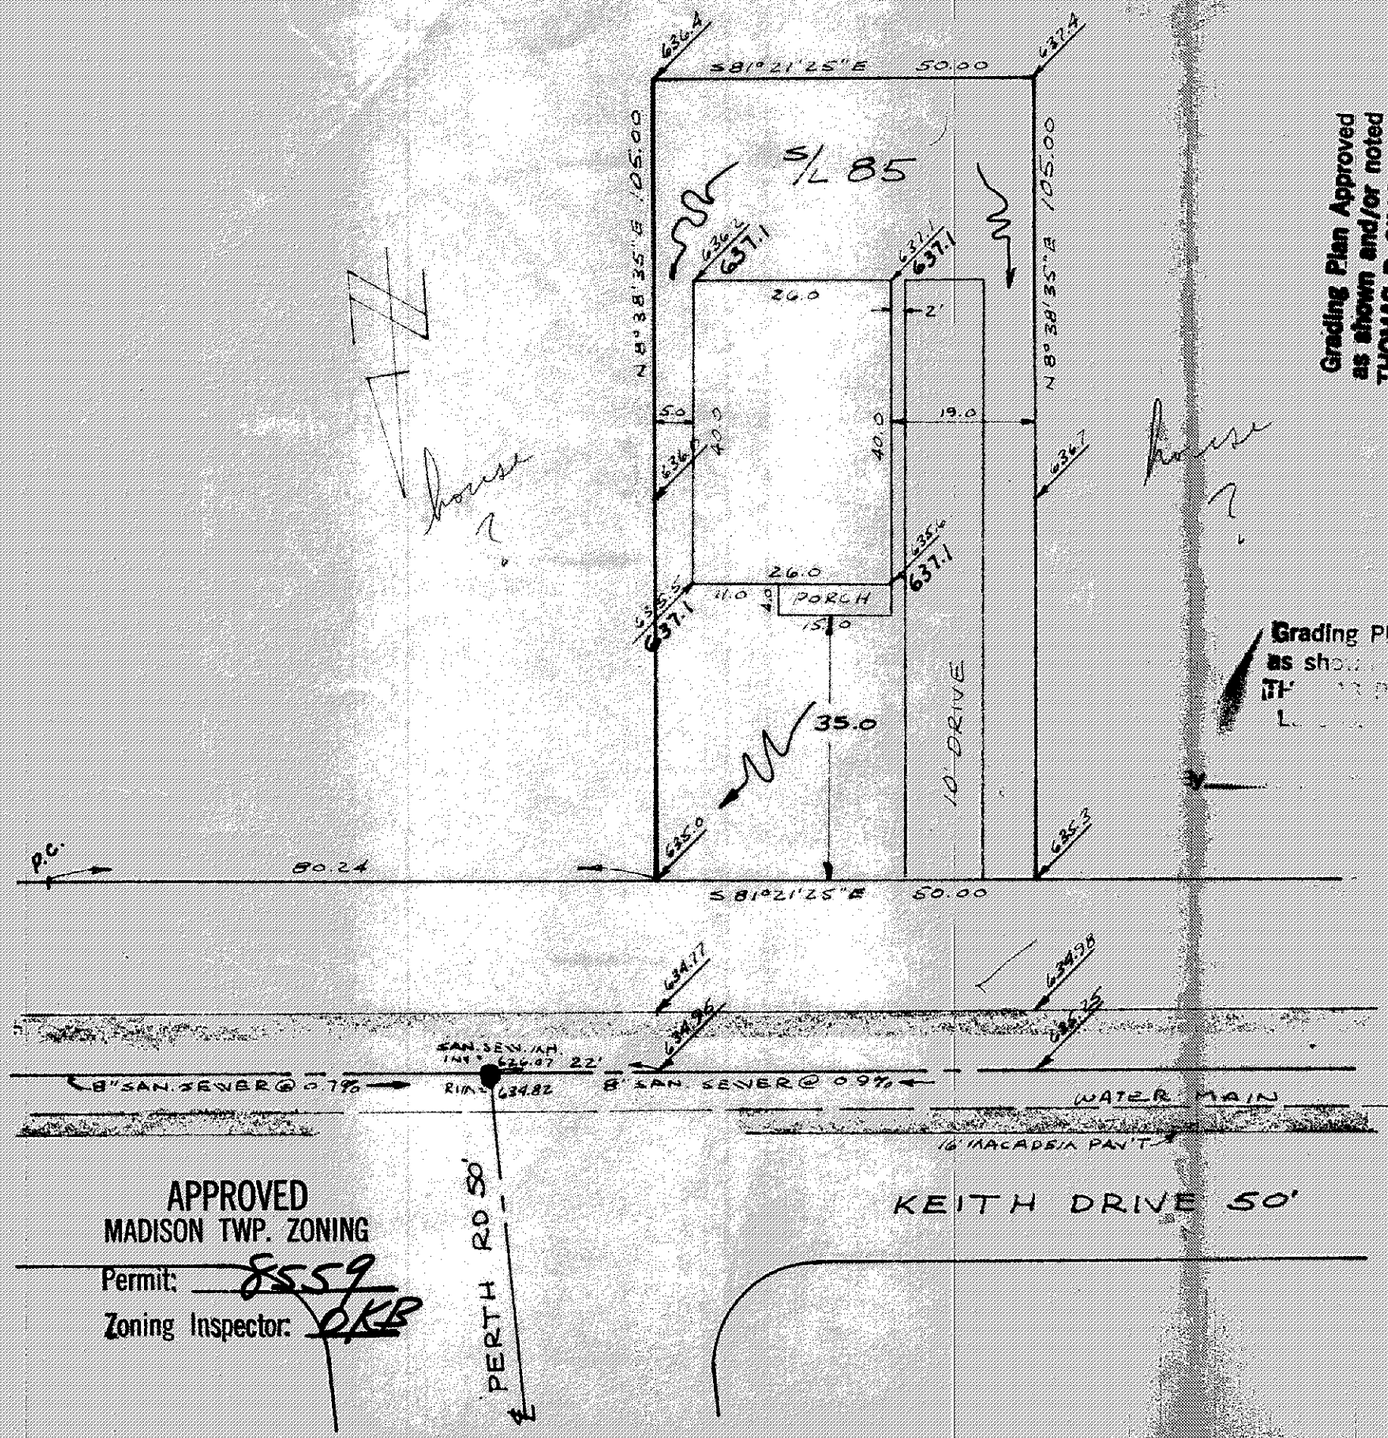

Grading Plan Approved as shown and/or noted THOMAS P. GILLES, P.E. Lake County Engineer

By [signature] Date 14 Aug 72

Grading Plan Approved as sho[illegible] noted TH[illegible], P.E. L[illegible]ineer

By _____ Date _____

APPROVED
MADISON TWP. ZONING
Permit: 8559
Zoning Inspector: OKB

SITE PLAN

MADISON (TOWNSHIP) LAKE COUNTY, OHIO

for: RYAN HOMES (CLIENT / OWNER)

5940 Keith Dr. Madison 44057
ADDRESS STREET CITY ZIP

MADISON GOLF LAKELAND RECORD SUBDIVISION	LOT / TRACT
E VOLUME / 68 PAGE	VOLUME / PAGE
85 SUBLOT NO. / KEITH DR. STREET	PERM. PARCEL # / STREET

LEGEND

SANITARY MANHOLE
STORM MANHOLE
INLET OR CATCH BASIN
HYDRANT
EXISTING CONTOURS
PROPOSED CONTOURS
EXIST. ELEV. 100.0 / 100.0 PROP. ELEV.

WATER VALVE (GAS)
WATER METER (GAS)
AS BUILT ELEVATION
DIRECTION OF SURFACE DRAINAGE

REMARKS

ALL BOUNDARY DATA SHOWN WAS OBTAINED FROM (DEEDS, RECORDED SUBDIVISION PLAT, OR OTHER PUBLIC RECORDS)

DESIGN CERTIFICATION

THIS PLAT WAS PREPARED BY ME, AND IS CORRECT TO THE BEST OF MY KNOWLEDGE AND BELIEF.

Richard R. Hegfield P.S. #5506
NAME SURVEYOR REGISTRATION NO.

CHECK LIST

DIMENSIONS
BEARINGS
TIE TO NEAREST STREET
SUBLOT NO. PARCEL NO.
SURROUNDING OWNERS
BLDG DIMENSIONS FIN. GR.
BLDG TIES FLR GRADES
APRON: TYPE WIDTH THICKNESS
SIDEWALK TYPE WIDTH THICKNESS
CULVERT TYPE DIA LENGTH

WATER MAIN: SIZE LOCATION
SAN. SEWER: SIZE % GR. LOC.
SAN. M.H. CAST ELEV. INV. ELEV.
SAN. CONN: SIZE LOC. DEPTH
STORM SEWER: SIZE % GR. LOC.
STORM MH. CAST ELEV. INV. ELEV.
PAVT. TYPE GRADE CURBS
GAS LINE: LOC. SIZE PRESSURE
SEPTIC TANK: SIZE LOC.
WELL: LOCATION

RIVISIONS		
NO	DATE	BY
1		
2		
3		
4		
5		

PLAN PREPARED BY:

DEBEVEC-SALO & ASSOC, INC.
CIVIL ENGINEERS - SURVEYORS NAME
130 E. JACKSON ST. PAINESVILLE, O.
ADDRESS

DRAWN BY SWAGTZ	SCALE 1" = 20'	PHONE NO.
CHK'D R.H.	DATE 6-20-72	DRAWING NO. 3528
CREW CHIEF	APP'D	