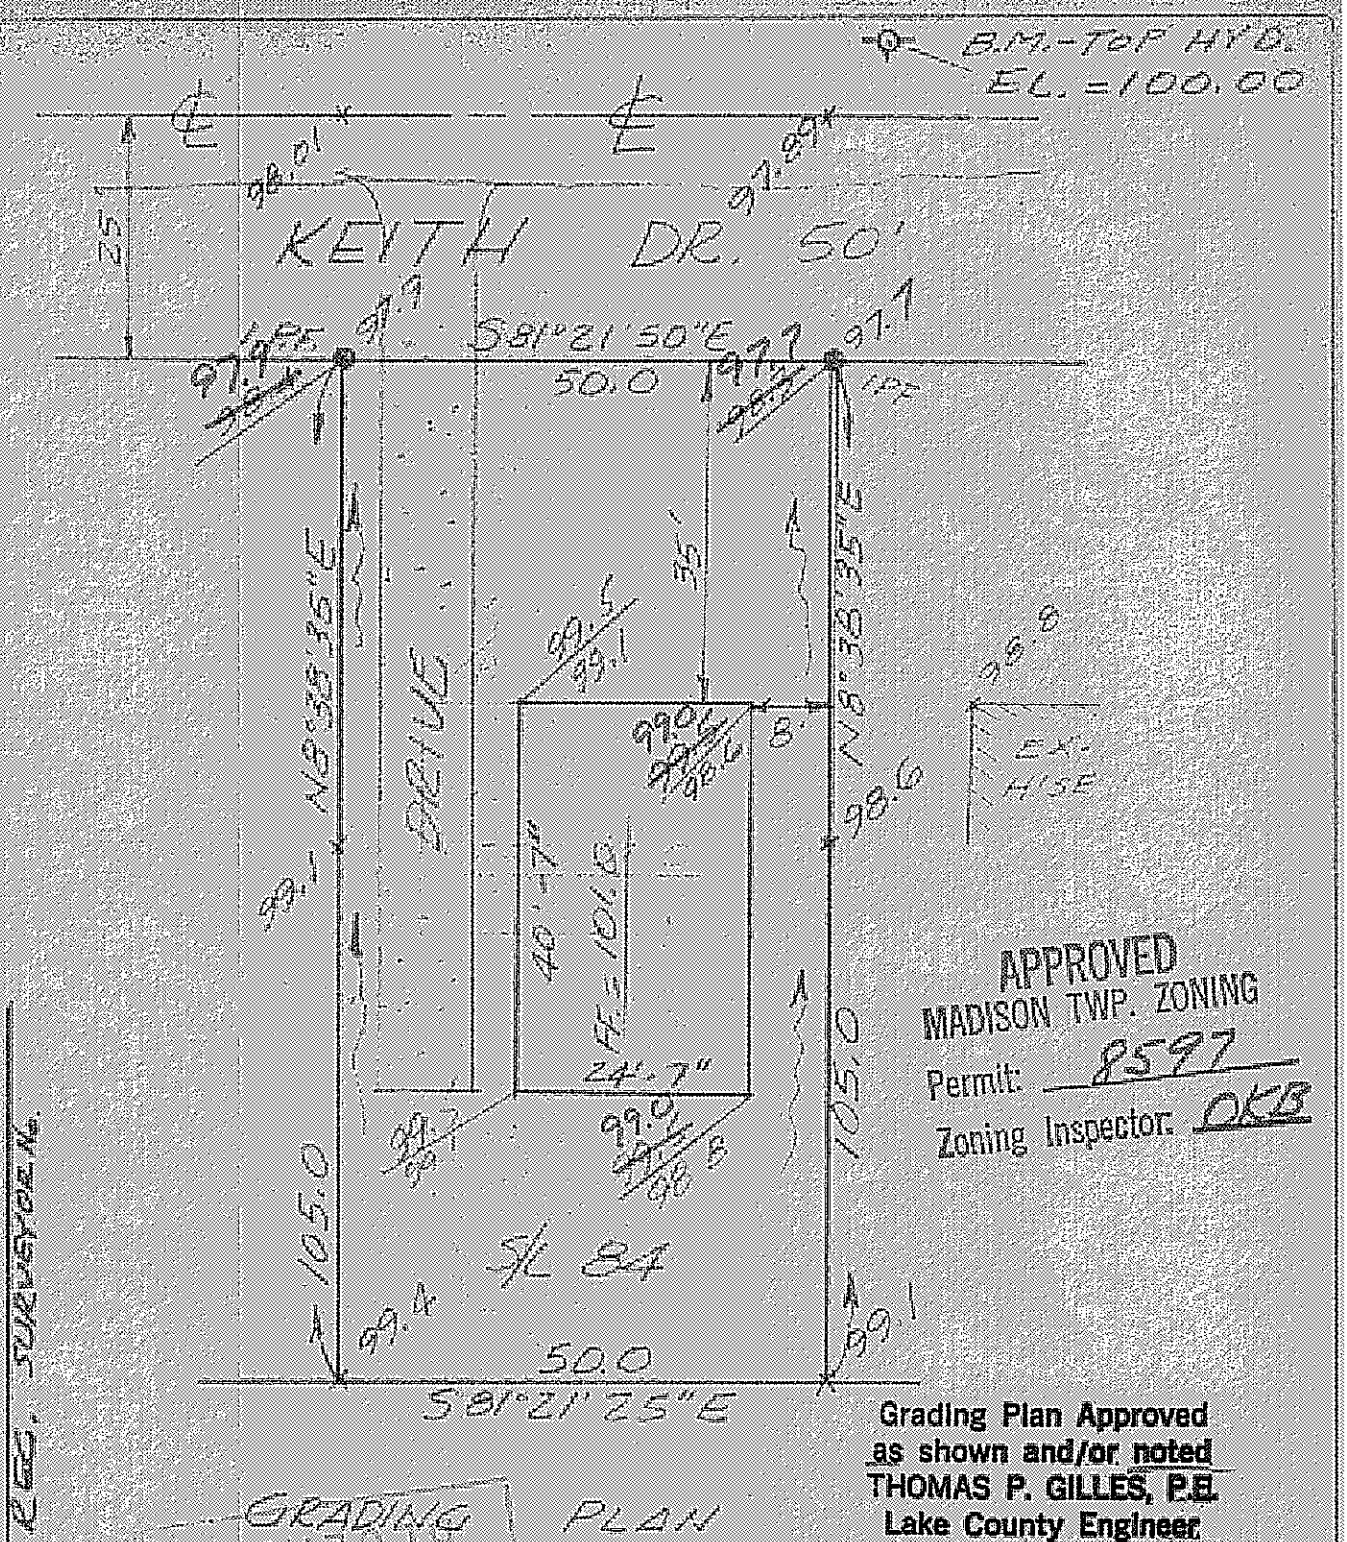

APPROVED
MADISON TWP. ZONING
Permit: 8597
Zoning Inspector: OKB

Grading Plan Approved
as shown and/or noted
THOMAS P. GILLES, P.E.
Lake County Engineer
By _____ Date 17 May 72

FULLERTON-KERR AND ASSOCIATES
REGISTERED ENGINEERS AND SURVEYORS
PAINESVILLE, OHIO

5944