TOPOGRAPHY & IMPROVEMENT PLAN FOR NORTHERN INDUSTRIES

MADISON TOWNSHIP ÷ LAKE COUNTY ÷ OHIO

SUBLOT 499 AND THE EAST 1/2 OF SUBLOT 500 IN THE MADISON GOLF LAKELANDS SUB VOL. E PAGE 68
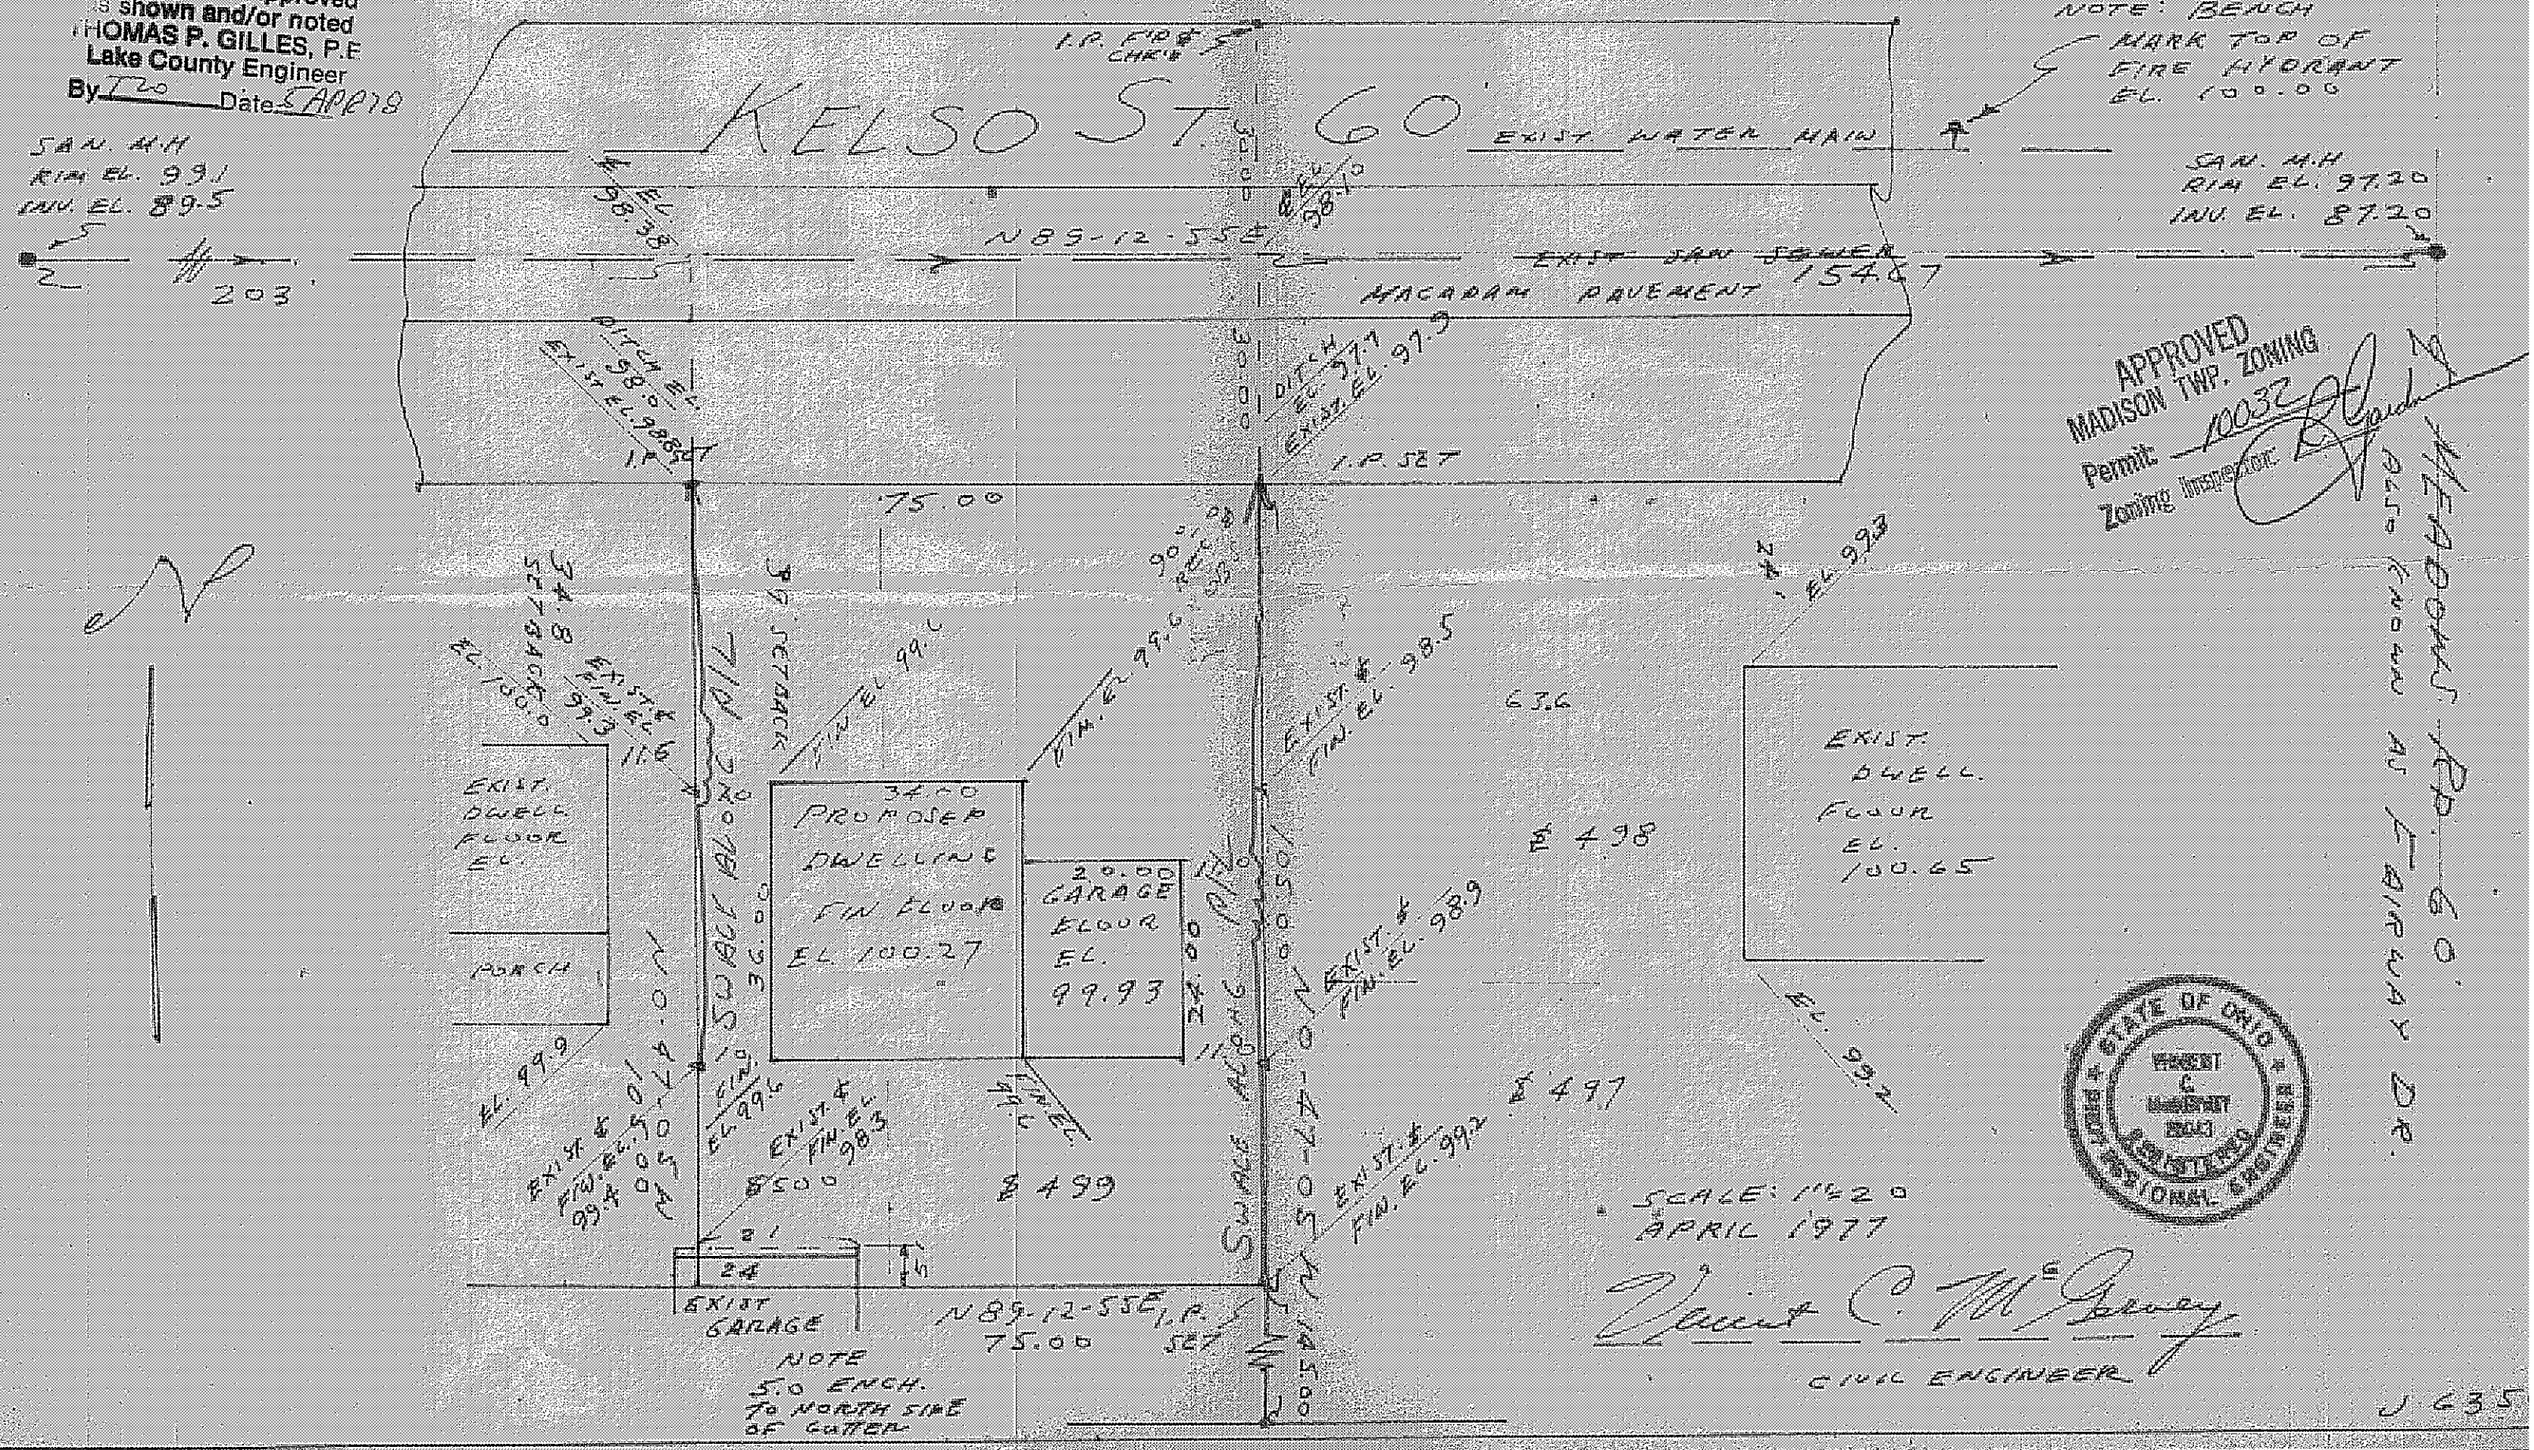
Grading Plan Approved as shown and/or noted
THOMAS P. GILLES, P.E
Lake County Engineer
By TLO Date 5 APR 78