APPROVED
MADISON TWP. ZONING
Permit: 8602
Zoning Inspector: DKS

LAKE SHORE BLVD.

B.M. - NAIL IN POLE EL. 100.00

GRADING PLAN
FOR
GINGER CONSTR. CO.
S/L 975 CUMMINGS BEACH PARK
MADISON TWP. - LAKE COUNTY, OHIO
SCALE: 1" = 30' MAY, 1972

AS BUILT CERTIFICATION
I HEREBY CERTIFY THAT THE CIRCLED GRADES ARE EXISTING FINISH.
GRADES CHECKED IN THE FIELD ON _____
197___ SURVEY IS CORRECT TO THE BEST OF MY KNOWLEDGE AND BELIEF.
FULLERTON-KEER & ASSOC.
BY _____
REG. SURVEYOR No.

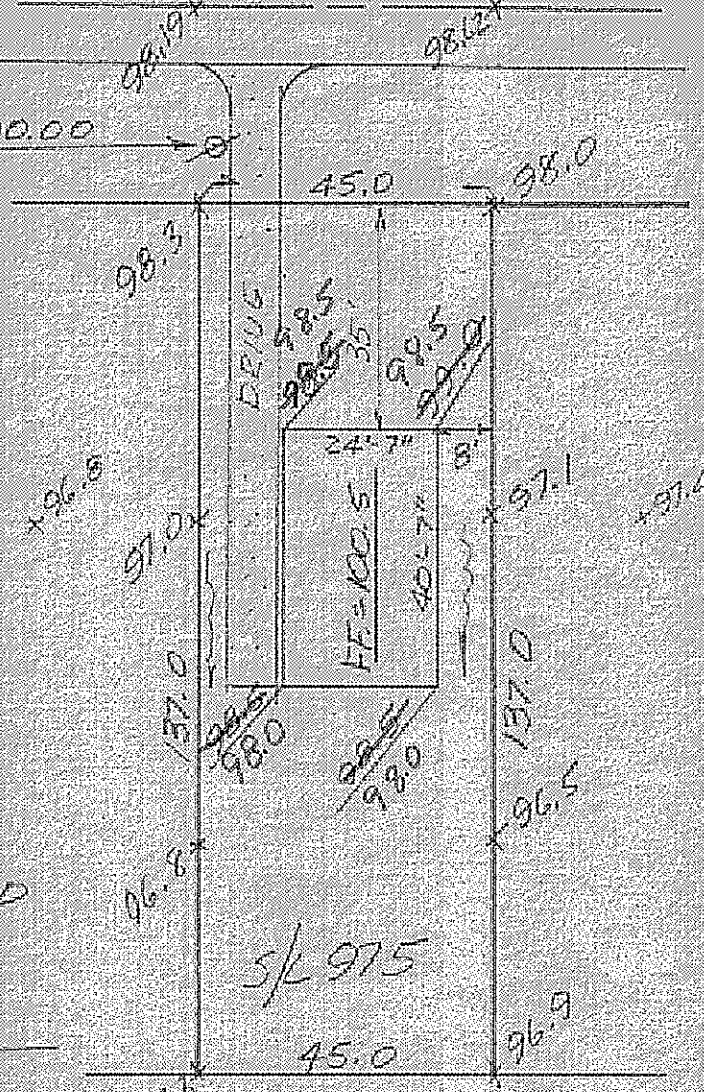

Grading Plan Approved
as shown and/or noted
THOMAS P. GILLES, P.E.
Lake County Engineer
By _____ Date 21 Aug 72

6848 LAKE RD.