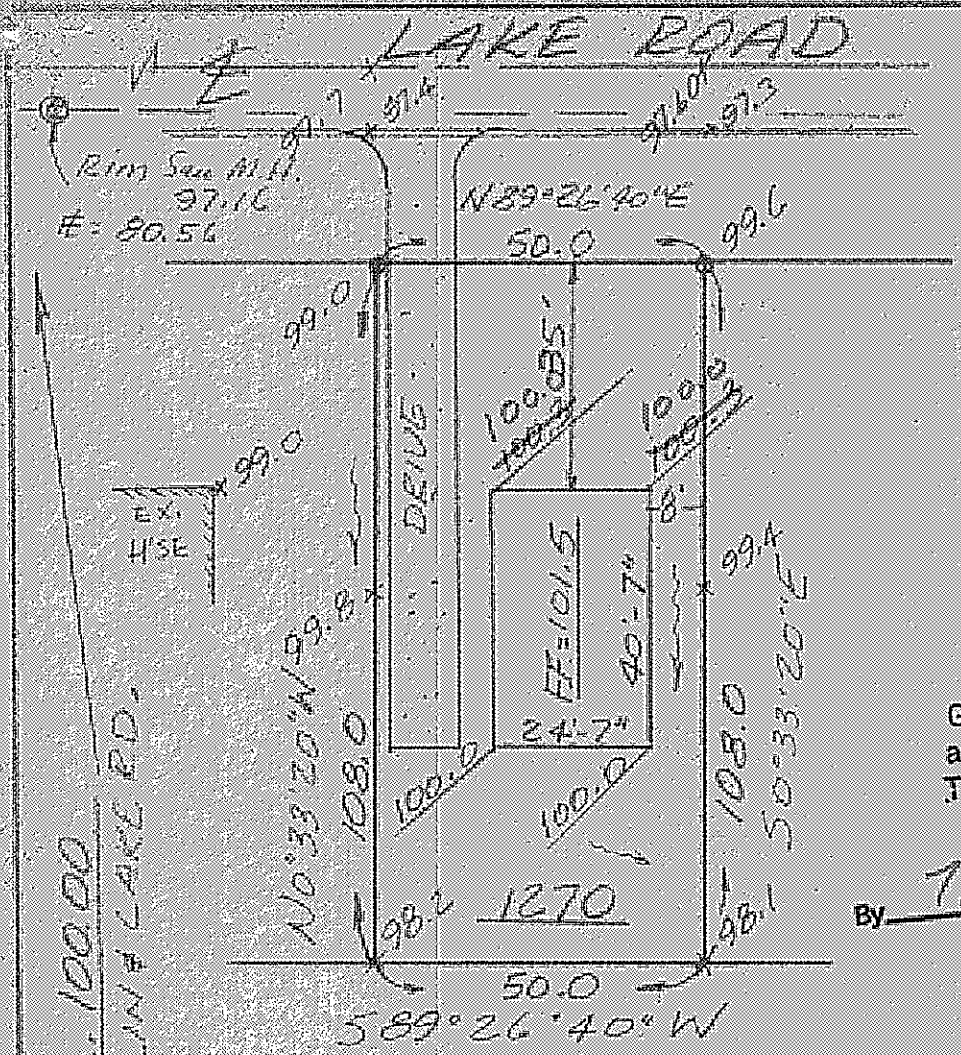

RECEIVED
Date 8-15-72
LAKE COUNTY
BLDG. INSPECTOR

Grading Plan Approved
as shown and/or noted
THOMAS P. GILLES, P.E.
Lake County Engineer
By TPG Date 17 Aug 72

APPROVED
MADISON TWP. ZONING
Permit: 8592
Zoning Inspector: OKB

GRADING PLAN
FOR
GINGER CONSTR. CO.
S/L 1270 CUMINGS BEACH PARK
MADISON TWP. - LAKE COUNTY OHIO
SCALE: 1"=30' MAY, 1972

AS BUILT CERTIFICATION
I HEREBY CERTIFY THAT THE CIRCLED
GRADES ARE EXISTING FINISH.
GRADES CHECKED IN THE FIELD ON _____
197___ SURVEY IS CORRECT TO THE BEST
OF MY KNOWLEDGE AND BELIEF.
FULLERTON-KERR & ASSOC.
by _____
REG. SURVEYOR N.

6954