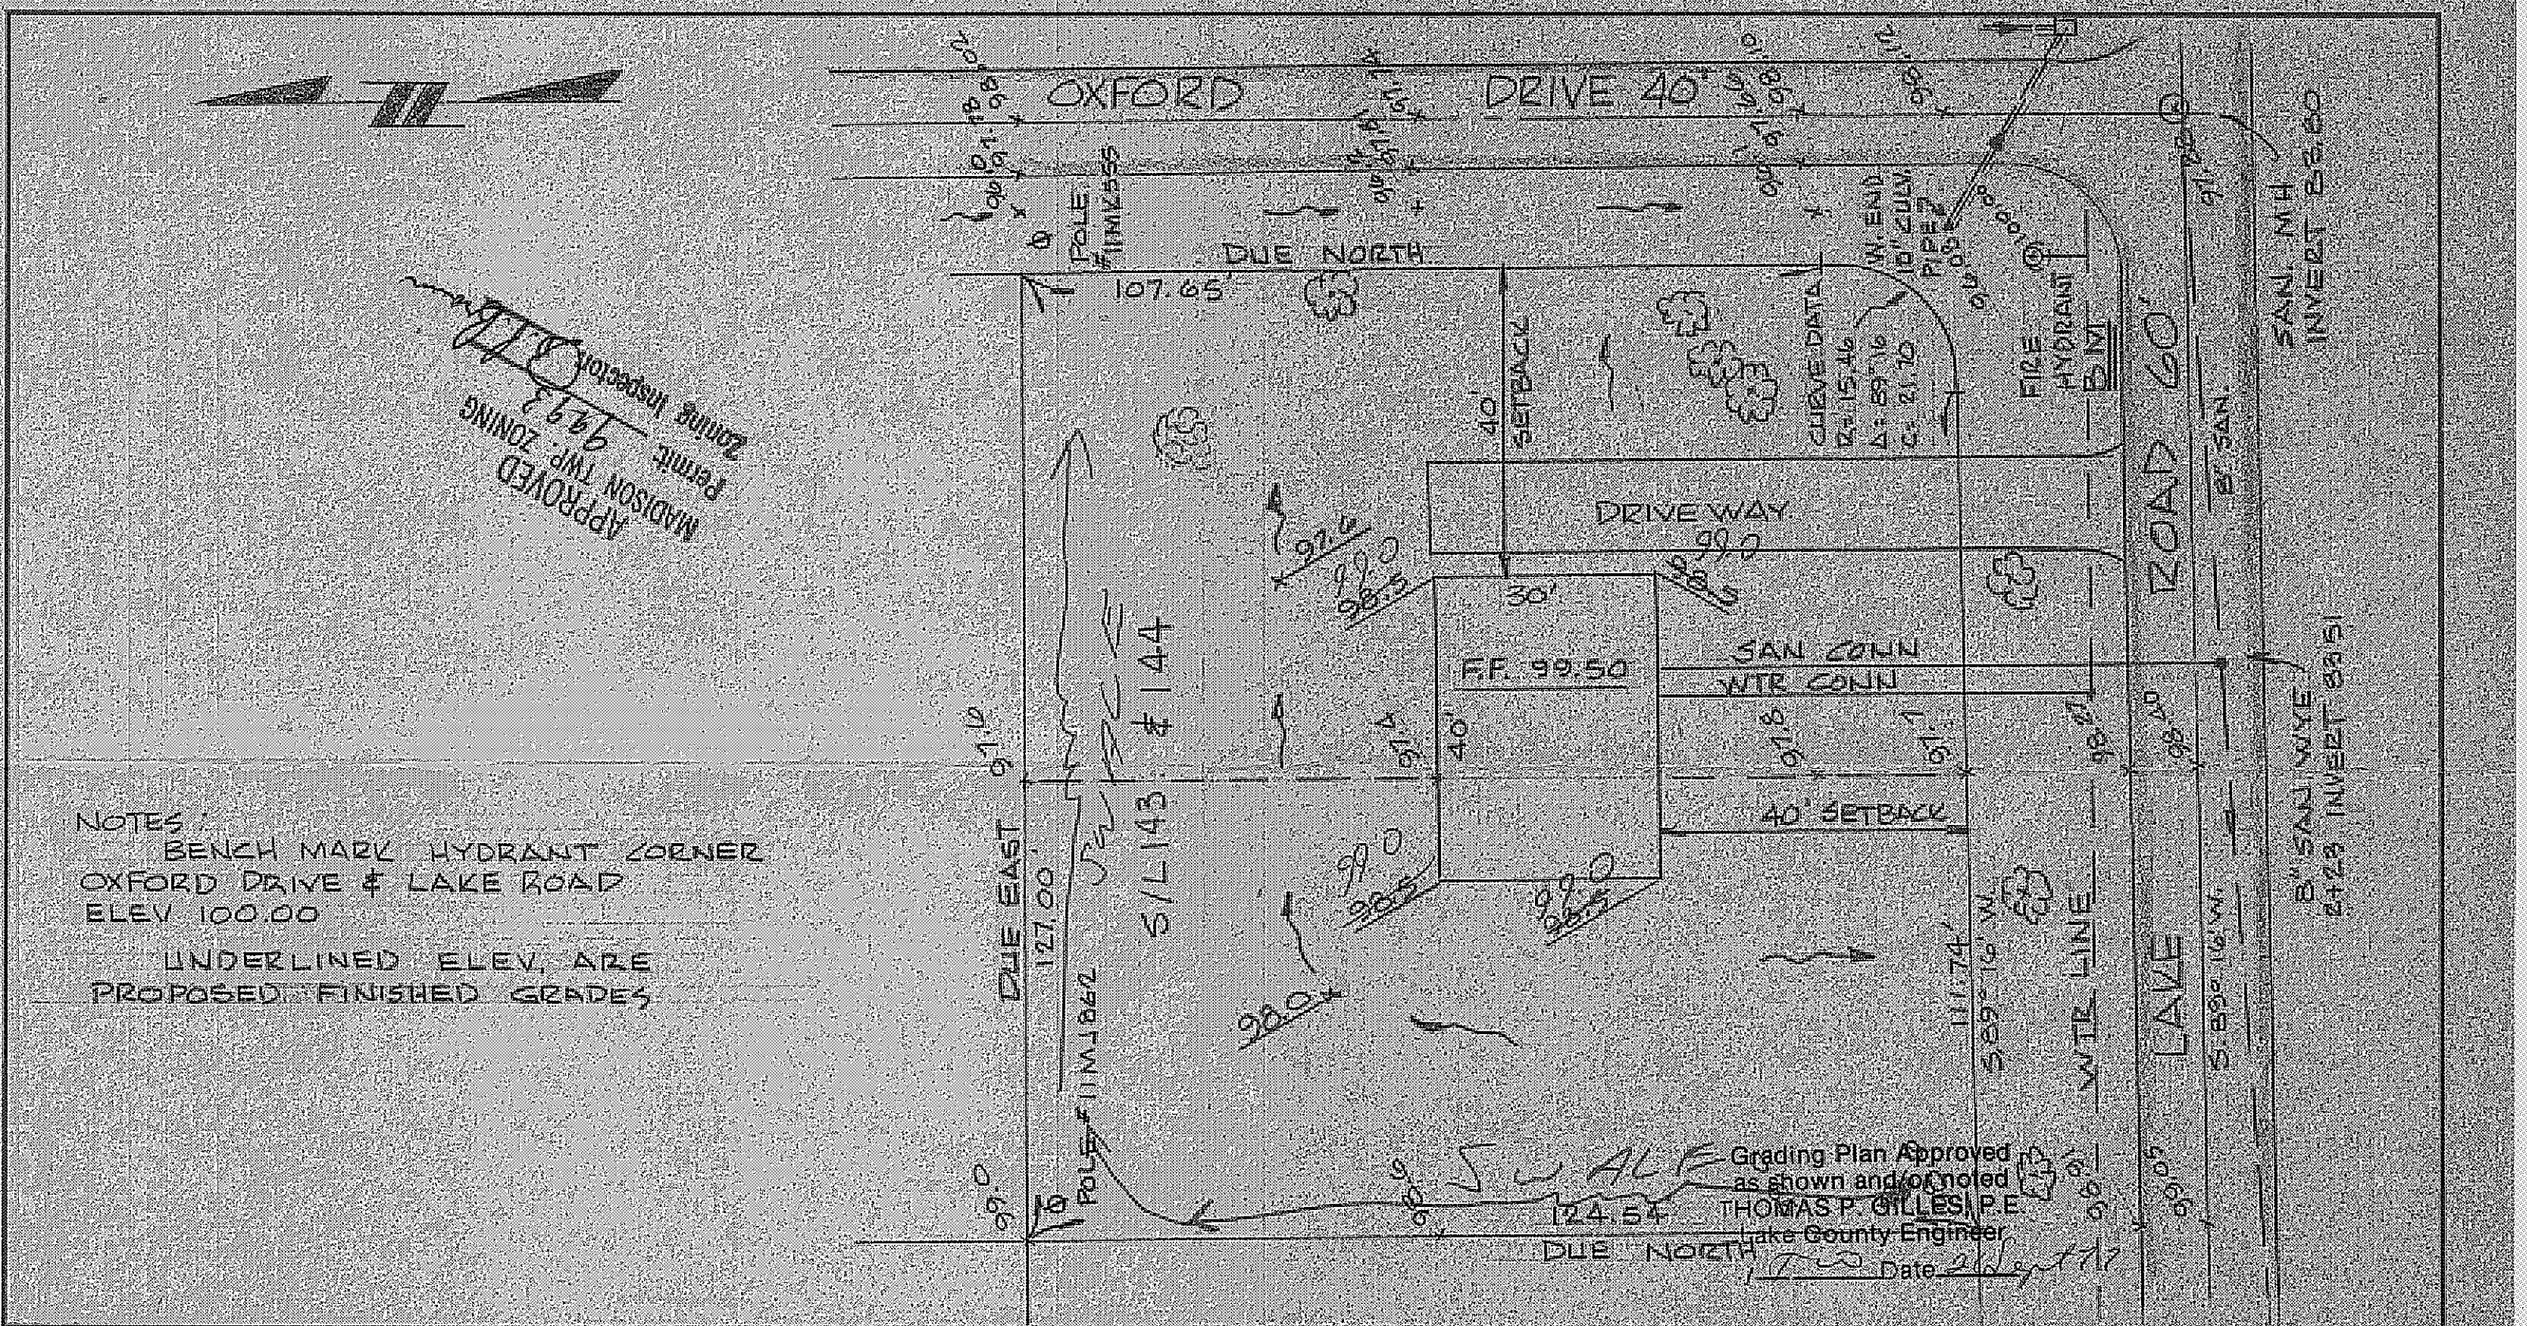

APPROVED
MADISON TWP. ZONING
Permit 9493
Zoning Inspector

NOTES:
BENCH MARK HYDRANT CORNER
OXFORD DRIVE & LAKE ROAD
ELEV 100.00

UNDERLINED ELEV. ARE
PROPOSED FINISHED GRADES

DESIGN CERTIFICATION	AS BUILT CERTIFICATION				
THIS PLAT WAS PREPARED BY ME, AND IS CORRECT TO THE BEST OF MY KNOWLEDGE AND BELIEF.	I HEREBY CERTIFY THAT THE CIRCLED GRADES ARE EXISTING FINISH GRADES CHECKED IN THE FIELD ON _____ AND THAT SURVEY IS CORRECT TO THE BEST OF MY KNOWLEDGE AND BELIEF.	COLPETZER · WOODS CONSULTANTS, INC. 180 SOUTH STATE STREET • PAINESVILLE, OHIO 44077 • (216) 357-7569	DATE 13 SEPT 77 SCALE 1" = 20' DRWN BY Gordi CHKD BY FT JOB NO. 77-213 FB 311 PG 73-85	S/L 143 & 144 MADISON BEACH SUBDIVISION	GRADING PLAN FOR CHARDON CENTURY BUILDERS
REG. SURVEYOR NO. 4785	REG. SURVEYOR NO. _____				