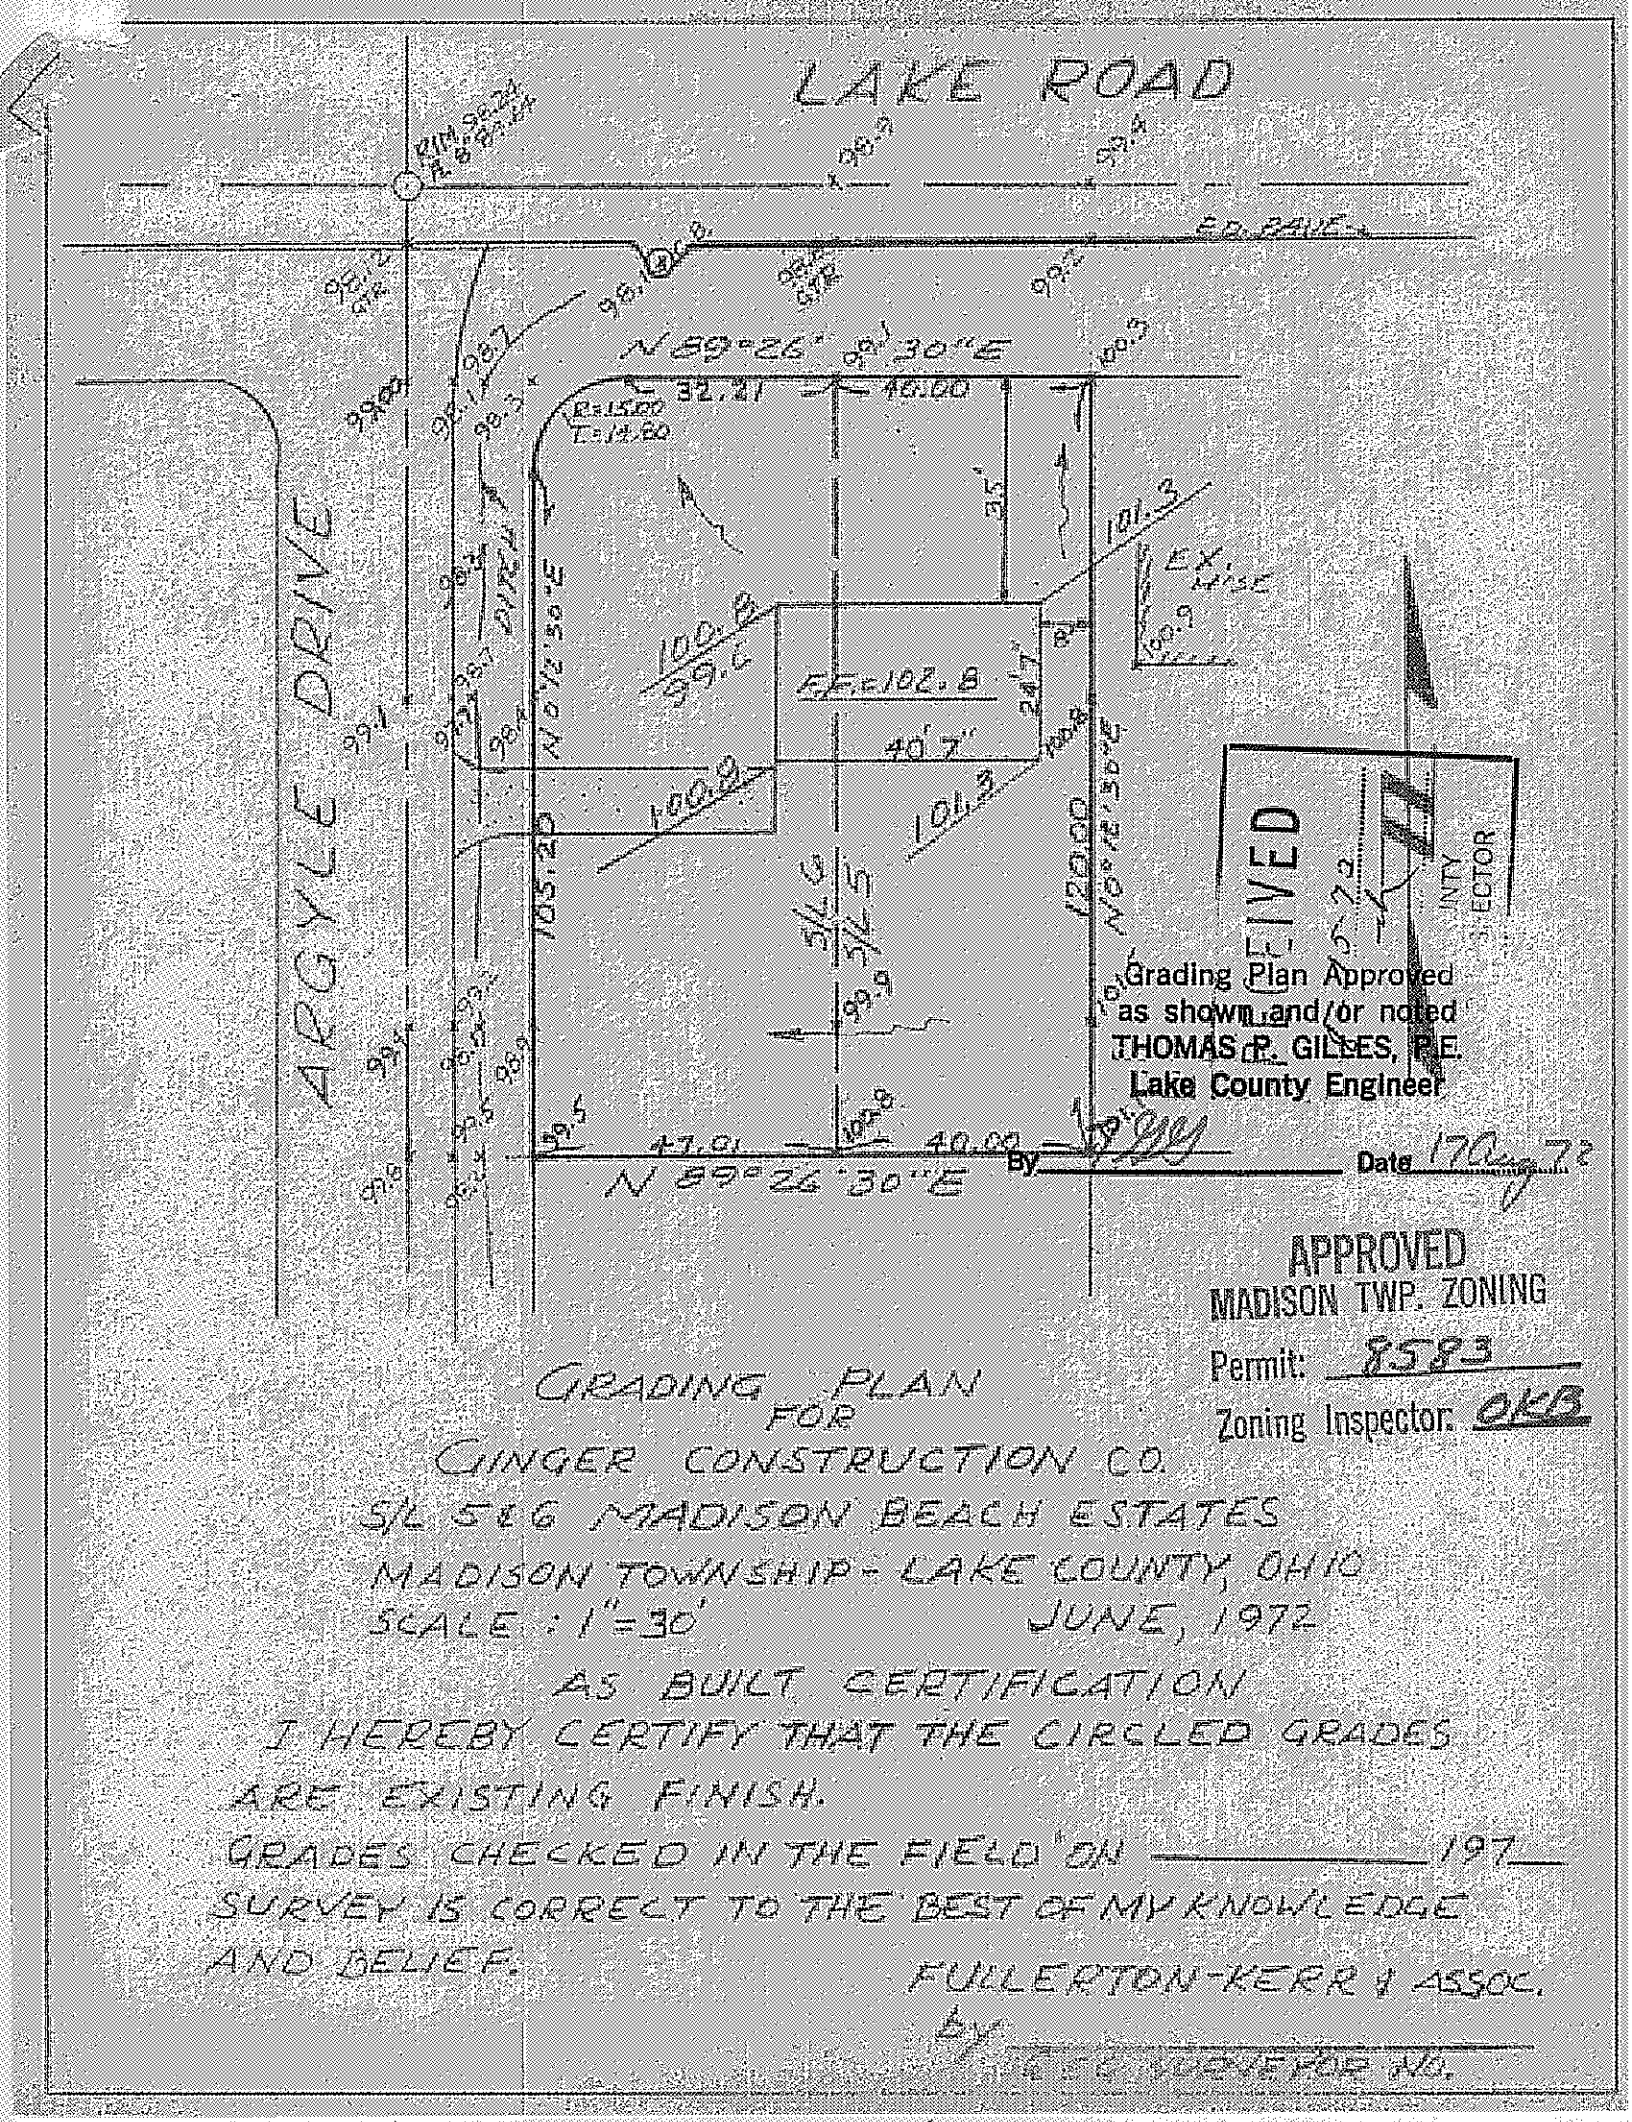

GRADING PLAN
FOR
GINGER CONSTRUCTION CO.
S/L 5 & 6 MADISON BEACH ESTATES
MADISON TOWNSHIP - LAKE COUNTY, OHIO
SCALE : 1"=30' JUNE, 1972

AS BUILT CERTIFICATION

I HEREBY CERTIFY THAT THE CIRCLED GRADES ARE EXISTING FINISH.

GRADES CHECKED IN THE FIELD ON _____ 197__

SURVEY IS CORRECT TO THE BEST OF MY KNOWLEDGE AND BELIEF.

FULLERTON-KERR & ASSOC.
by _____
[illegible] SURVEYOR NO.