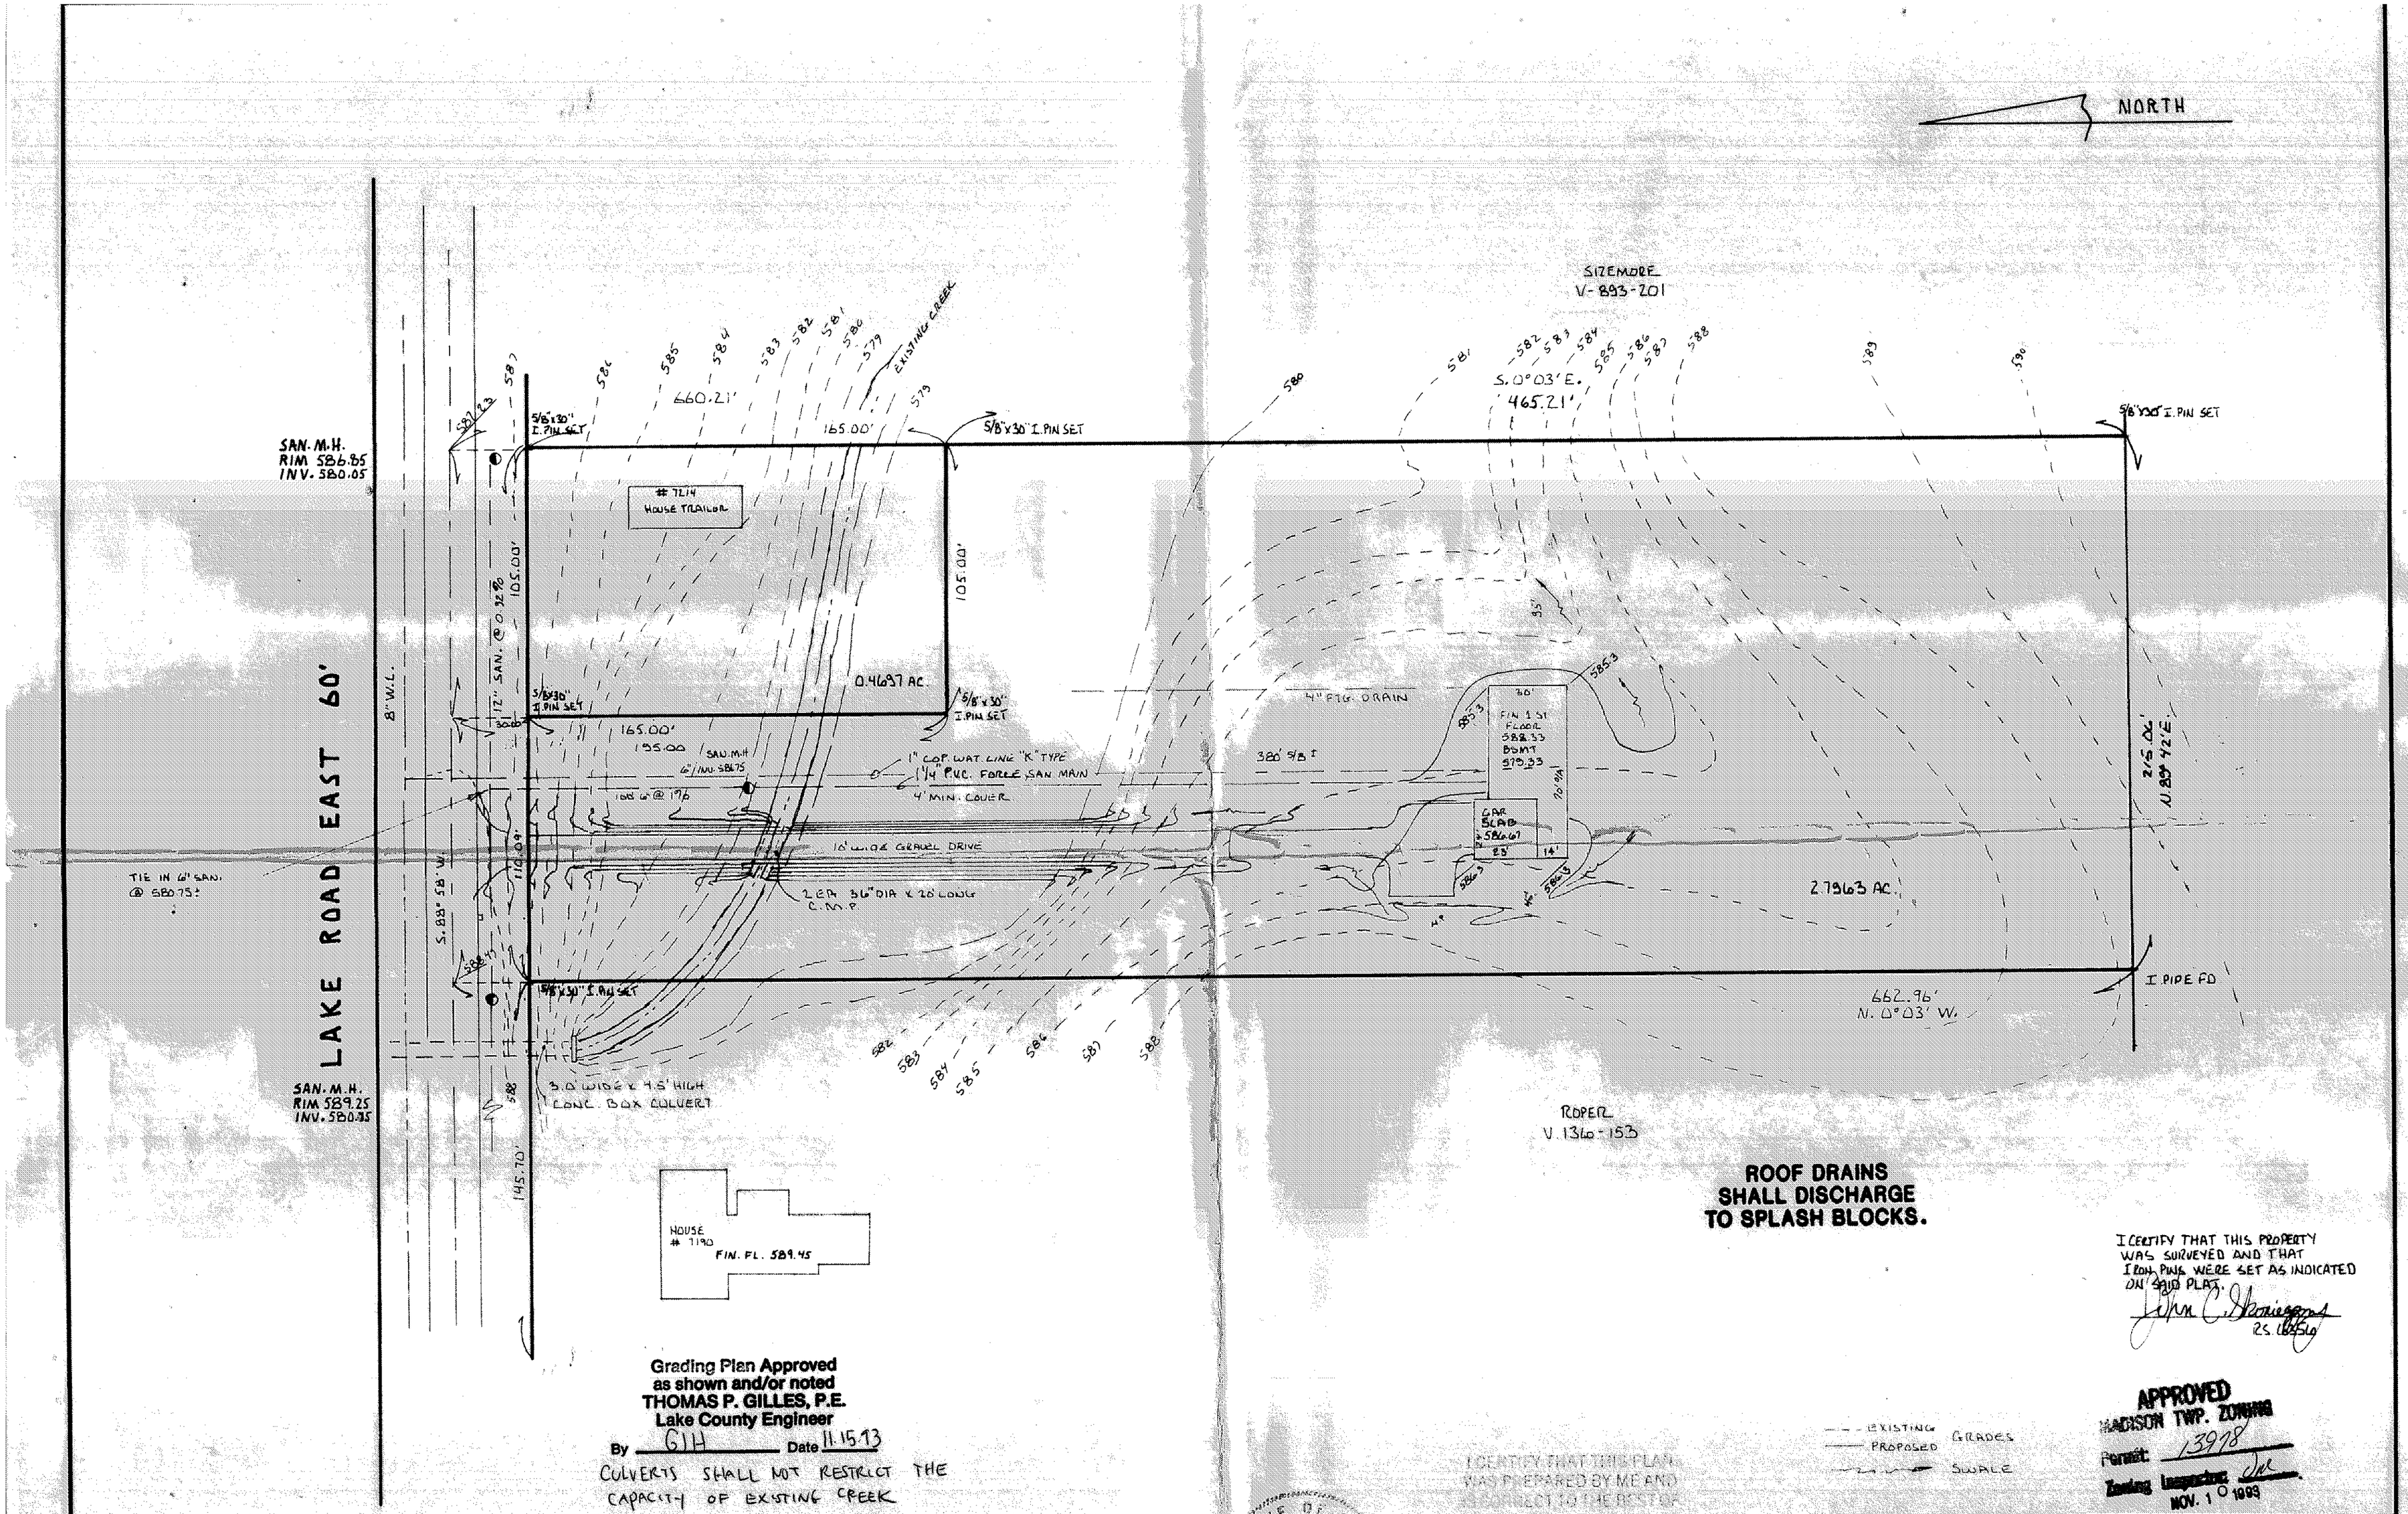

ROOF DRAINS SHALL DISCHARGE TO SPLASH BLOCKS.

I CERTIFY THAT THIS PROPERTY WAS SURVEYED AND THAT IRON PINS WERE SET AS INDICATED ON SAID PLAT.

John C. Skoniezny
RS. 16356

Grading Plan Approved as shown and/or noted
THOMAS P. GILLES, P.E.
Lake County Engineer
By GJH Date 11.15.93

CULVERTS SHALL NOT RESTRICT THE CAPACITY OF EXISTING CREEK

EXISTING
PROPOSED GRADES
SWALE

APPROVED
MADISON TWP. ZONING
Permit: 13978
Zoning Inspector: [signature]
NOV. 10 1993

I CERTIFY THAT THIS PLAN WAS PREPARED BY ME AND IS CORRECT TO THE BEST OF MY KNOWLEDGE AND BELIEF.

John C. Skoniezny
[illegible]

STATE OF OHIO
JOHN C. SKONIEZNY
[illegible]
REGISTERED SURVEYOR

JOHN C. SKONIEZNY
[illegible] VIEWMOUNT DR.
[illegible] OHIO 44[illegible]
[illegible] 352-7742

SITE PLAN FOR:
LARRY & FRAN REPKO

SCALE: 1" = 40'	APPROVED BY	DRAWN BY DTS
DATE: NOV. 93		

BEING PART OF A PARCEL OF LAND AS DESCRIBED IN VOL 814-1098
TOWNSHIP OF MADISON COUNTY OF LAKE STATE OF OHIO

JOB # 93-1762 DRAWING NUMBER 93-1216