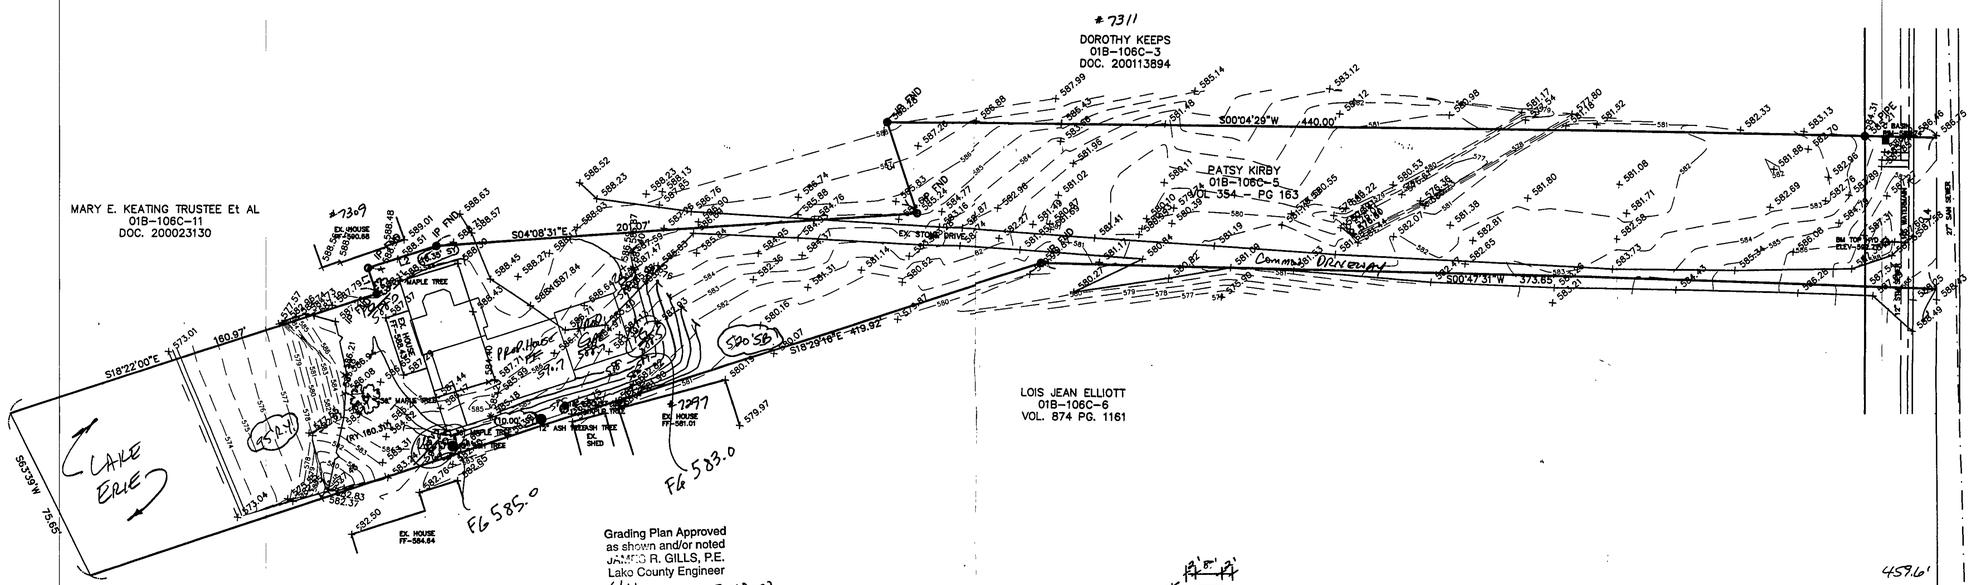

Grading Plan Approved
as shown and/or noted
JAMES R. GILLS, P.E.
Lake County Engineer
By GLH Date 7-18-02
Lower Finished grads as shown

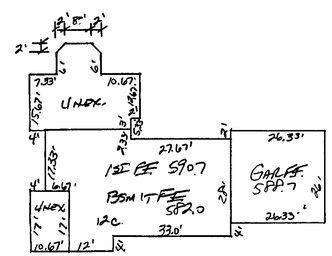

"I, the undersigned hereby certify that this topography indicated by 6", 1' or 2' contours, and elevations shown hereon represent as actual field survey made by me on the 17th day of June, 2002 and that the elevations were taken at appropriate intervals and that as of that date they existed as indicated hereon."

Name Reg. No. #6343

APPROVED
MADISON TOWNSHIP ZONING
DATE 7/2/02
BY [illegible] 20970

GRAPHIC SCALE

(IN FEET)
1 inch = 30 ft.

LINE TABLE		
LINE	LENGTH	BEARING
L1	11.50'	N71°38'00"E
L2	30.00'	N18°22'00"W
L3	40.00'	N71°38'00"E
L4	63.10'	N89°10'00"E

BM TOP OF HYD
ELEV-592.77

EXISTING UTILITIES NOTE:
THE SIZE AND LOCATION, BOTH HORIZONTAL AND VERTICAL OF THE UNDERGROUND UTILITIES SHOWN HEREON, HAVE BEEN OBTAINED BY A SEARCH OF AVAILABLE RECORDS. VERIFICATION BY FIELD OBSERVATION HAS BEEN CONDUCTED WHERE PRACTICAL, HOWEVER, BABCOCK, JONES AND ASSOCIATES INC. DOES NOT GUARANTEE THE COMPLETENESS NOR ACCURACY THEREOF.

STATE OF OHIO HARRY E. JONES JR. S-6848 REGISTERED PROFESSIONAL SURVEYOR

REV NO.	DESCRIPTION	DATE	BY	CHK'D

BABCOCK, JONES AND ASSOCIATES, INC
CIVIL ENGINEERS – SURVEYORS – LAND PLANNERS
PAINESVILLE OHIO 44077

DATE	6/20/02
DESIGN BY	HJ
DRAWN BY	NS
APPROVED BY	HJ

PLAT OF SURVEY
FOR
PATSY KIRBY
MADISON TOWNSHIP LAKE COUNTY STATE OF OHIO

SCALE	1"=30'
JOB NO	02-092
SHEET	1 OF 1