I, the undersigned hereby certify this topograghy, indicated by 1' contours, and elevations shown hereon represent an actual field survey by me on March 18, 1996 and that the were taken at appropriate intervals and that as of that date they existed as indicated hereon. T. M. Coffman P.S. No 6857

STATE OF OHIO
THOMAS MARC COFFMAN
6857
REGISTERED SURVEYOR

March 25, 1996

SITE PLAN
FOR
STERLING CUSTOM BLDR'S
BEING KNOWN AS THE EASTERLY 25.5 FEET OF S/L 9
AND ALL OF S/L 10 IN EUGENIA ESTATES, MADISON
TOWNSHIP, LAKE COUNTY, OHIO.

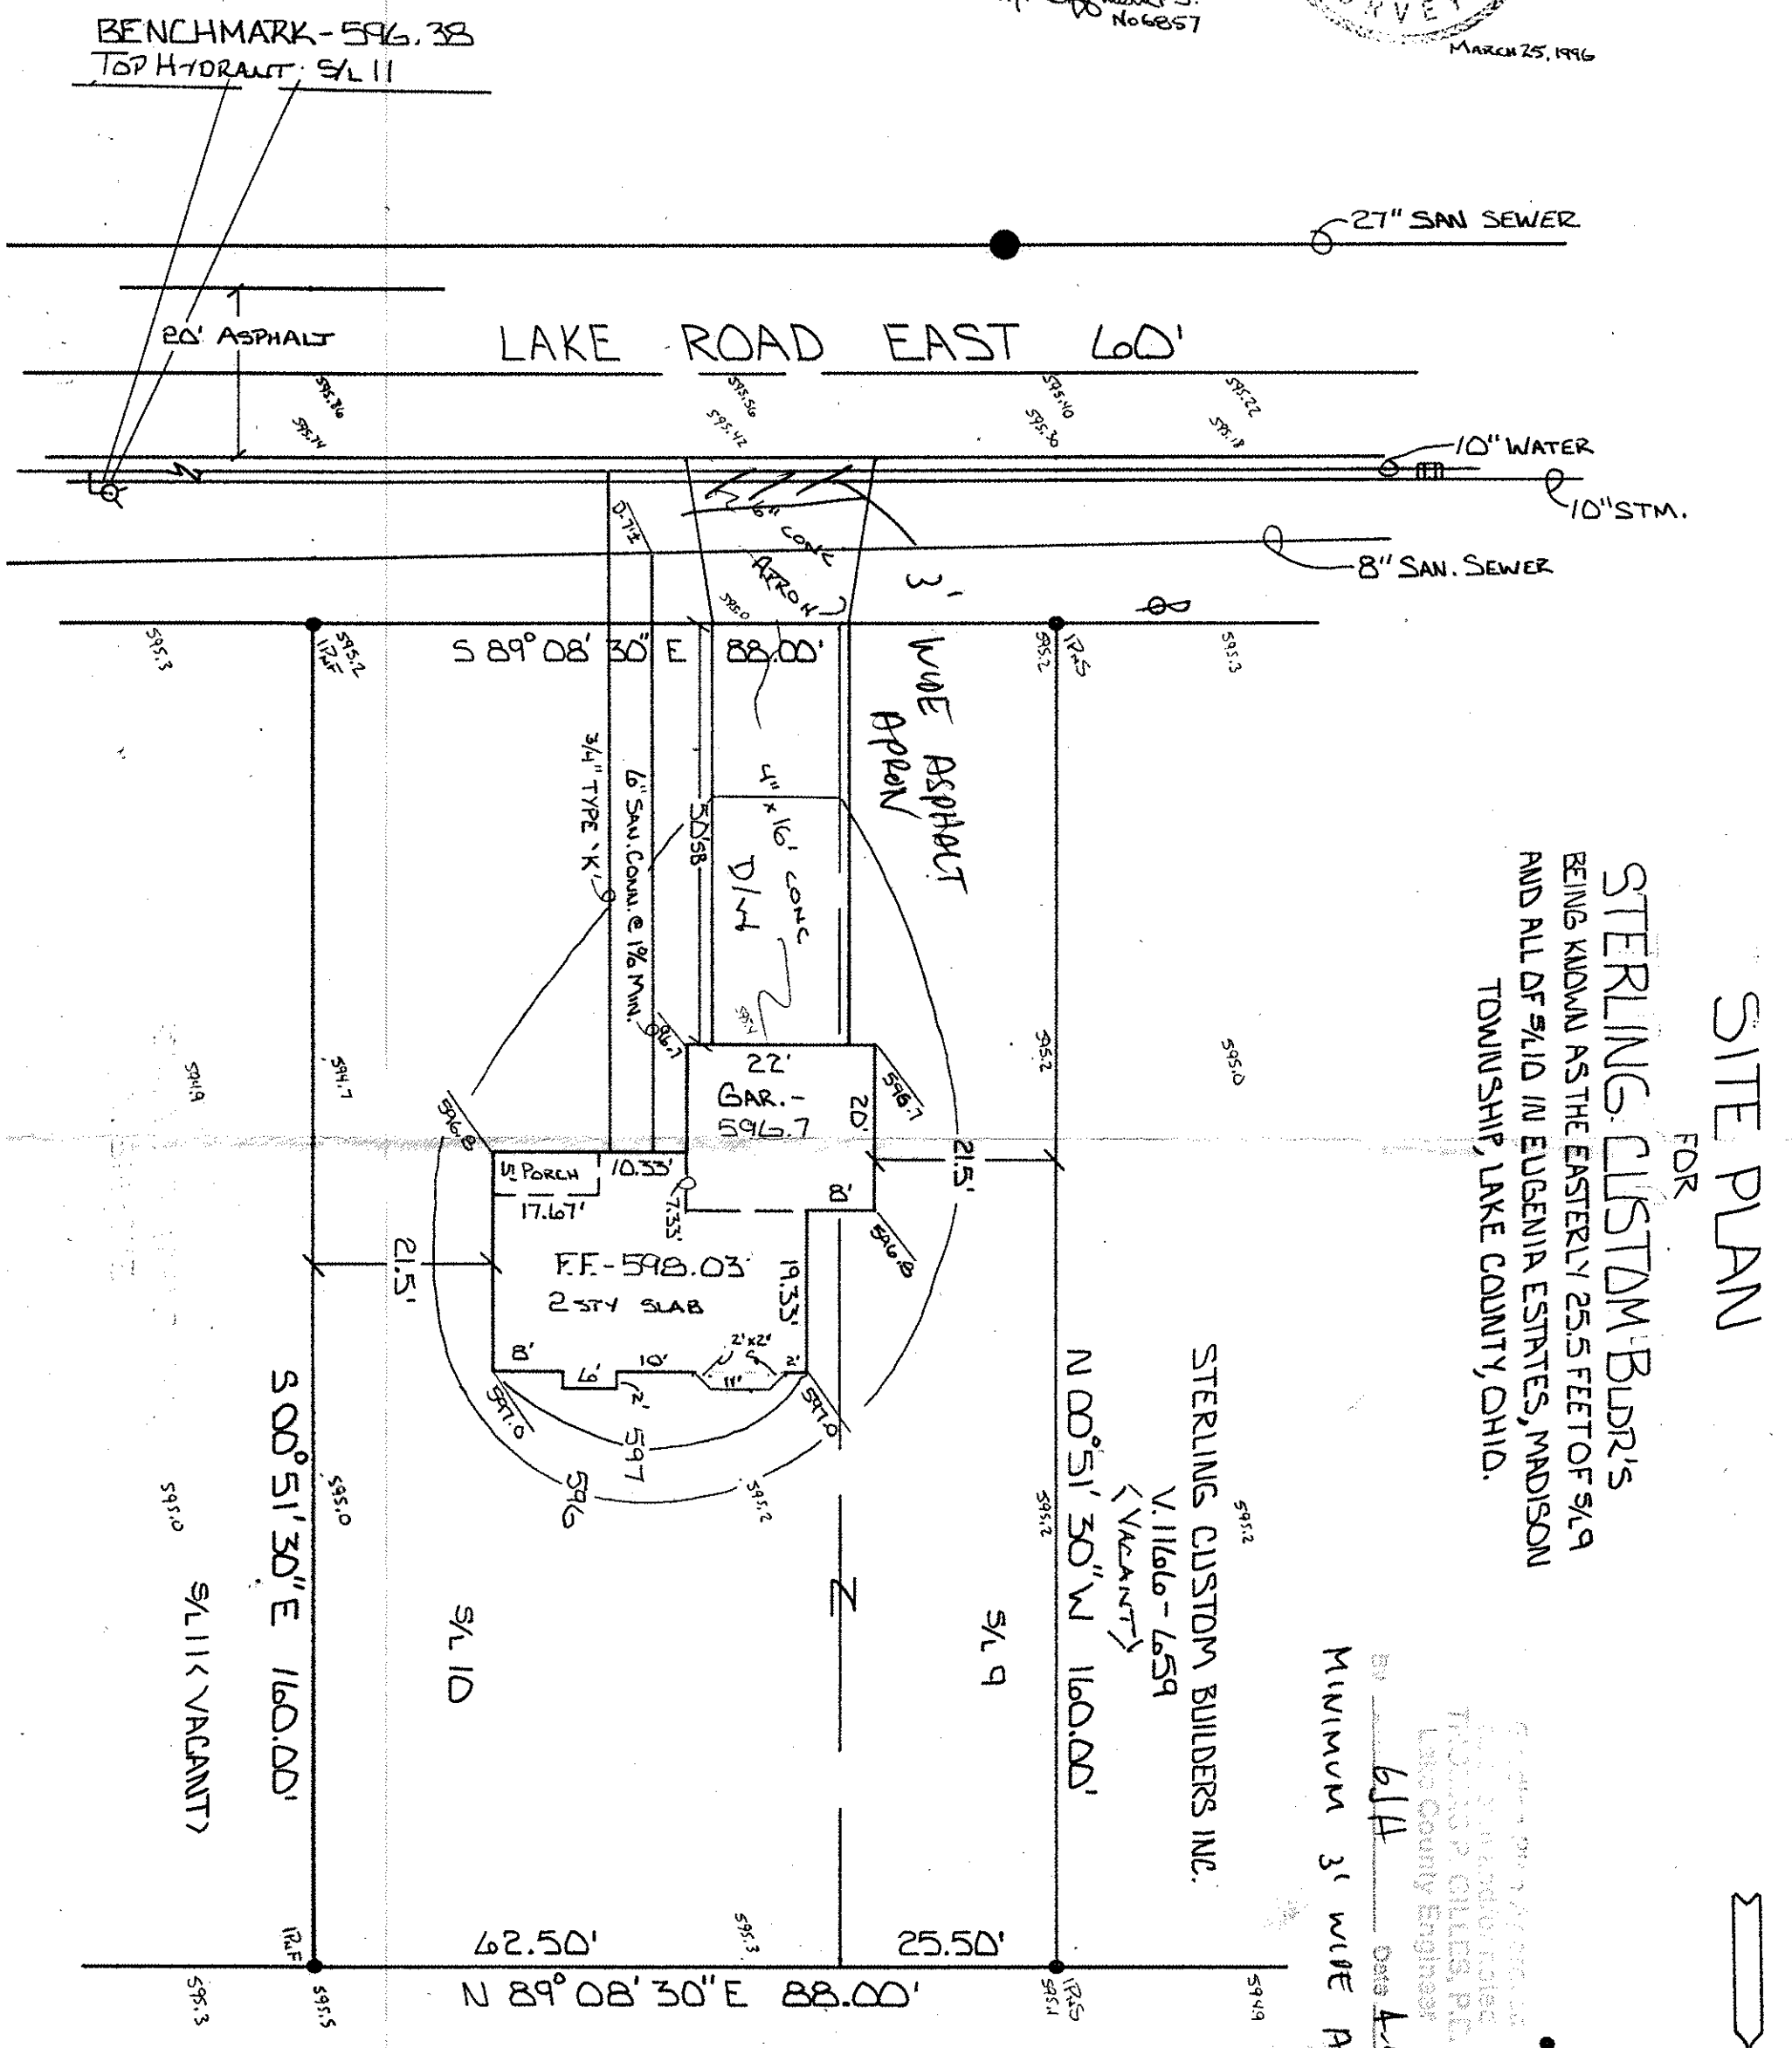

Approved by Lake County Engineer
Lake County Planning Commission
Township Officials
Lake County Engineer
BJH Date 4-4-96

APPROVED
MADISON TOWNSHIP ZONING
APR 2 1996
PERMIT # 14859
ZONING INSPECTOR OM

VILLAGE SURVEYING CO.
P.O. BOX 1096 FAIRPORT HARBOR, OHIO. 44077
<216> 354-4261