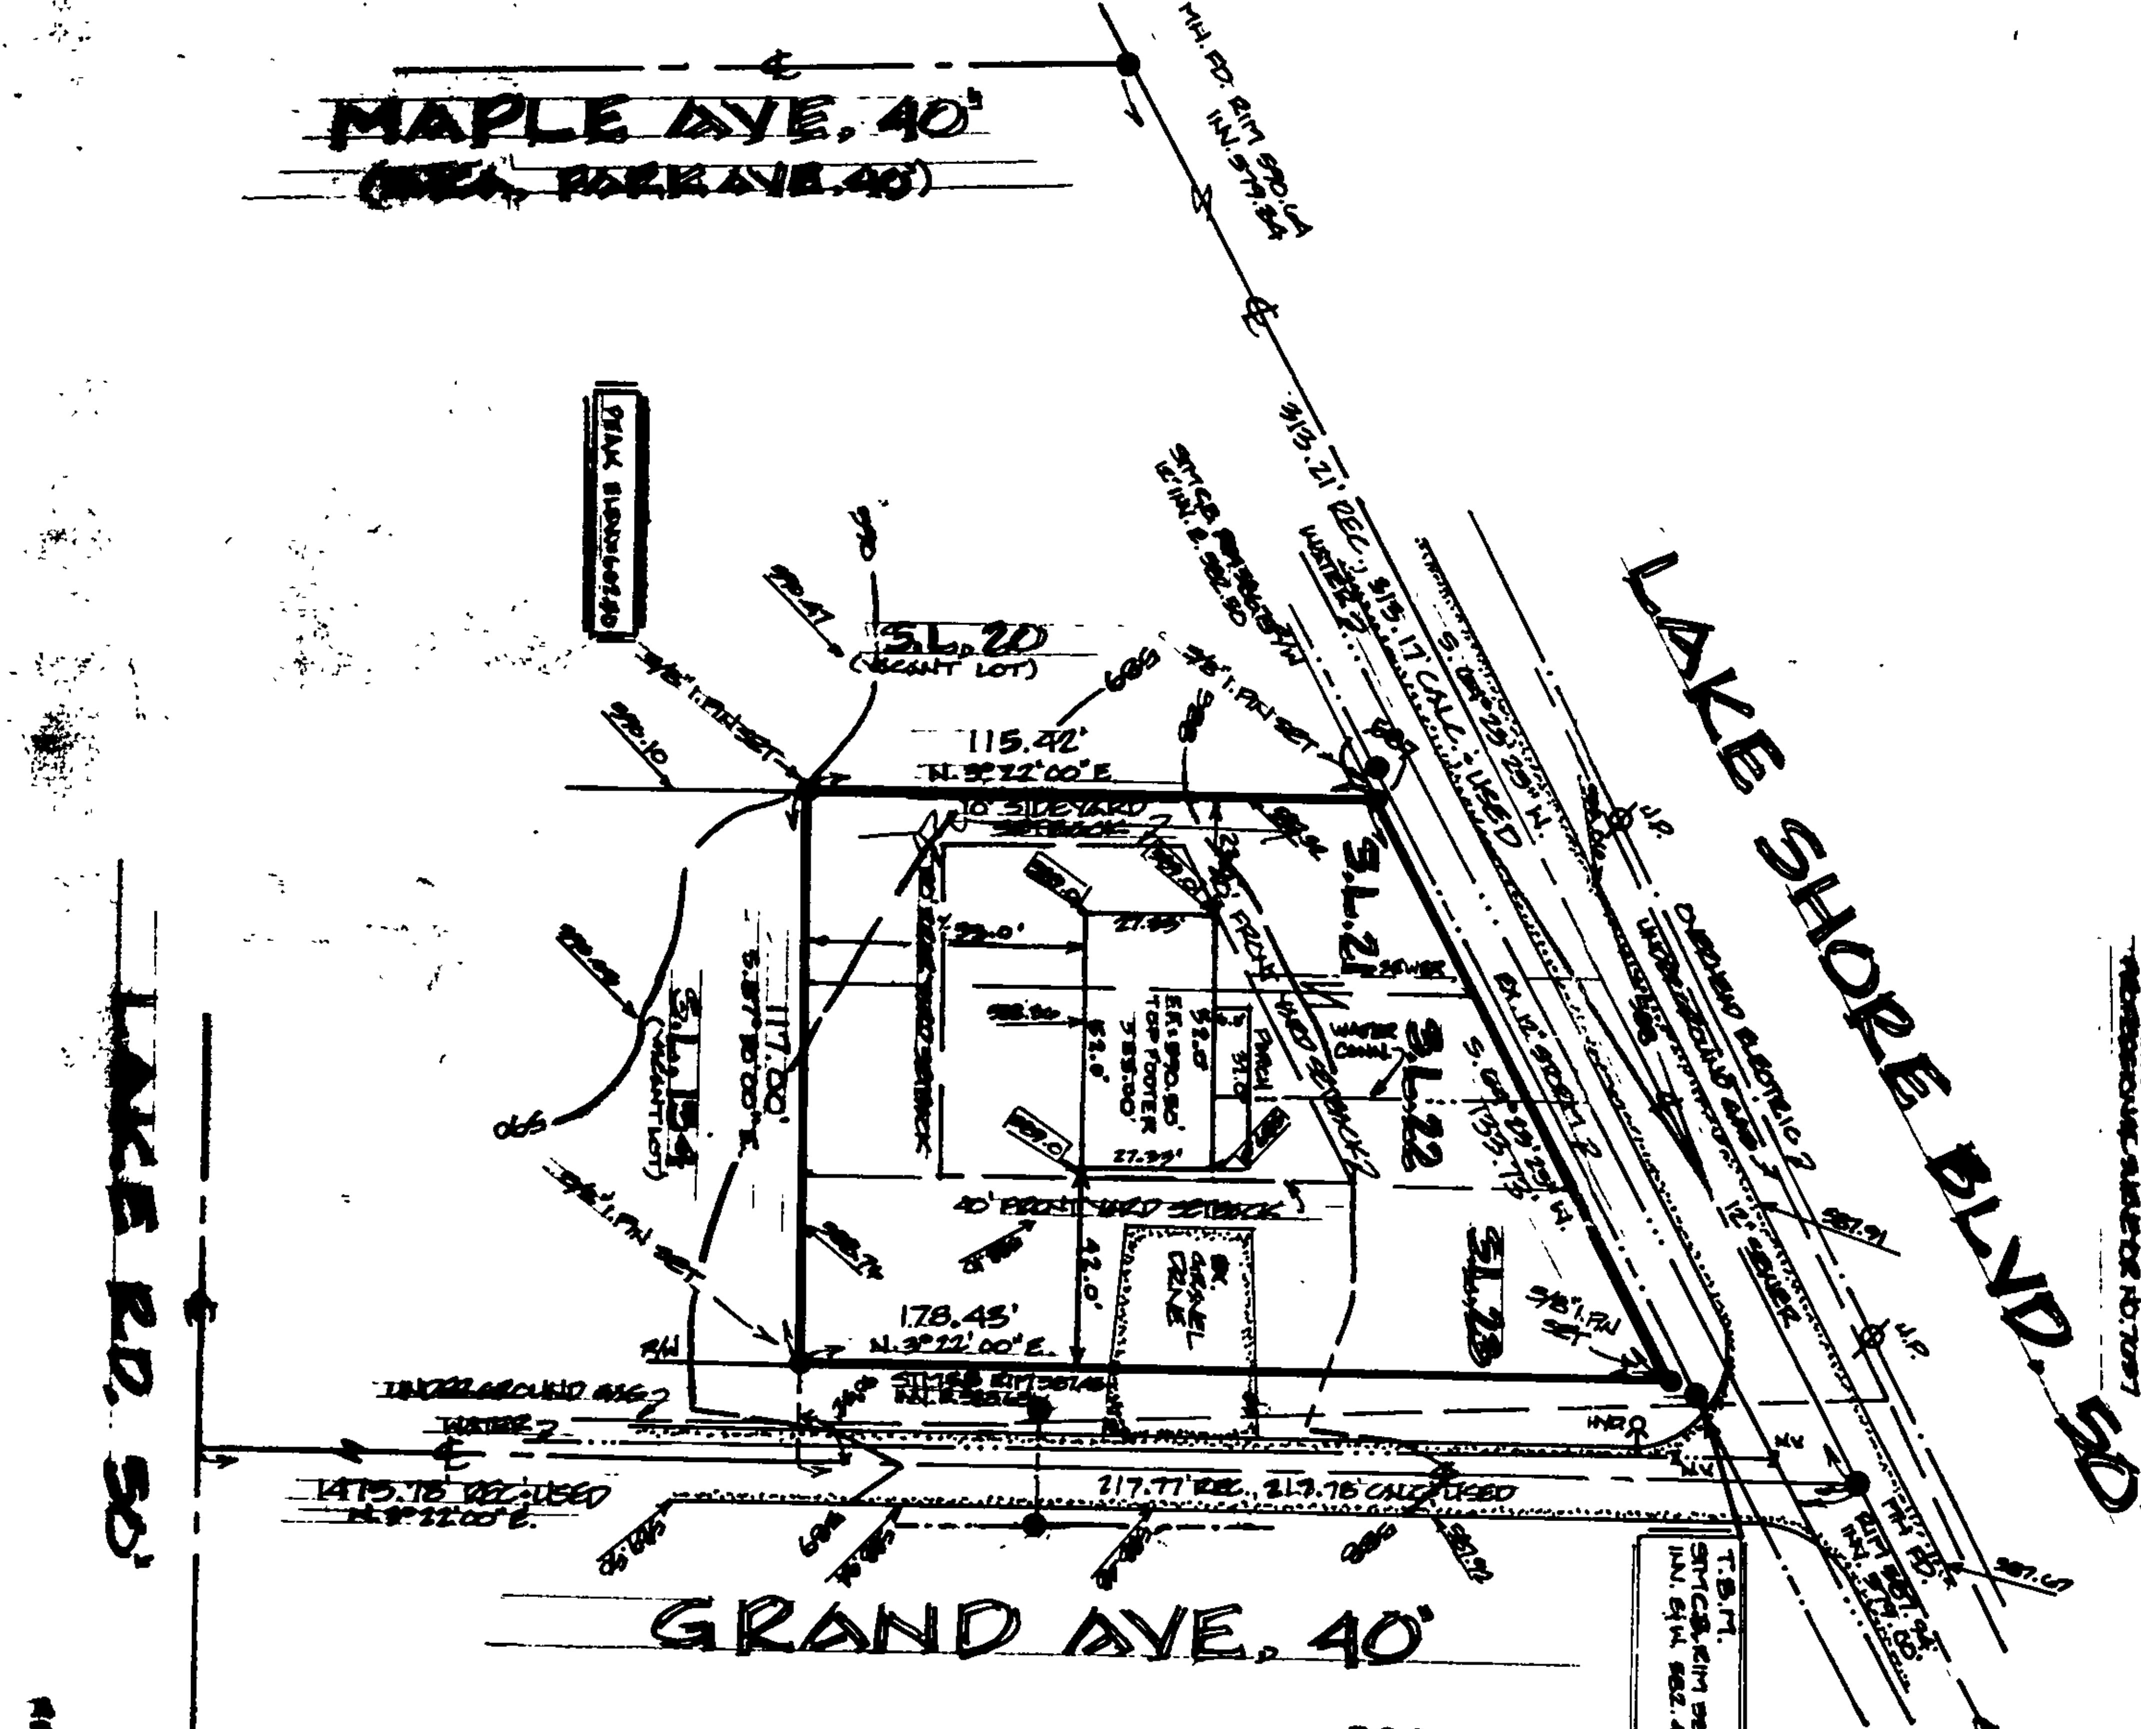

Grading Plan Approved
as shown and/or noted
JAMES R. GILLS, P.E.
Lake County Engineer

By TAM Date 5-10-01
Swale as Shown

ROOF DRAINS
SHALL DISCHARGE
TO SPLASH BLOCKS.

REV. 4-17-01

APPROVED
MADISON TOWNSHIP ZONING
DATE 4/23/01
BY JM 20438

STATE OF OHIO
DOUGLAS W. FLEMING
S-7057
REGISTERED PROFESSIONAL SURVEYOR

TOPOGRAPHIC IMPROVEMENT PLA[N]
FOR
JAMES McKOOL

SITUATED IN THE TWP OF MADISON, COUNTY OF LAKE, AND STATE OF OHIO, AND KNOWN AS BEING SUBLOTS NO. 21, 22, 23 IN LAKE BREEZE PARK SUBDIVISION OF PART OF LOT NO. 16, MADISON TOWNSHIP SHOWN BY THE RECORDED PLAT VOLUME "D", PAGE 8 OF LAKE COUNTY RECORDS.

ZONING INSPECTOR

CITY ENGINEER

DISTANCES SHOWN HEREON ARE GIVEN IN FEET AND DECIMAL PARTS THEREOF. BEARINGS SHOWN HEREON ARE TO AN ASSUMED MERIDIAN AND ARE USED TO DENOTE ANGLES ONLY. I HEREBY STATE TO THE BEST OF MY PROFESSIONAL KNOWLEDGE, INFORMATION AND BELIEF, ALL BE CORRECT.

I, THE UNDERSIGNED HEREBY CERTIFY THAT THE TOPOGRAPHY SHOWN HEREON IS LOCATED BY ONE FOOT CONTOURS AND ELEVATIONS REPRESENTS AN ACTUAL FIELD TOPOGRAPHIC SURVEY MADE BY ME ON THE 22ND DAY OF MARCH 2001 AND THAT THE ELEVATIONS WERE TAKEN AT APPROPRIATE INTERVALS AND THAT [illegible] OF THAT DATE THEY EXISTED AS INDICATED HEREON.

Douglas W. Fleming
DOUGLAS W. FLEMING, P.S.
PROFESSIONAL SURVEYOR NO. 7057