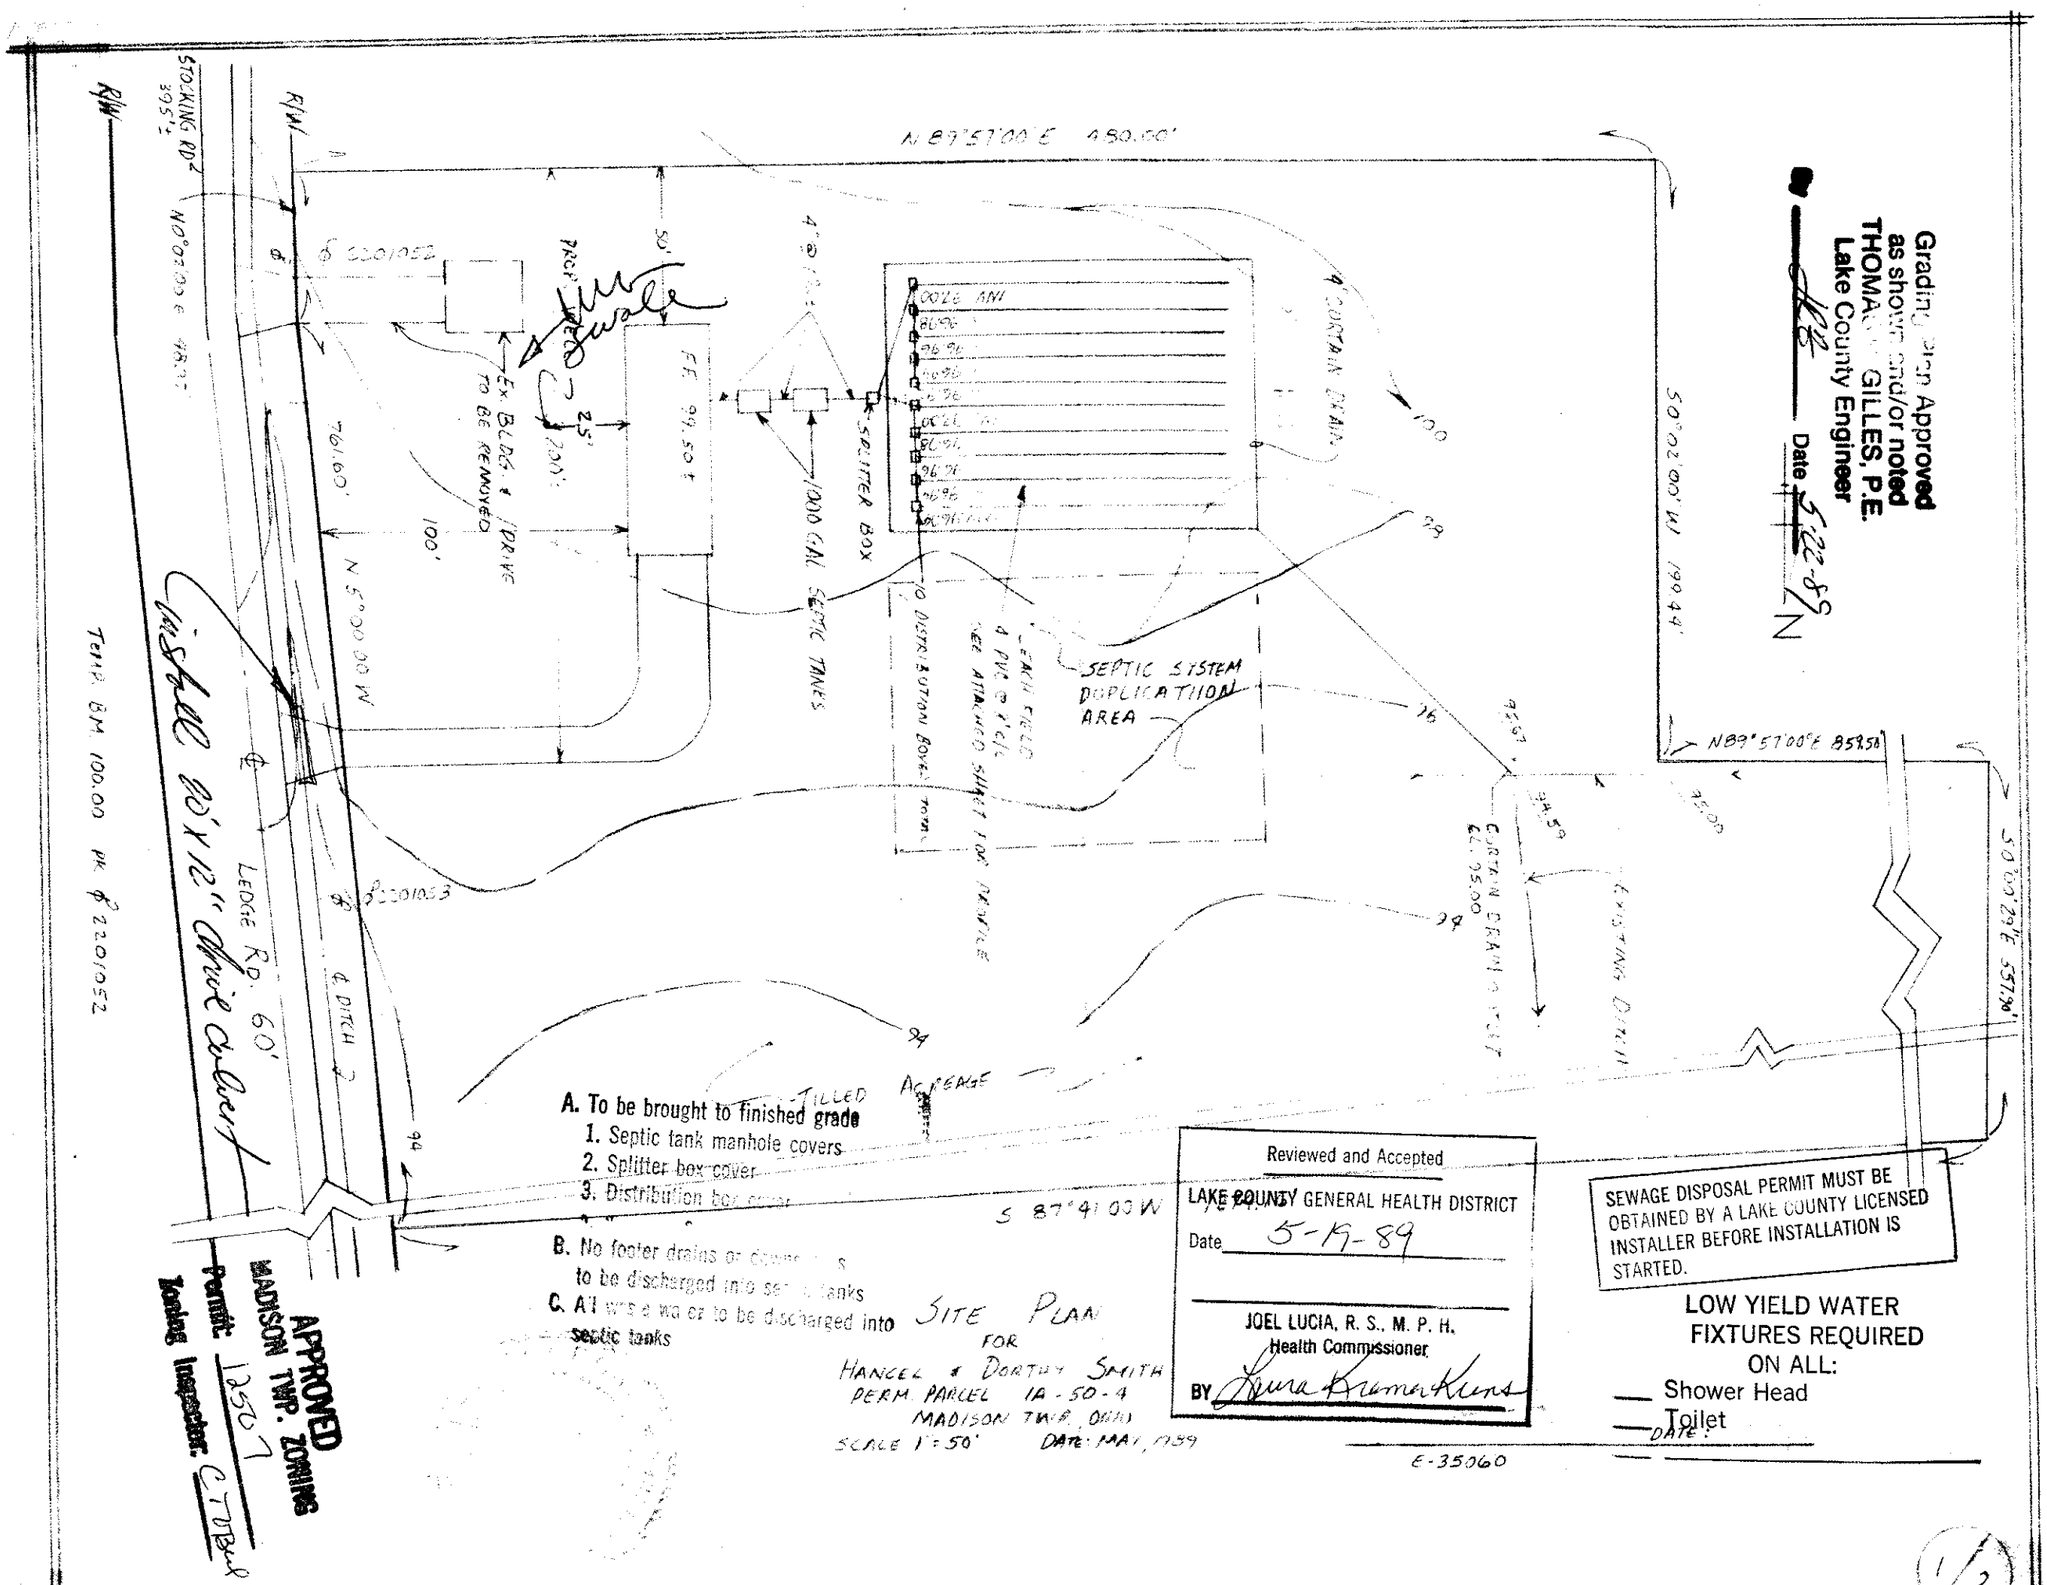

A. To be brought to finished grade
1. Septic tank manhole covers
2. Splitter box cover
3. Distribution box cover

B. No footer drains or downspouts to be discharged into septic tanks

C. All waste water to be discharged into septic tanks

SITE PLAN
FOR
HANCEL & DORTHY SMITH
PERM. PARCEL 1A-50-4
MADISON TWP., OHIO
SCALE 1"=50' DATE: MAY, 1989

Reviewed and Accepted
LAKE COUNTY GENERAL HEALTH DISTRICT
Date 5-19-89
JOEL LUCIA, R. S., M. P. H.
Health Commissioner
BY Laura Kramer Kuns

SEWAGE DISPOSAL PERMIT MUST BE OBTAINED BY A LAKE COUNTY LICENSED INSTALLER BEFORE INSTALLATION IS STARTED.

LOW YIELD WATER FIXTURES REQUIRED ON ALL:
___ Shower Head
___ Toilet
DATE:

E-35060

Grading Plan Approved as shown and/or noted
THOMAS W. GILLES, P.E.
Lake County Engineer
By [signature] Date 5-22-89

APPROVED
MADISON TWP. ZONING
Permit: 12507
Zoning Inspector: C T Bell

1/2