SEP. 22 1988

SITE PLAN
FOR
JOHN INGLE

VOL 255-86
BEING PART OF LOT 8, TRACT 4,
MADISON TWP, LAKE CO., STATE OF OH.

Grading Plan Approved
as shown and/or noted
THOMAS P. GILLES, P.E
Lake County Engineer
By HB Date 3-1-87
Contingent upon approval by Health Dept.

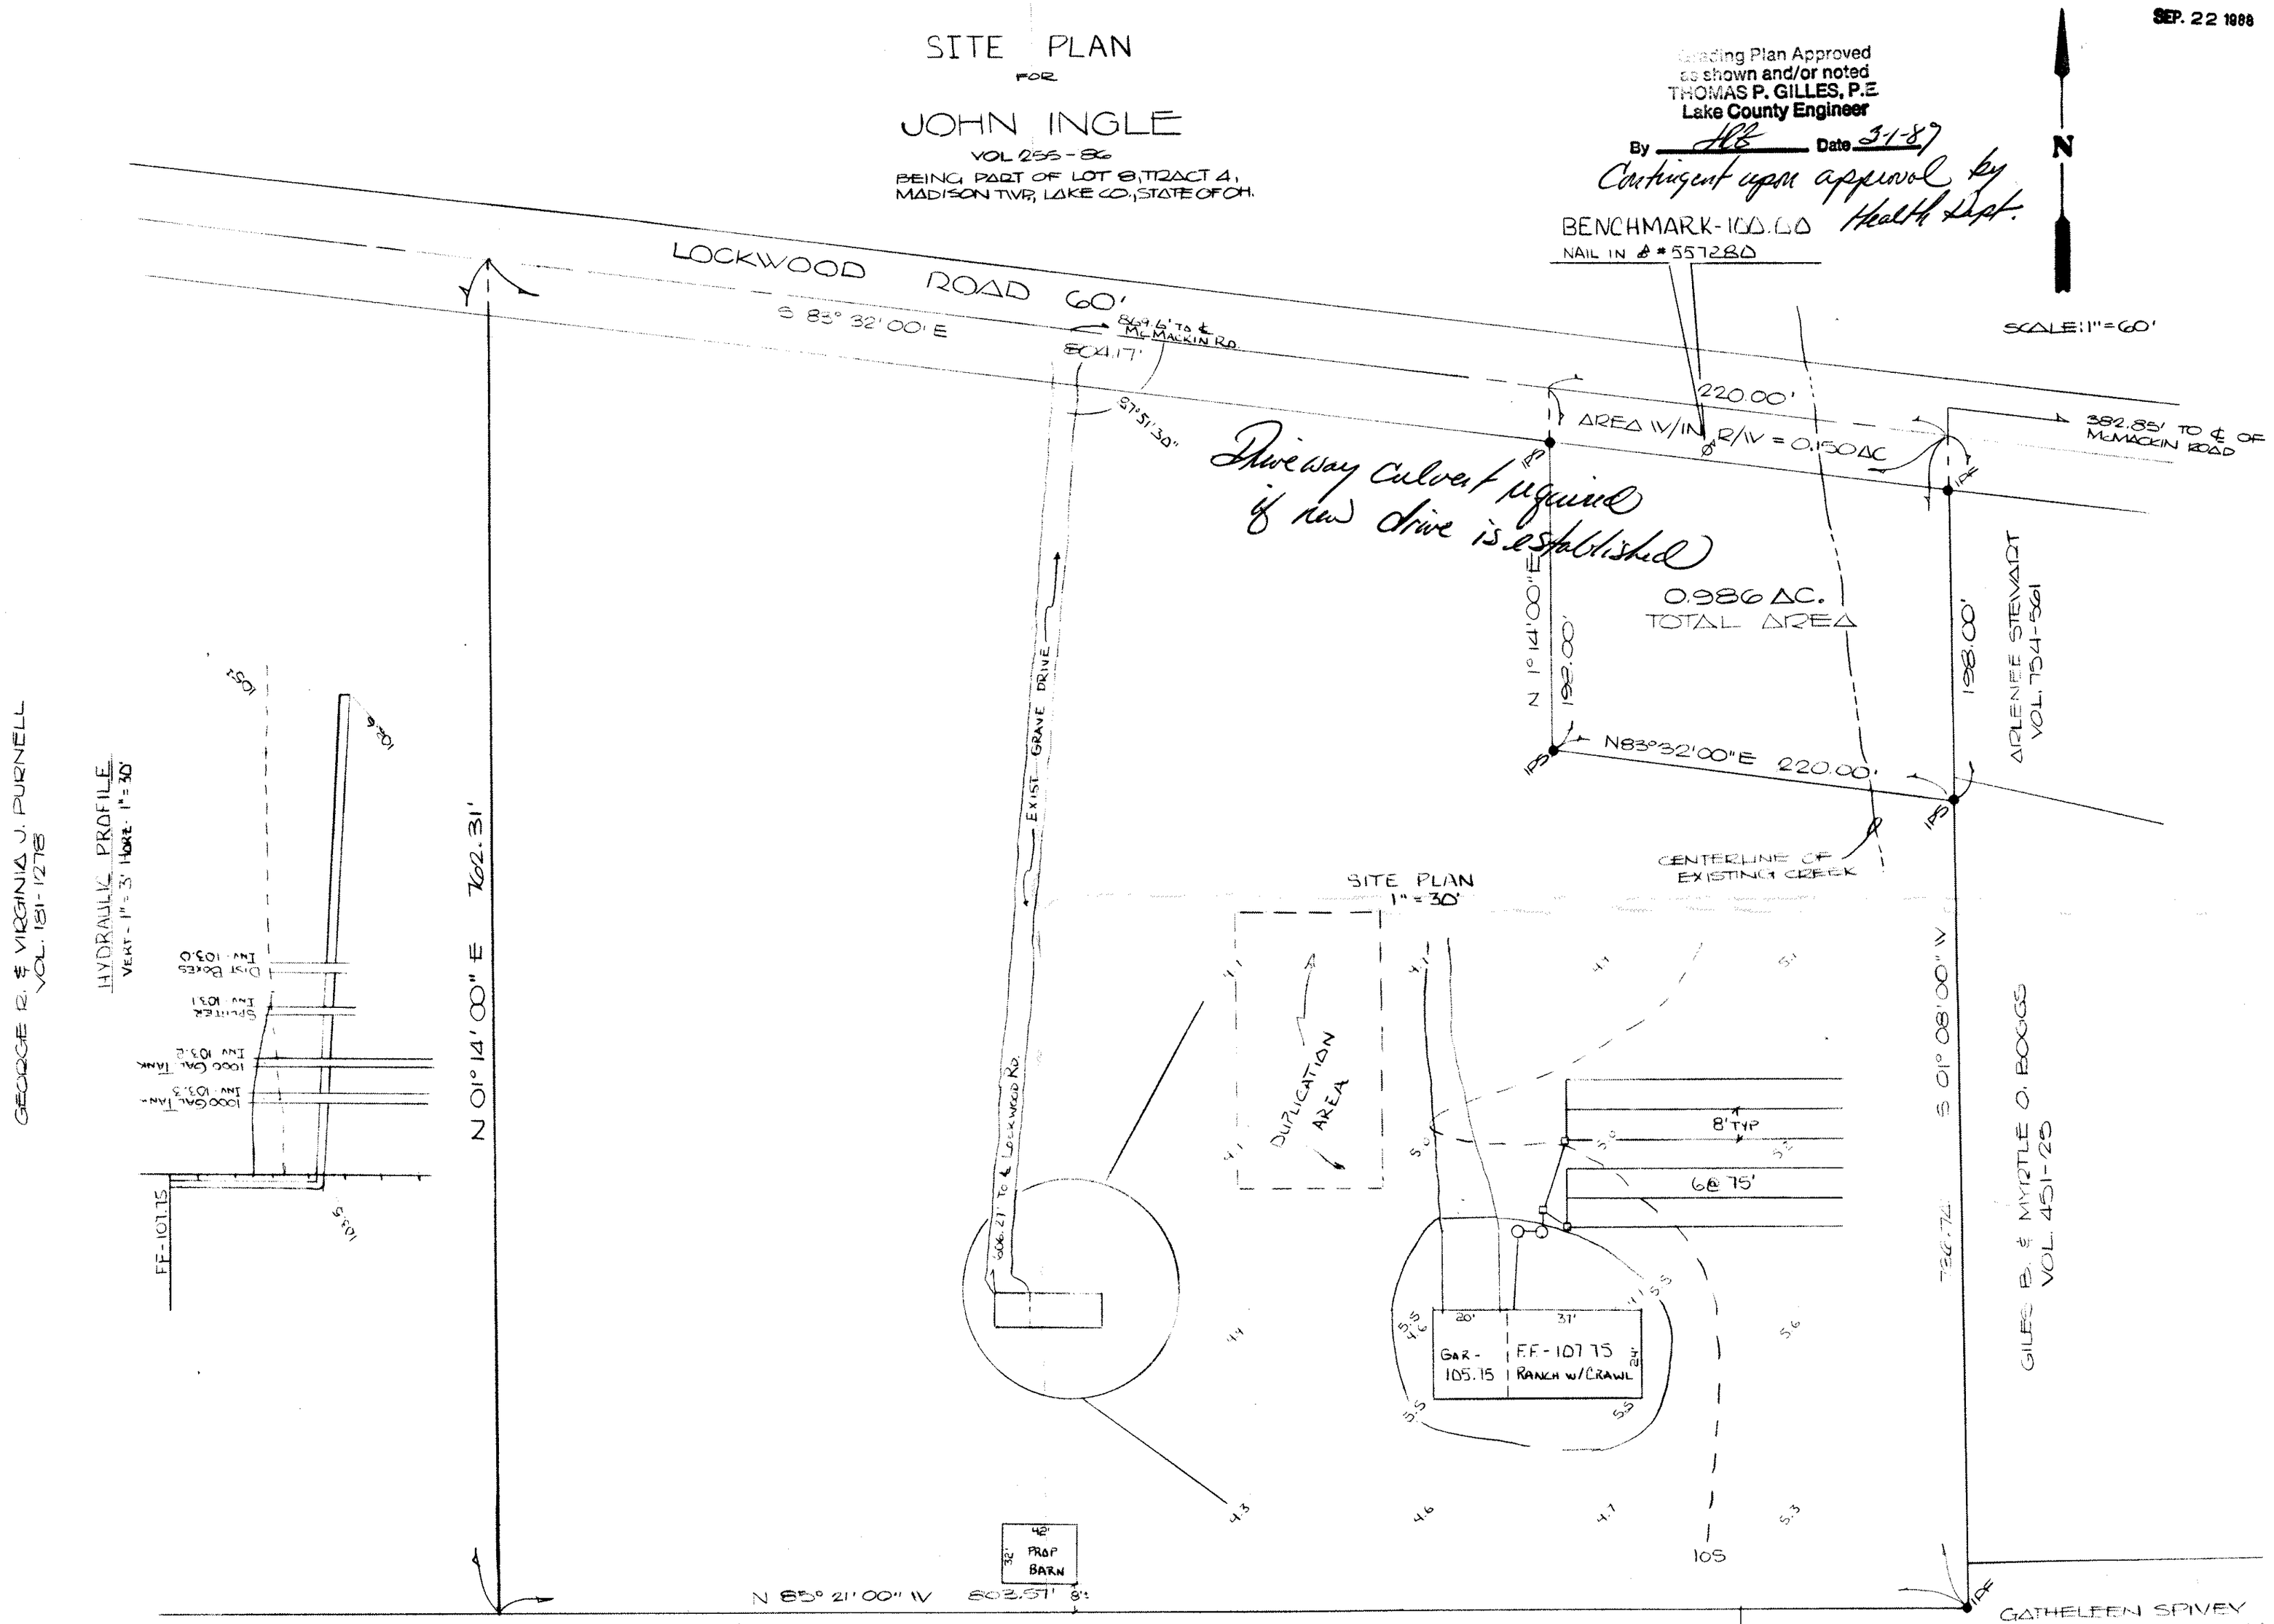

APPROVED
MADISON TWP. ZONING
Permit: 12391
Zoning Inspector: R. Saunter

THIS PLAT WAS PREPARED BY ME AND IS TRUE AND ACCURATE TO THE BEST OF MY KNOWLEDGE AND BELIEF.

THOMAS M. COFFMAN NO. 6857

STATE OF OHIO
THOMAS MARC COFFMAN
REGISTERED
6857
SURVEYOR

VILLAGE SURVEYING CO.
THOMAS M. COFFMAN, P.S.
212 THIRD ST. FAIRPORT HARBOR, OHIO. 44077
(216) 357-1359

REV. 9-19-88

DRUHING 44-232 71376