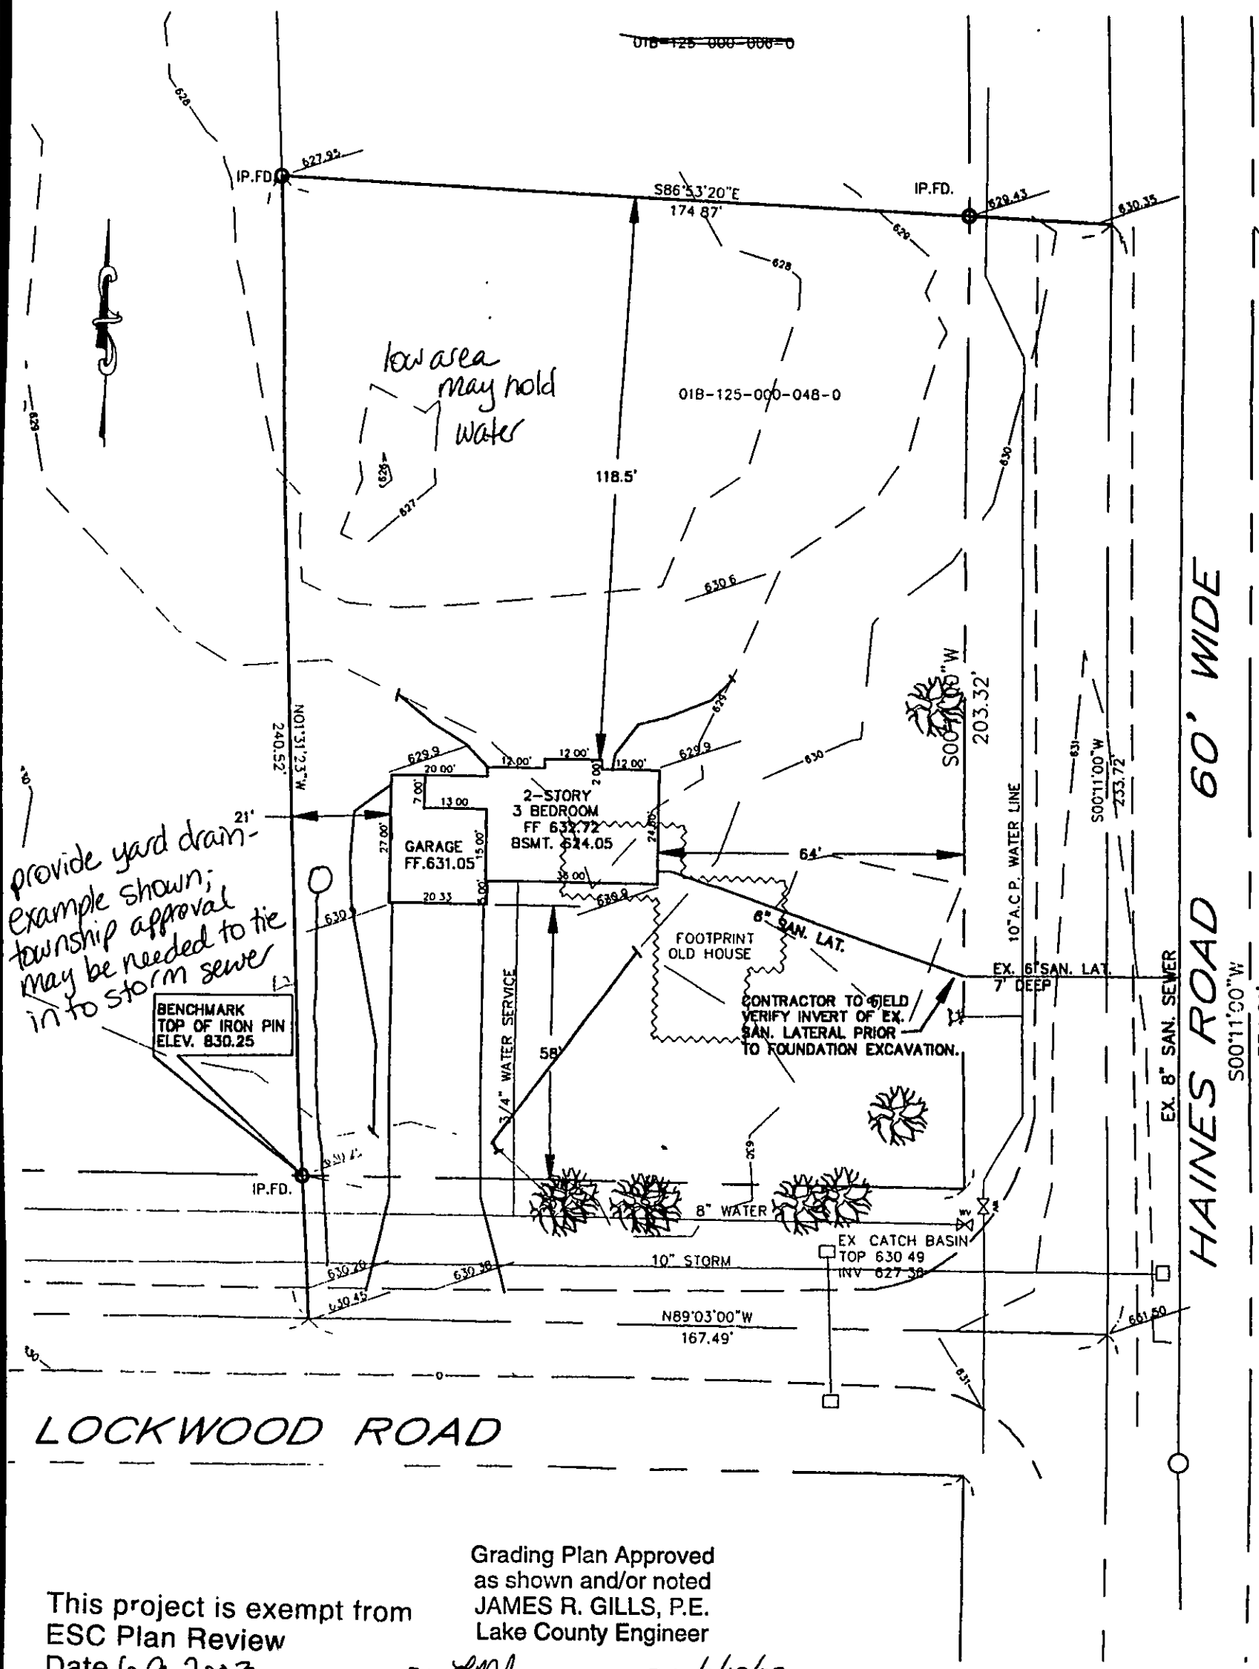

This project is exempt from
ESC Plan Review
Date 6-9-2003
Lake SWCD
PJb

Grading Plan Approved
as shown and/or noted
JAMES R. GILLS, P.E.
Lake County Engineer
By JRG Date 6/10/03

NOTES . 1 The Contractor Shall Verify the Following Before Starting: Finish Floor Elevations and House Size. Location and elevation of existing utility connections.

2. Contractor Shall Contact OUPS at least 2 Working Days prior to construction, 1-800-362-2764.

"I, the undersigned hereby certify that this topography, indicated by 1' contours and elevations shown hereon represents an actual field survey made by me in May 2003 and that the elevations were taken at appropriate intervals and that as of that date they existed as indicated hereon."

David A. Rapp 5/30/03
David A. Rapp Reg No. 23048

GRAPHIC SCALE

30 0 15 30 60 120

(IN FEET)
1 inch = 30 ft.

APPROVED
MADISON TOWNSHIP ZONING
DATE 6/6/03
BY DR 21382

COR Consultants, Inc.

23 S. Forest Street Geneva, Ohio 44041
440-466-8085

DATE: May, 2003
DRAWN BY: DAR
CHECKED BY: RMO
APPROVED BY: DAR
P.S. No. 7597

COLLEGE GREEN BUILDERS
PP# 1b-125-000-048-0
Site Plan