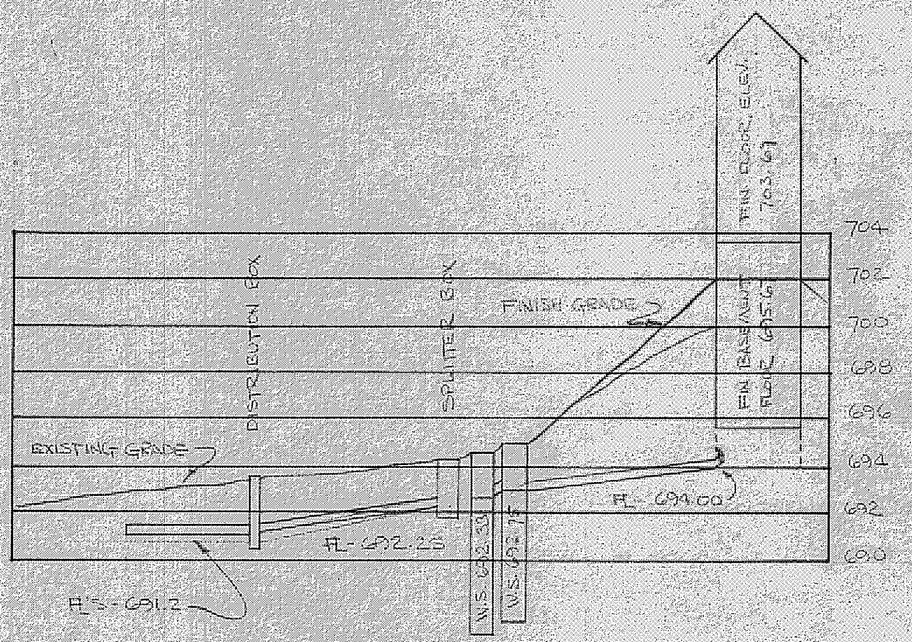

HYDRAULIC PROFILE

SCALE 1"=50' HORIZONTAL
1"=5' VERTICAL

LOW YIELD WATER FIXTURES REQUIRED ON ALL:
Shower Head
Toilet

Reviewed and Accepted
LAKE COUNTY GENERAL HEALTH DISTRICT
Date Jan 12 1981
JOEL LUCIA, R. S., M. P. H.
Health Commissioner
BY [signature] R.S.

SEWAGE DISPOSAL PERMIT MUST BE OBTAINED BY A LAKE COUNTY LICENSED INSTALLER BEFORE INSTALLATION IS STARTED.

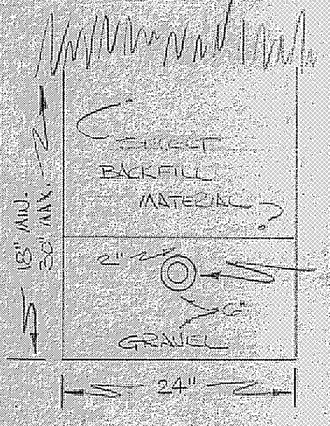

TRENCH DETAIL

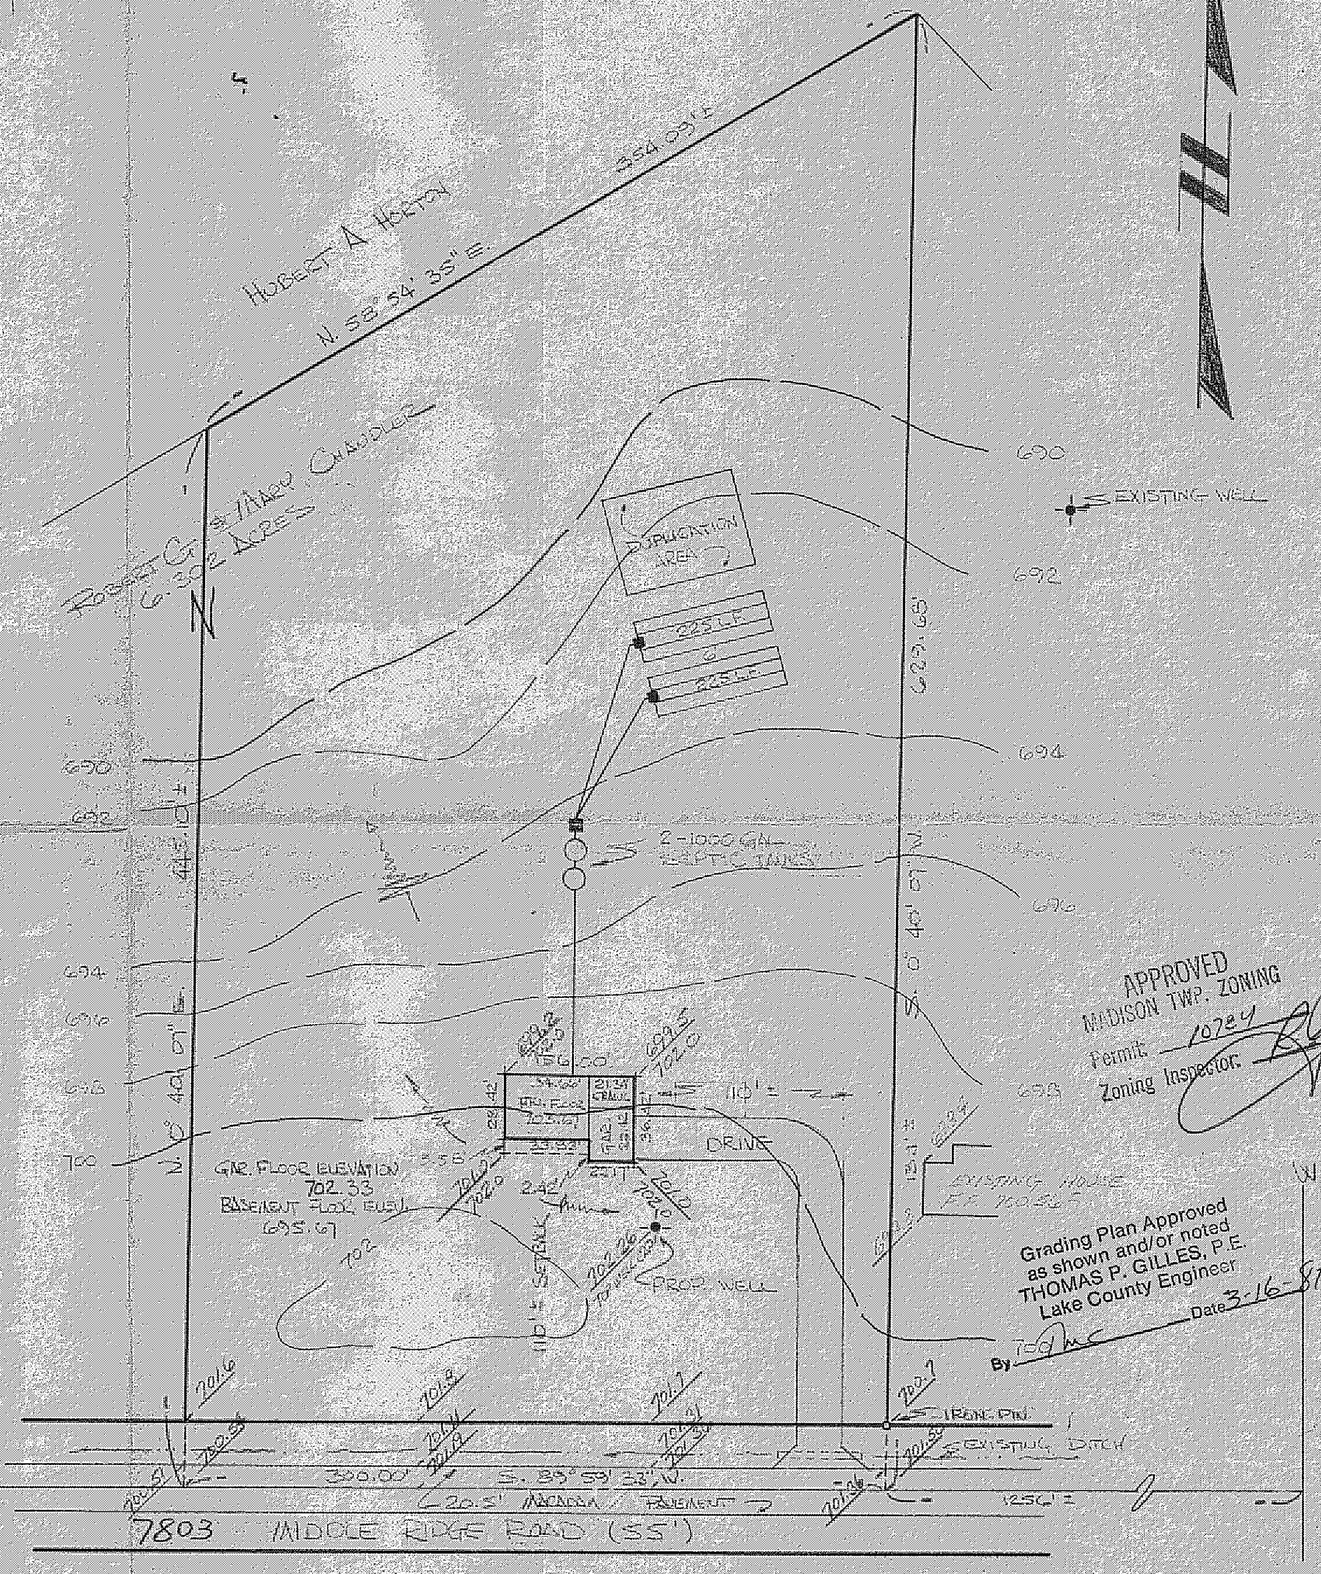

NOTE:
BENCHMARK - TOP OF WELL CAP
ELEVATION - 702.26

DESIGN CERTIFICATION

THIS PLAT WAS PREPARED BY ME AND IS CORRECT TO THE BEST OF MY KNOWLEDGE AND BELIEF

Richard J. Bloke

REG. SURVEYOR NO. PS-5244

AS BUILT CERTIFICATION

I HEREBY CERTIFY THAT THE CIRCLED GRADES ARE EXISTING FINISH GRADES CHECKED IN THE FIELD ON _____ AND THAT SURVEY IS CORRECT TO THE BEST OF MY KNOWLEDGE AND BELIEF

REG. SURVEYOR NO.

SITE PLAN
FOR
ROBERT CHANDLER
LOT # 1 TRACT # 1 MADISON TOWNSHIP, OHIO

DATE 1-9-81
SCALE 1"=50'
DRAWN BY JRZ
CH'K'D BY
F.B.# PG.

COLPETZER · WOODS
CONSULTANTS, INC.
MENTOR, OHIO 44060

SHEET 1
CONTRACT 81-10