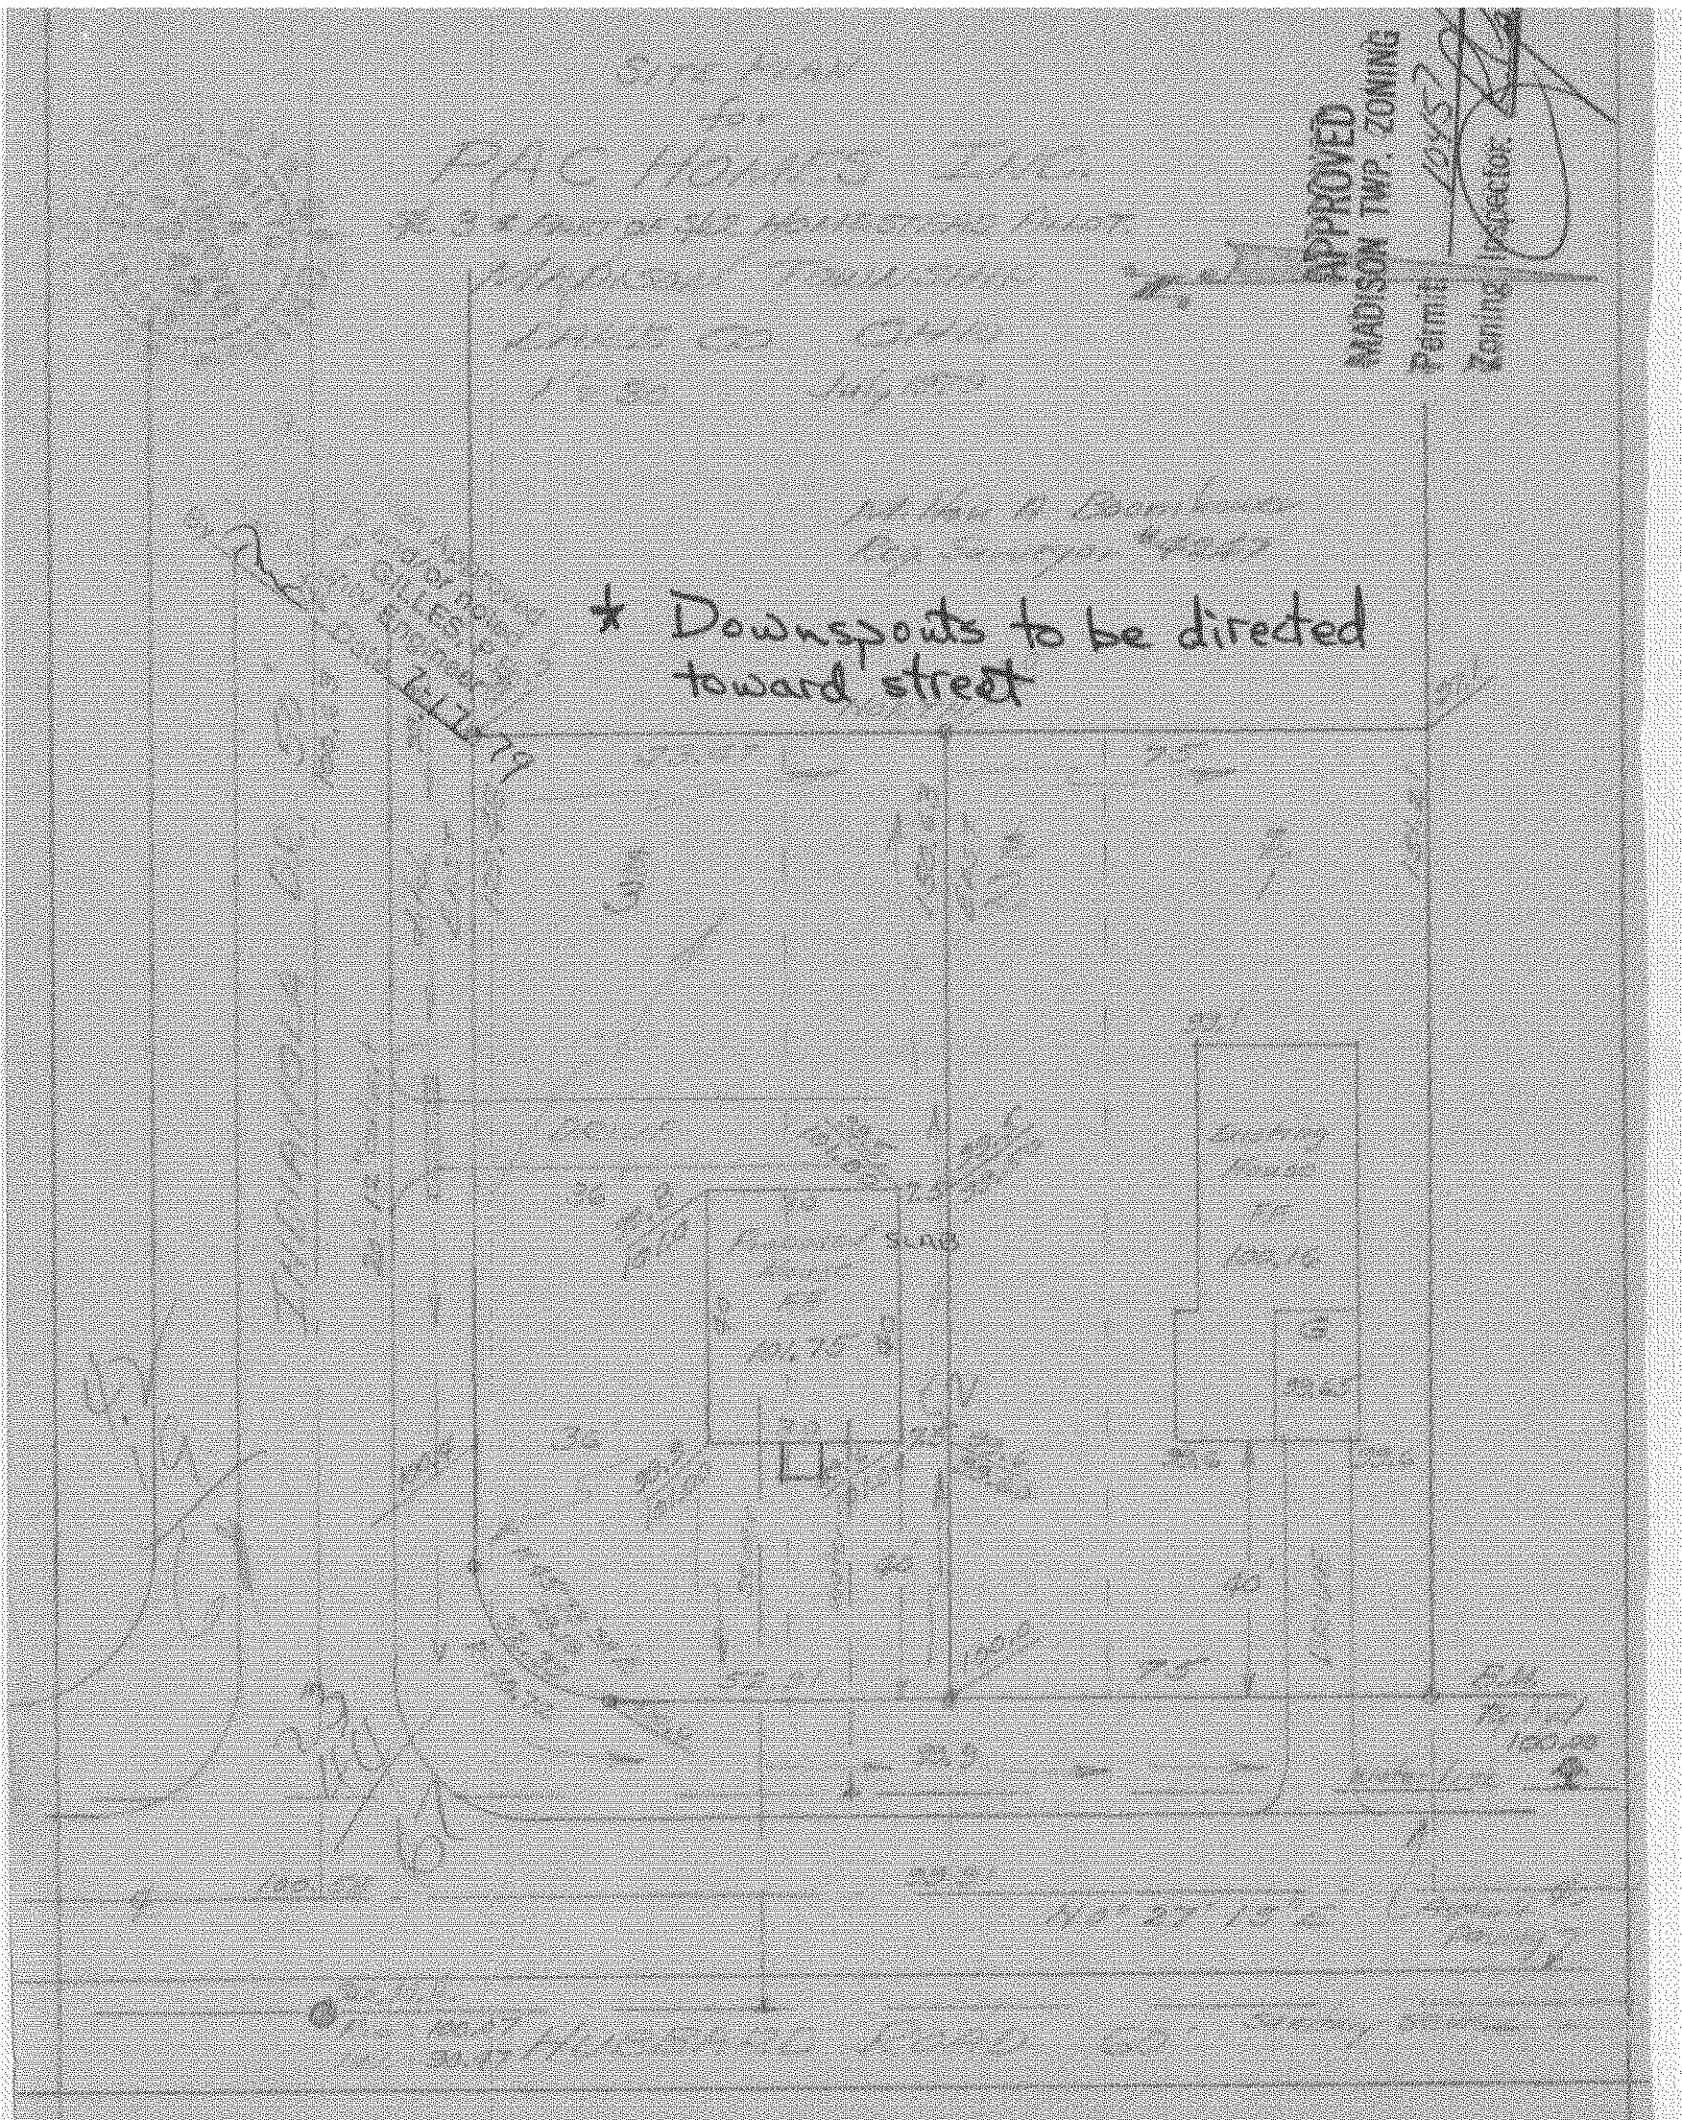

SITE PLAN
for
PAC HOMES INC.
APPROVED
MADISON TWP. ZONING
Permit
Zoning Inspector
* Downspouts to be directed toward street
SLAB