Grading Plan Approved
as shown and/or noted
THOMAS P. GILLES, P.E.
Lake County Engineer
By _____ Date 23 Jun 78

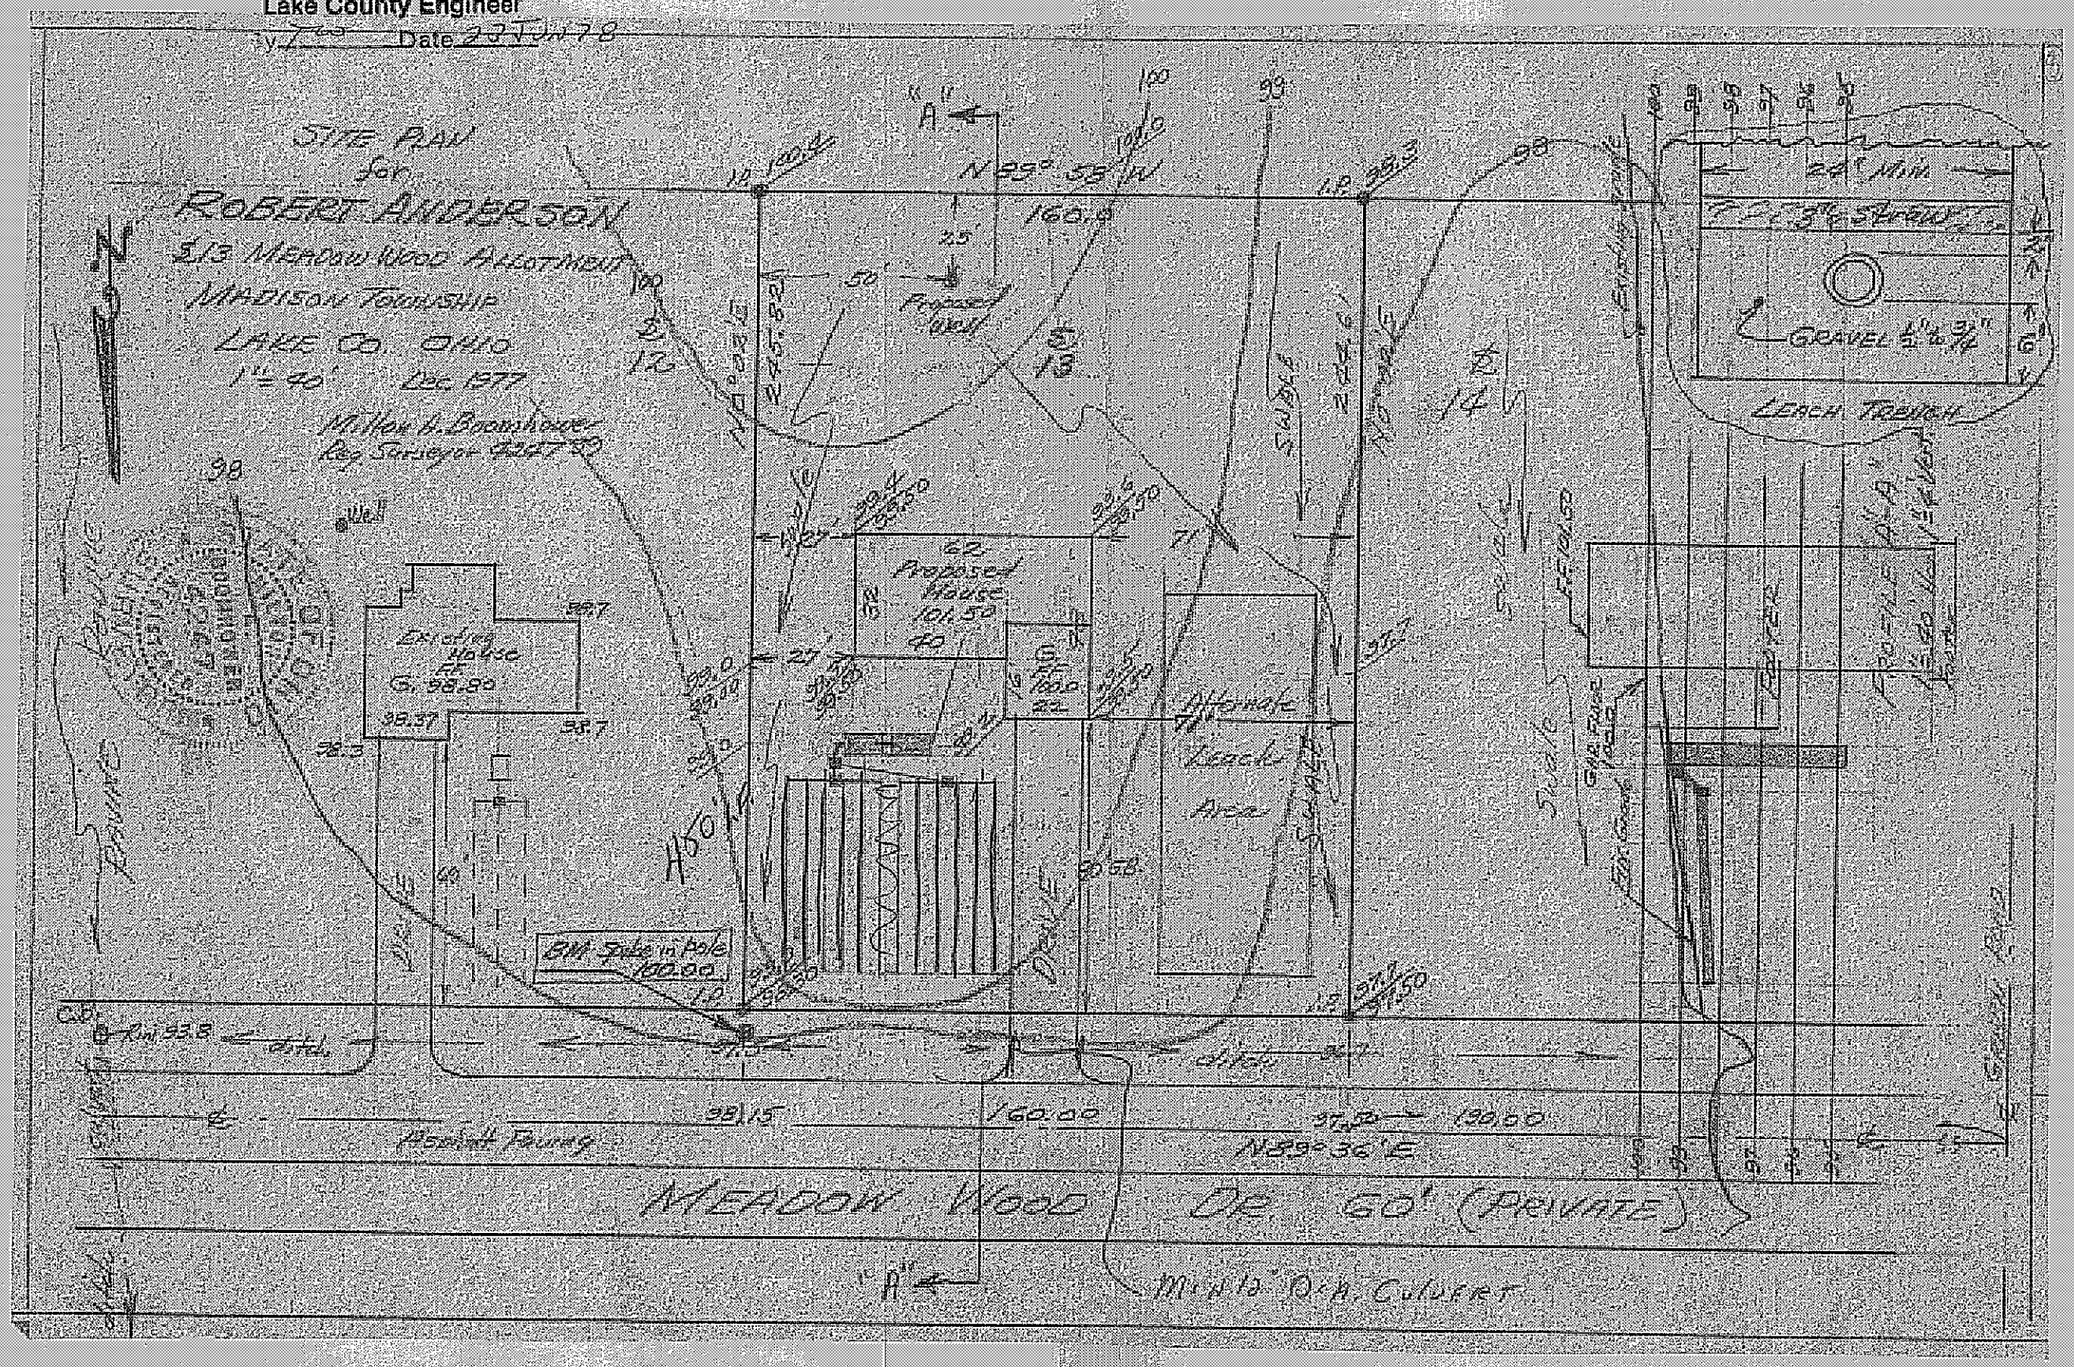

APPROVED
MADISON TWP. ZONING
Permit 10187
Zoning Inspector