SITE PLAN for RON WELSH

LOT 1117 CUMINGS BEACH PARK SUBDIVISION

TRACT 2 COWLES LOT, MADISON TWP. LAKE CO. OHIO

15 JUNE 1995 SCALE 1" = 10 ft.
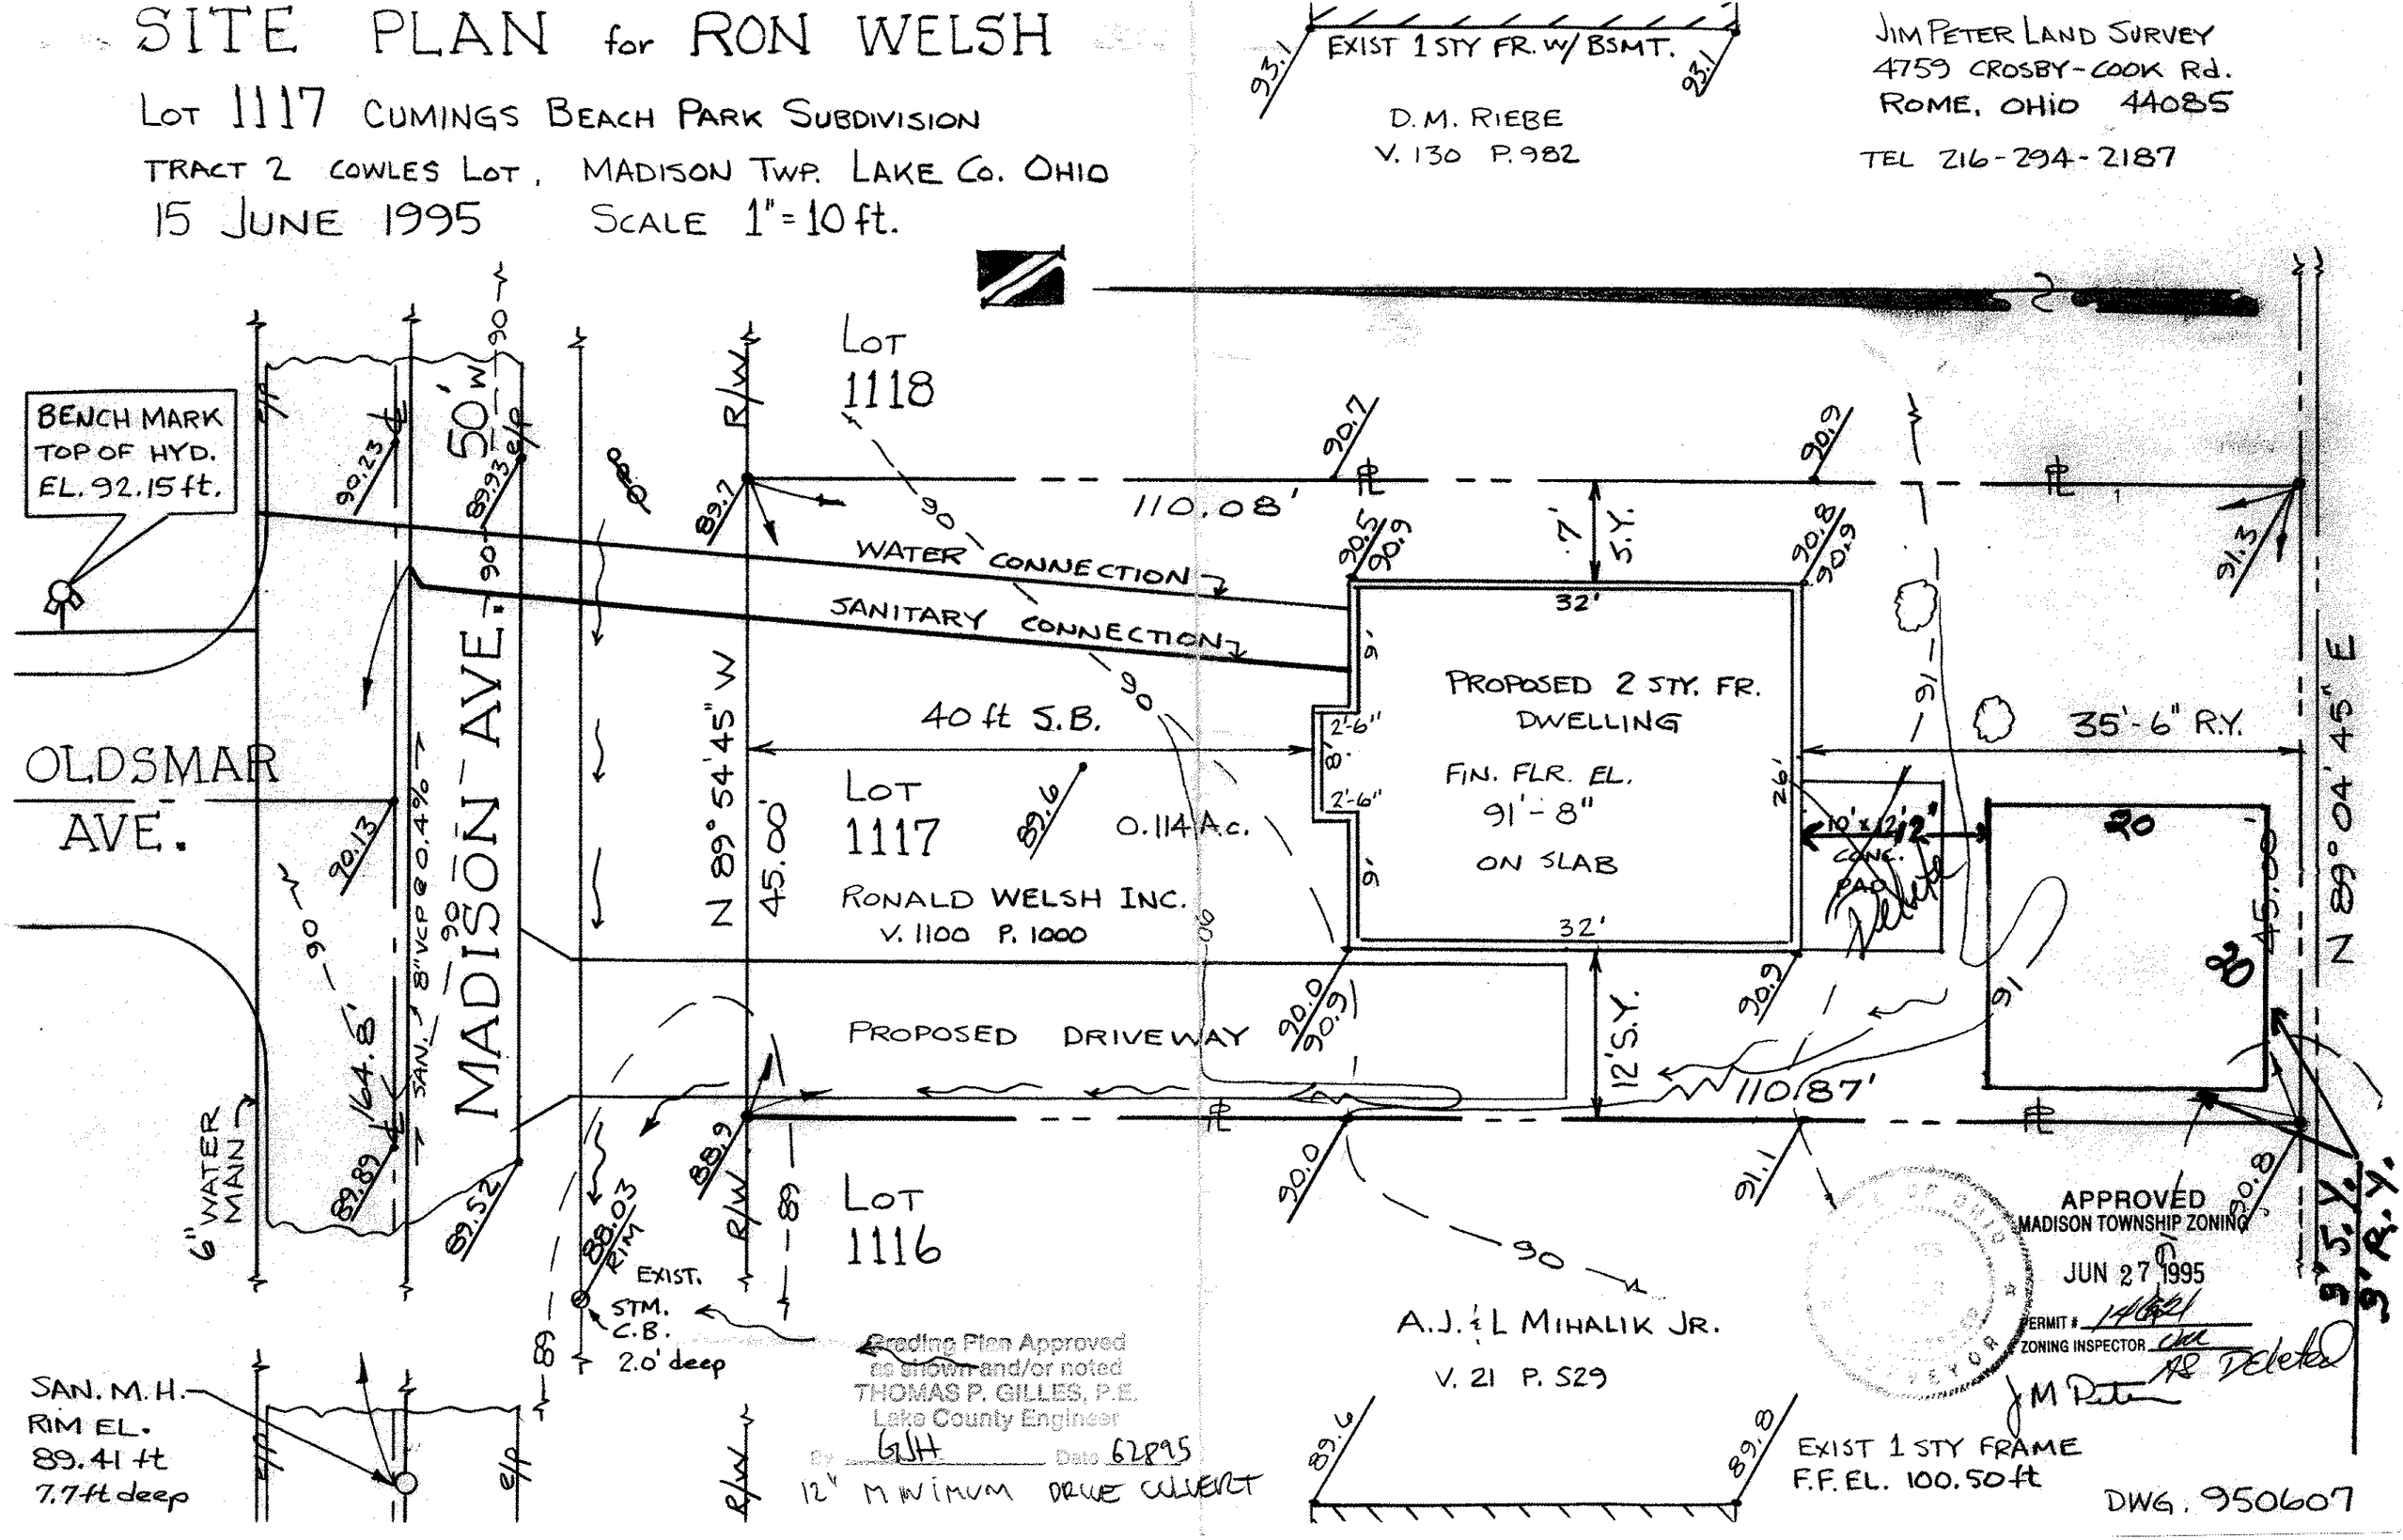
JIM PETER LAND SURVEY
4759 CROSBY-COOK Rd.
ROME, OHIO 44085
TEL 216-294-2187