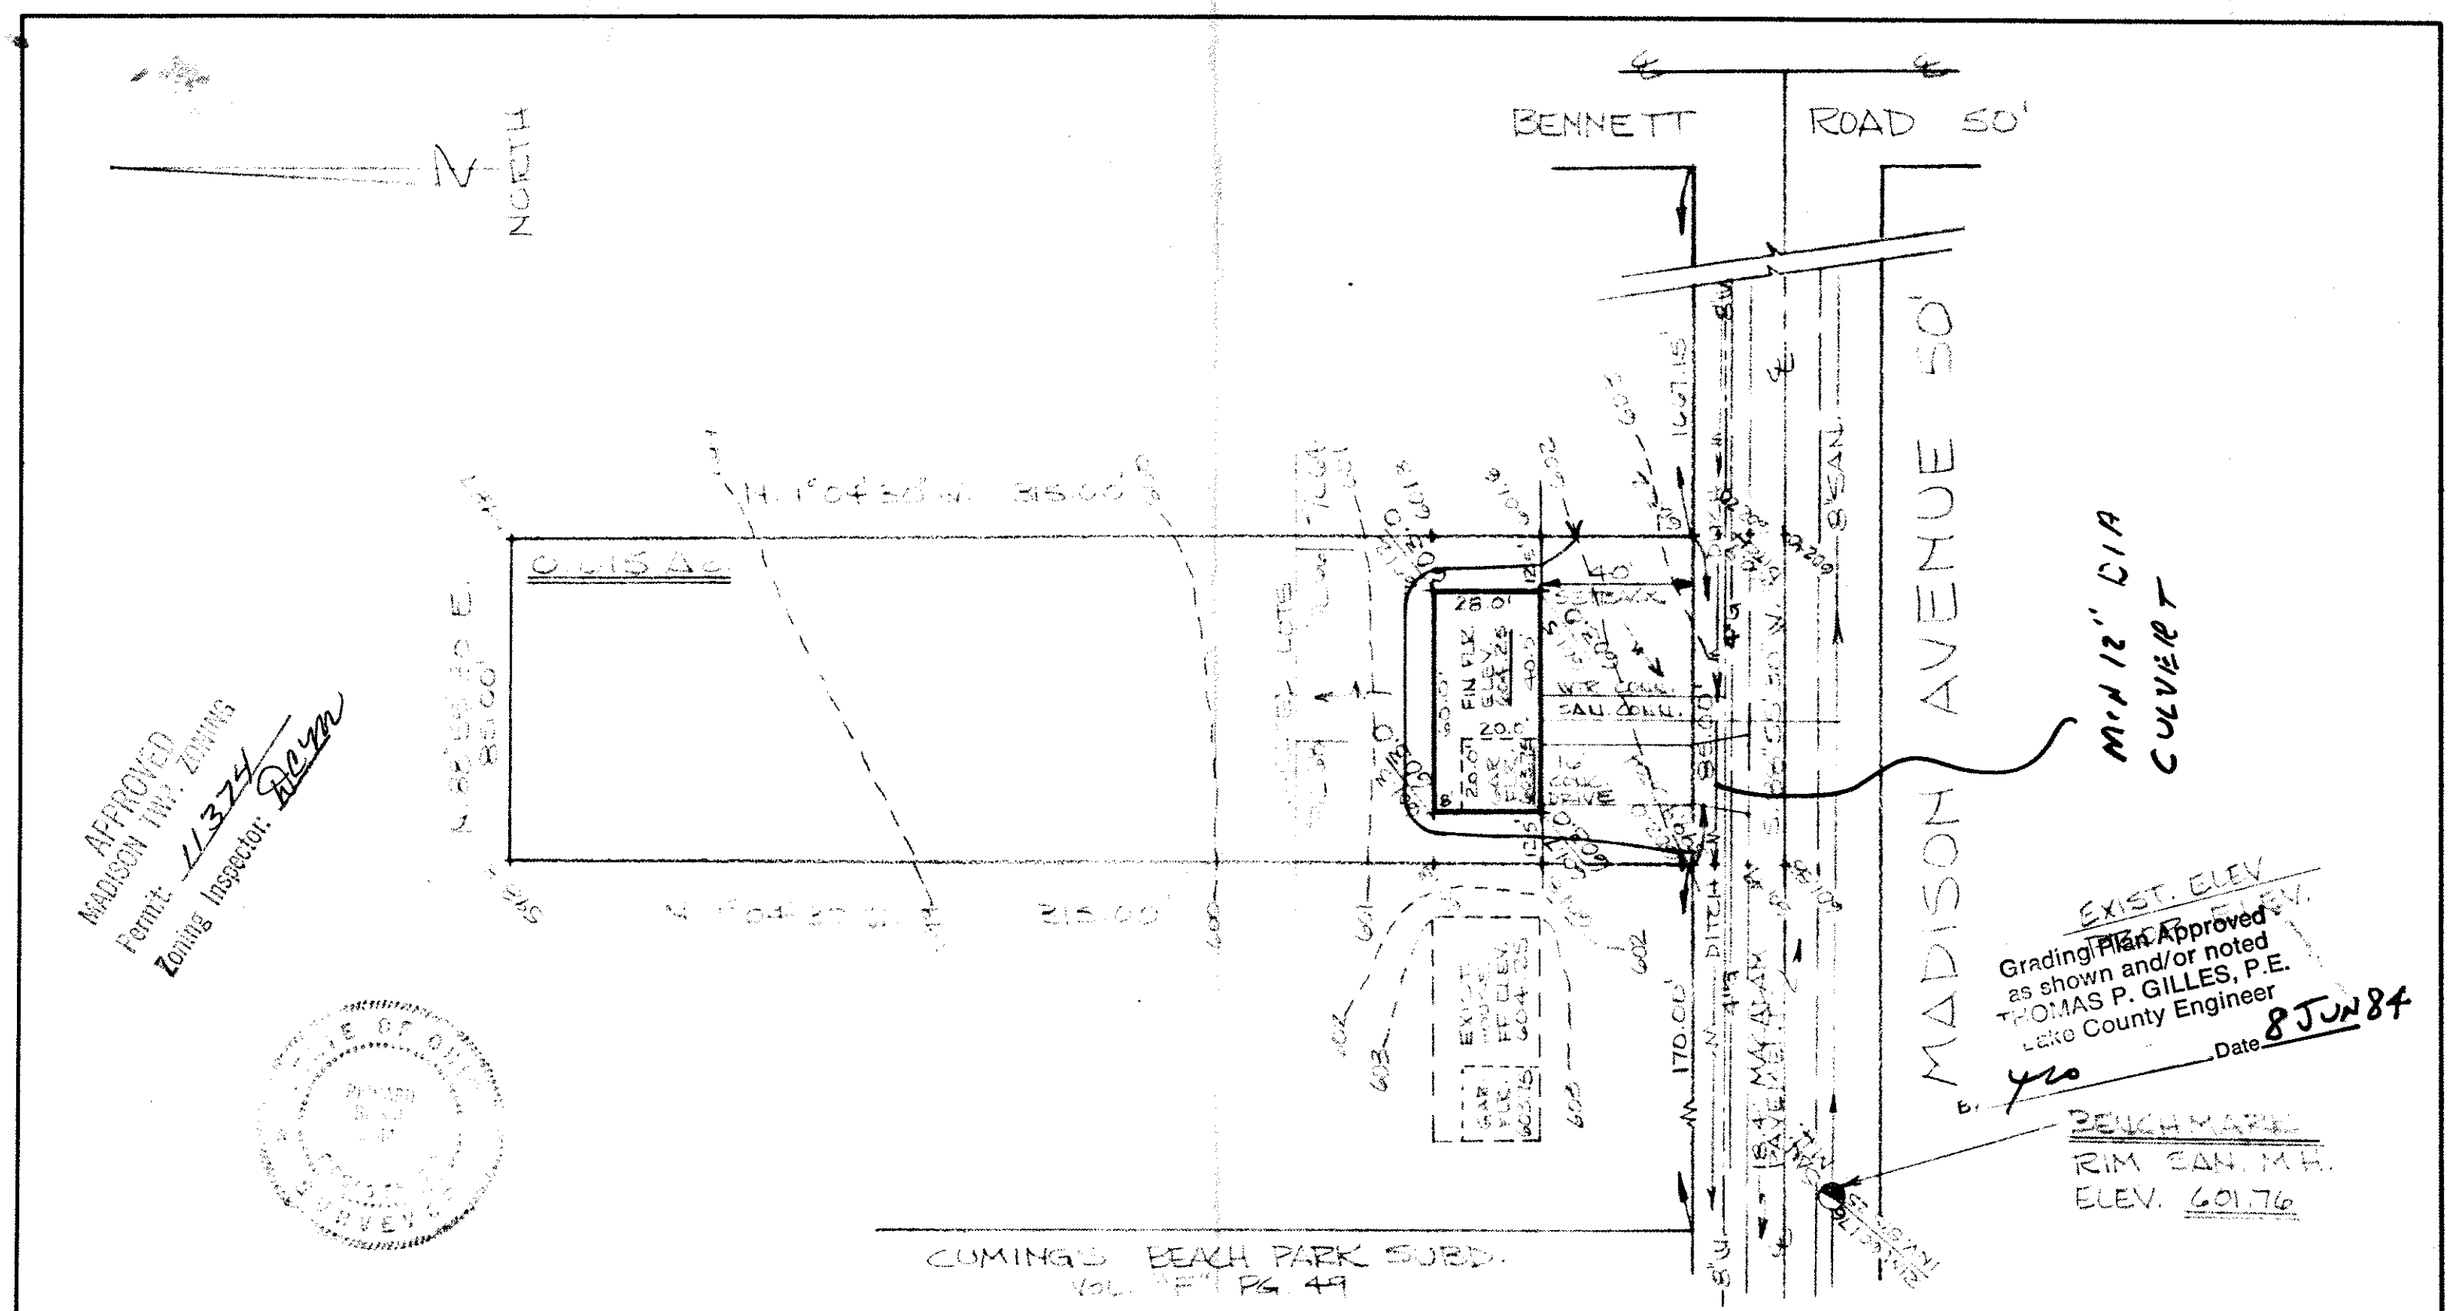

DESIGN CERTIFICATION	AS BUILT CERTIFICATION			
THIS PLAT WAS PREPARED BY ME, AND IS CORRECT TO THE BEST OF MY KNOWLEDGE AND BELIEF.	I HEREBY CERTIFY THAT THE CIRCLED GRADES ARE EXISTING FINISH GRADES CHECKED IN THE FIELD ON _____ AND THAT SURVEY IS CORRECT TO THE BEST OF MY KNOWLEDGE AND BELIEF.	**COLPETZER · WOODS** CONSULTANTS, INC. 9470 MENTOR AVENUE • MENTOR, OHIO 44060 • (216) 357-7569	DATE 5-11-84	SITE PLAN FOR JEFF CONSTRUCTION
REG. SURVEYOR NO. PS#5244	REG. SURVEYOR NO. _____		SCALE 1"=40'	BEING PART OF THE ELY LOT, TRACT NO. 2 AND PART OF VACATED MAPLE GROVE SUBD. MADISON TWP., LAKE COUNTY, OHIO
			DRWN BY RLS	
			CHKD BY RJB	
			JOB NO. 83-103	
			FB ____ PG ____	

43 32