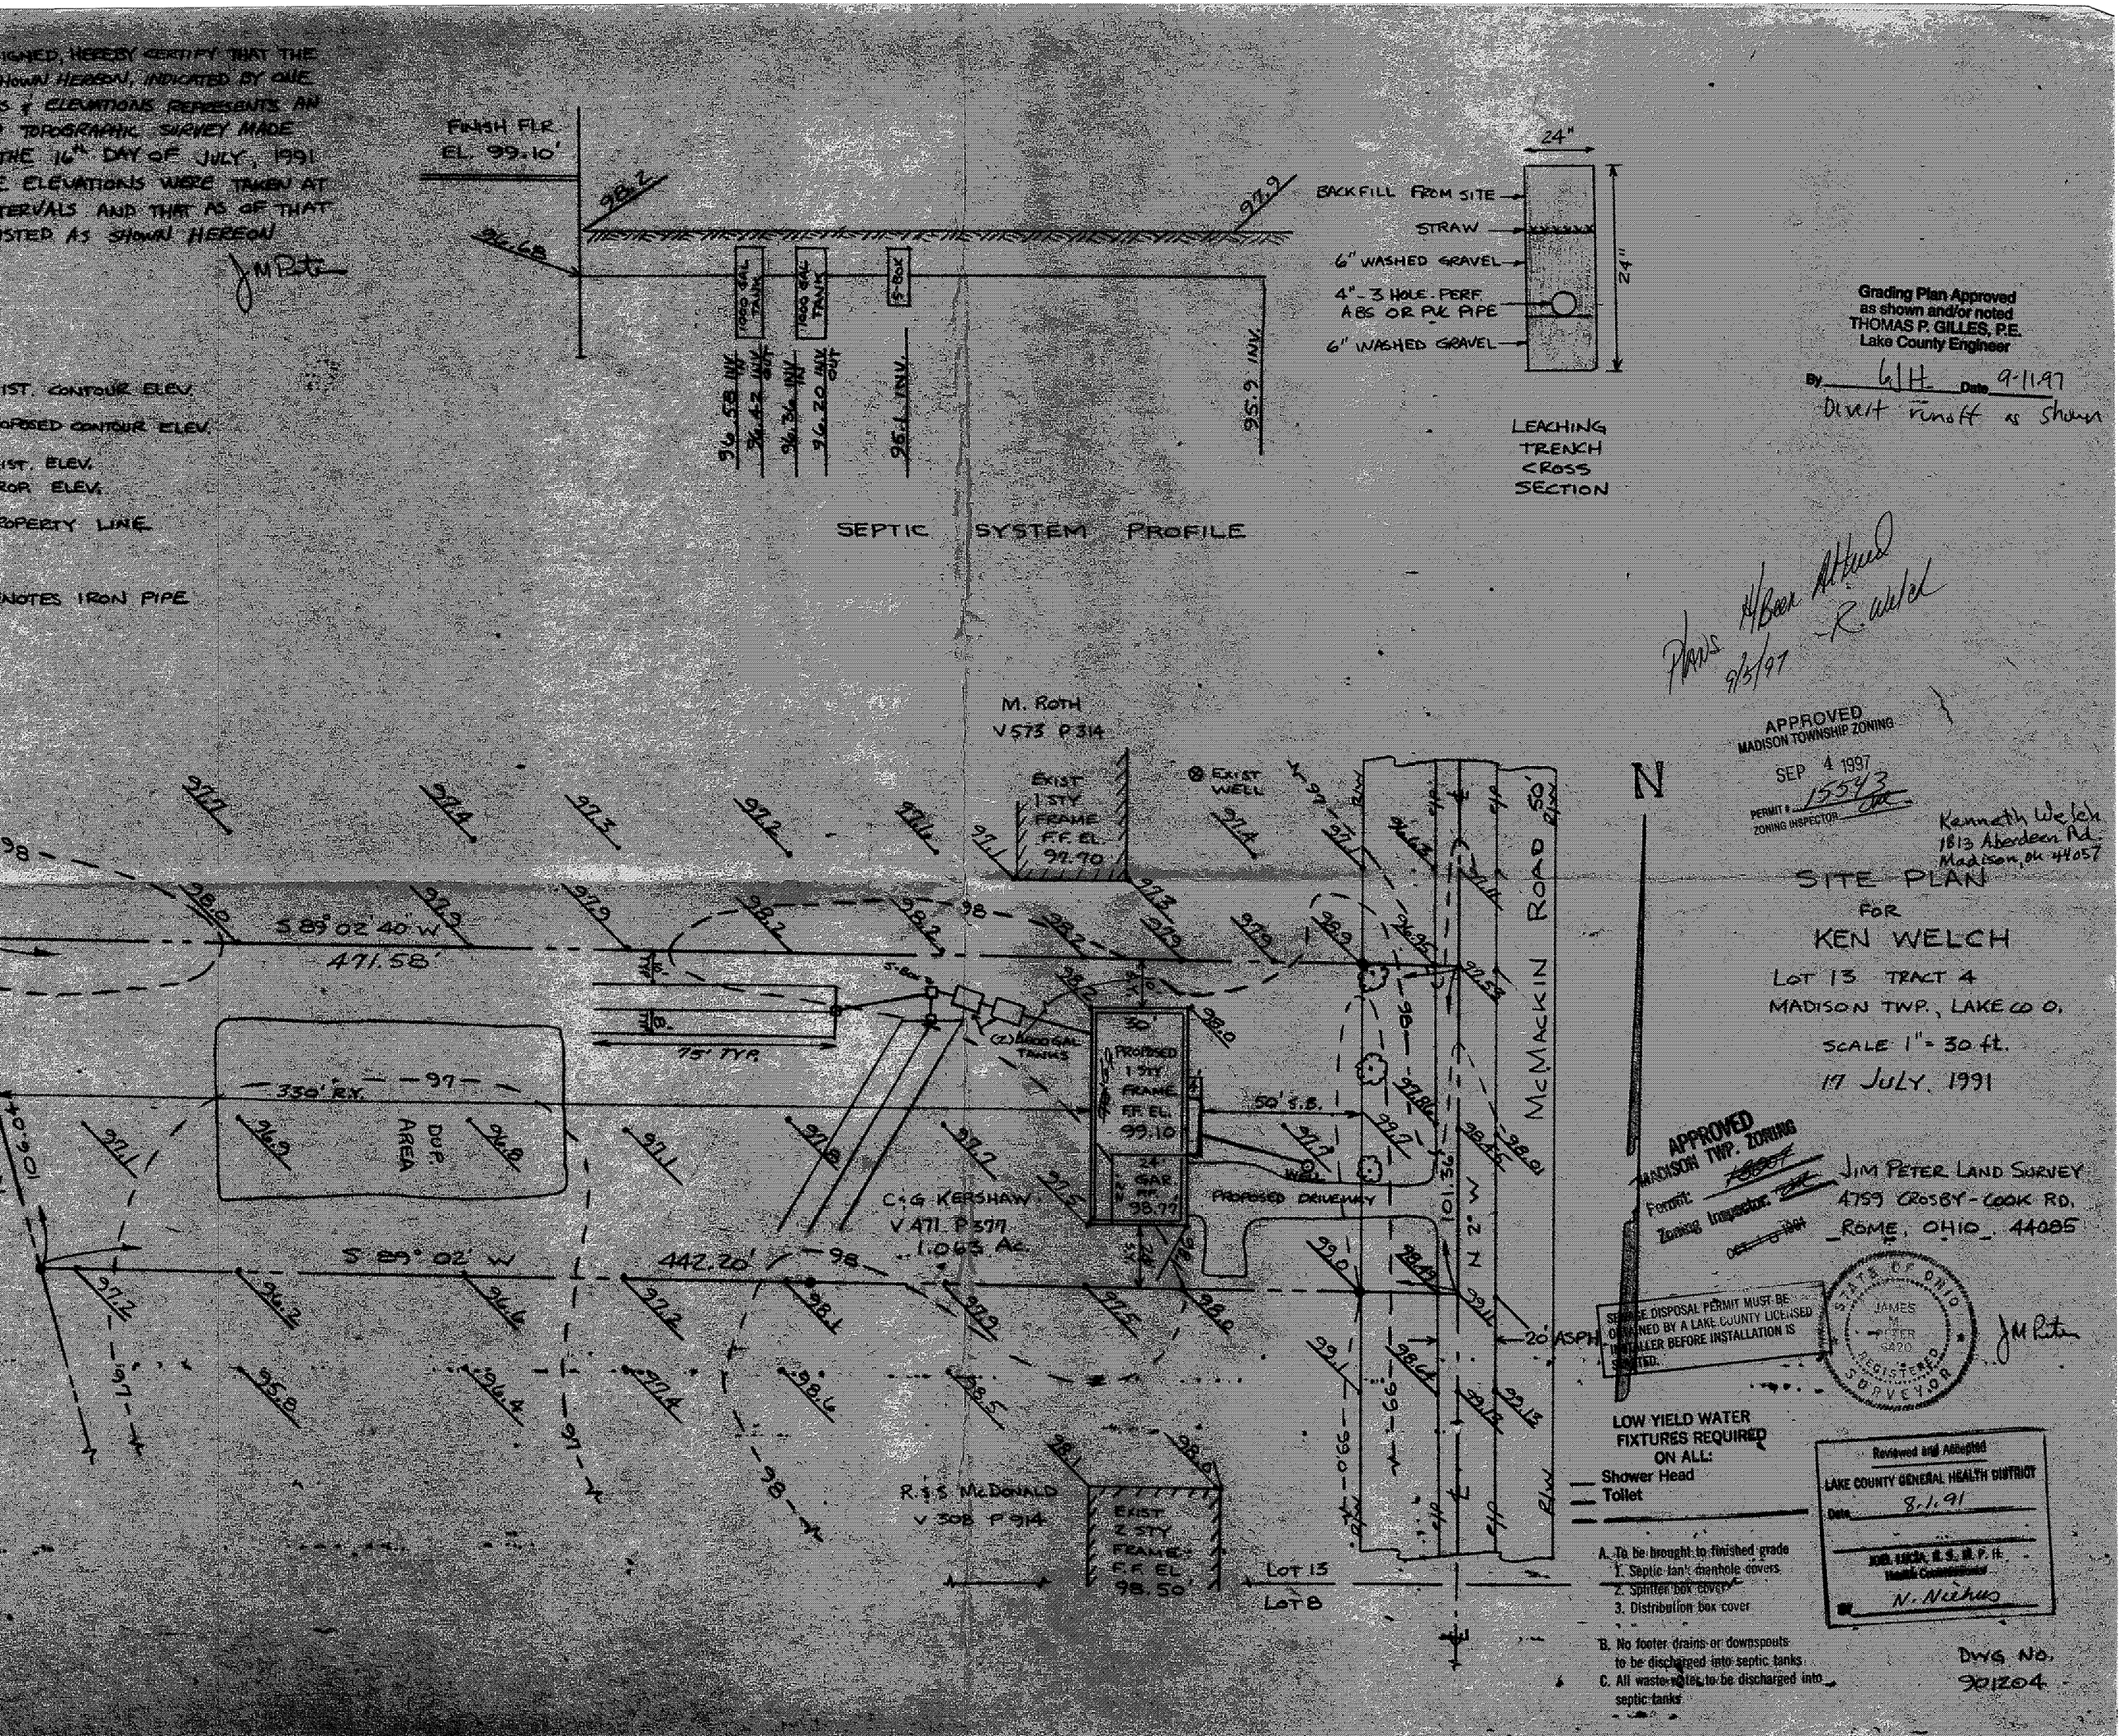

IGNED, HEREBY CERTIFY THAT THE
HOWN HEREON, INDICATED BY ONE
S & ELEVATIONS REPRESENTS AN
TOPOGRAPHIC SURVEY MADE
THE 16th DAY OF JULY, 1991
E ELEVATIONS WERE TAKEN AT
TERVALS AND THAT AS OF THAT
ISTED AS SHOWN HEREON
JM Peter
IST. CONTOUR ELEV.
OPOSED CONTOUR ELEV.
IST. ELEV.
ROP. ELEV.
ROPERTY LINE
NOTES IRON PIPE
FINISH FLR. EL. 99.10'
98.2
97.9
96.68
1000 GAL TANK
1000 GAL TANK
S-BOX
96.58 INV. IN
96.42 INV. OUT
96.36 INV. IN
96.20 INV. OUT
95.1 INV.
95.9 INV.
SEPTIC SYSTEM PROFILE
24"
BACKFILL FROM SITE
STRAW
6" WASHED GRAVEL
4"-3 HOLE PERF. ABS OR PVC PIPE
6" WASHED GRAVEL
24"
LEACHING TRENCH CROSS SECTION
Grading Plan Approved as shown and/or noted THOMAS P. GILLES, P.E. Lake County Engineer
By GJH Date 9-11-97
Divert runoff as shown
Plans H/Been Altered 9/5/97 - R. Welch
APPROVED MADISON TOWNSHIP ZONING
SEP 4 1997
PERMIT # 15543
ZONING INSPECTOR
Kenneth Welch
1813 Aberdeen Rd.
Madison, Oh 44057
SITE PLAN FOR KEN WELCH
LOT 13 TRACT 4
MADISON TWP., LAKE CO O.
SCALE 1" = 30 ft.
17 JULY, 1991
M. ROTH V573 P314
EXIST 1 STY FRAME F.F. EL. 97.70
EXIST WELL
N
S 89° 02' 40" W
471.58'
75' TYP.
330' R.Y.
DUP. AREA
(2) 1000 GAL TANKS
30' PROPOSED 1 STY FRAME F.F. EL. 99.10
24' GAR. F.F. 98.77
50' S.B.
PROPOSED DRIVEWAY
McMACKIN ROAD
C & G KERSHAW V471 P377 1.063 Ac.
S 89° 02' W
442.20'
101.36' N 2° W
20' ASPH
R & S McDONALD V308 P914
EXIST 2 STY FRAME F.F. EL. 98.50'
LOT 13
LOT 8
APPROVED MADISON TWP. ZONING
Permit:
Zoning Inspector:
JIM PETER LAND SURVEY
4759 CROSBY-COOK RD.
ROME, OHIO 44085
SEWAGE DISPOSAL PERMIT MUST BE OBTAINED BY A LAKE COUNTY LICENSED INSTALLER BEFORE INSTALLATION IS STARTED.
STATE OF OHIO JAMES M. PETER 5420 REGISTERED SURVEYOR
JM Peter
LOW YIELD WATER FIXTURES REQUIRED ON ALL:
Shower Head
Toilet
A. To be brought to finished grade
1. Septic tank manhole covers
2. Splitter box cover
3. Distribution box cover
B. No footer drains or downspouts to be discharged into septic tanks
C. All waste water to be discharged into septic tanks
Reviewed and Accepted
LAKE COUNTY GENERAL HEALTH DISTRICT
Date 8.1.91
N. Niehus
DWG NO. 901204