Madison Township
RECEIVED JUL 2 4 1987

SITE PLAN FOR ED MAYEDA

BEING SUBLOT No. 3 IN THE MEADOW WOOD ALLOTMENT SUBDIVISION AS RECORDED IN VOL. M PAGE 5, OF LAKE COUNTY PLAT RECORDS, AND LOCATED IN LOT No. 13, TRACT 3, IN . . . . .

MADISON TOWNSHIP LAKE COUNTY OHIO

MARCH 1987 SCALE - 1" = 30'

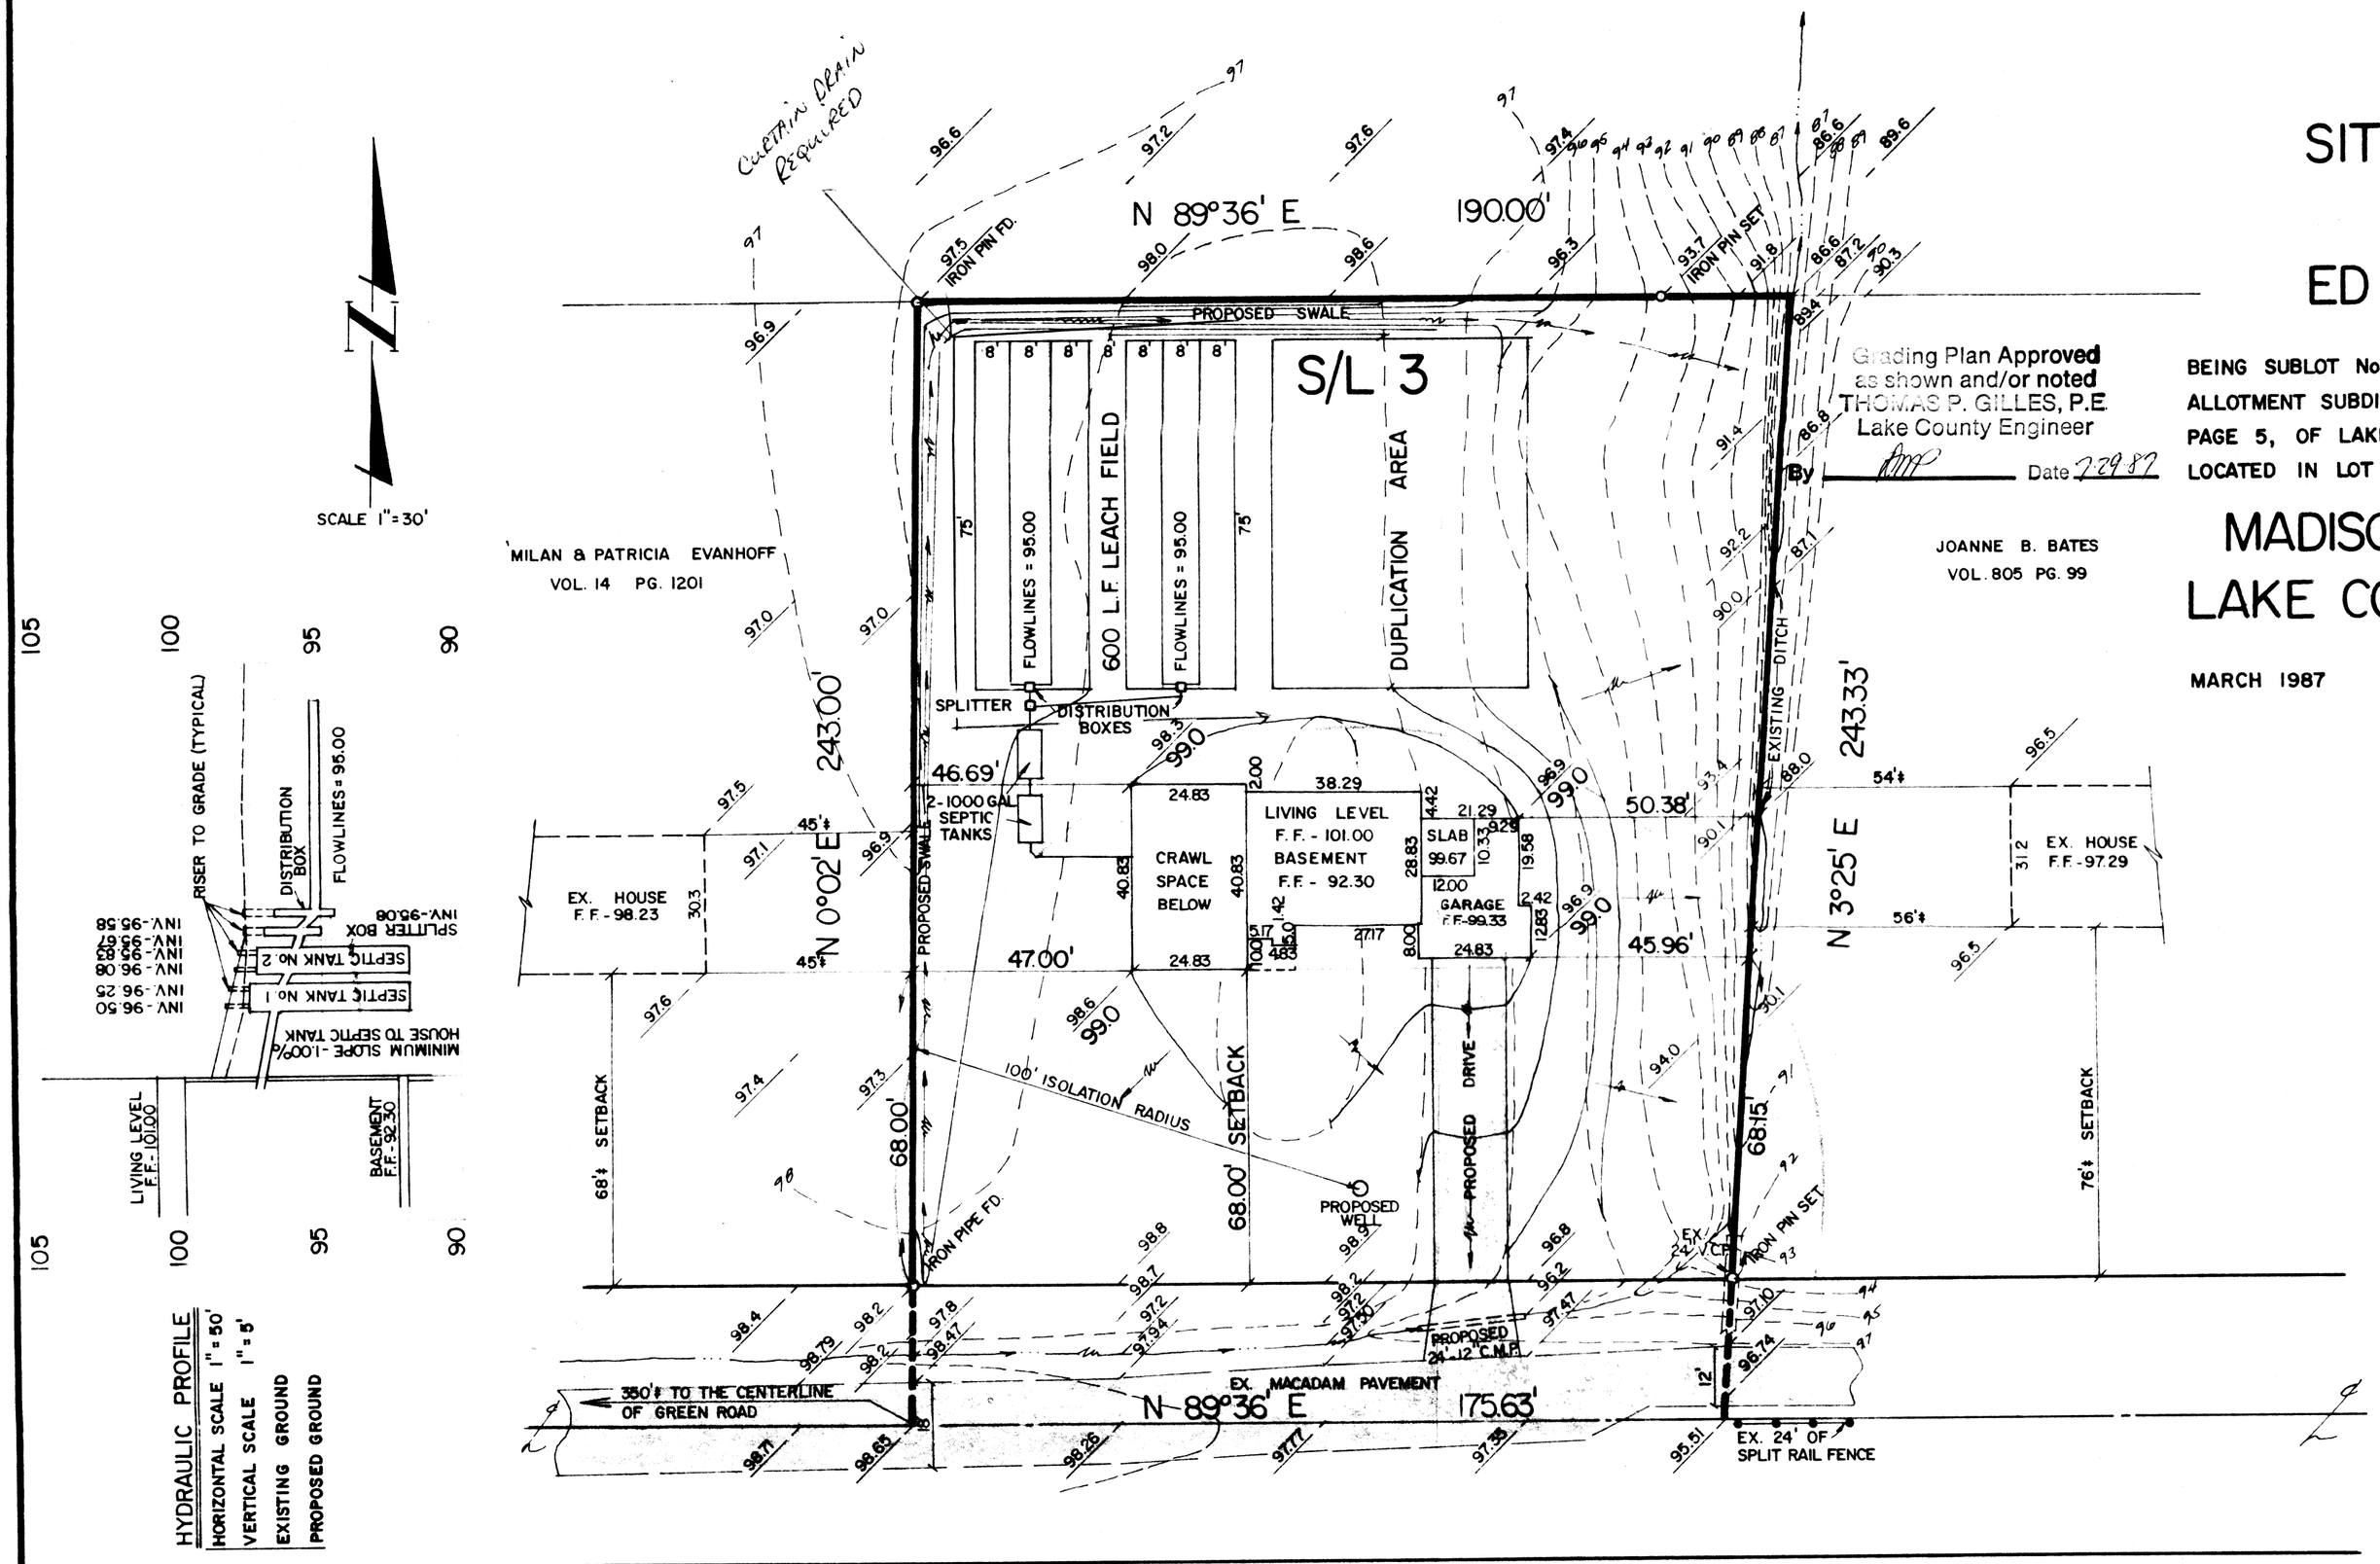

Grading Plan Approved as shown and/or noted
THOMAS P. GILLES, P.E.
Lake County Engineer
By [signature] Date 7-29-87

LOW YIELD WATER FIXTURES REQUIRED ON ALL:
___ Shower Head
___ Toilet

Reviewed and Accepted
LAKE COUNTY GENERAL HEALTH DISTRICT
Date MARCH 27, 1987
JOEL LUCIA, R. S., M. P. H.
Health Commissioner
BY [signature]

A. To be brought to finished grade
1. Septic tank manhole covers
2. Splitter box cover
3. Distribution box cover
4. Vent Pipes
B. No footer drains or downspouts to be discharged into septic tanks
C. All waste water to be discharged into septic tanks

SEWAGE DISPOSAL PERMIT MUST BE OBTAINED BY A LAKE COUNTY LICENSED INSTALLER BEFORE INSTALLATION IS STARTED.

MEADOW WOOD DRIVE 60'

APPROVED
MADISON TWP. ZONING
Permit: 12129
Zoning Inspector: [signature]

BENCHMARK (T.B.M.) - P.K. NAIL IN NORTH SIDE OF POWER POLE No. 13MH018-821334 SOUTH SIDE OF MEADOW WOOD DRIVE, OPPOSITE OF THE WEST PROPERTY LINE.
ASSUMED ELEVATION = 100.00

KERR SURVEYING
P.O. BOX 156
THOMPSON, OHIO 44086
PHONE: 298-3920

CERTIFICATION
I HEREBY CERTIFY THAT THIS PLAN WAS PREPARED BY ME AND IS CORRECT TO THE BEST OF MY KNOWLEDGE.
[signature] 6-23
ROY M. KERR OHIO REG. SURVEYOR No. 6753