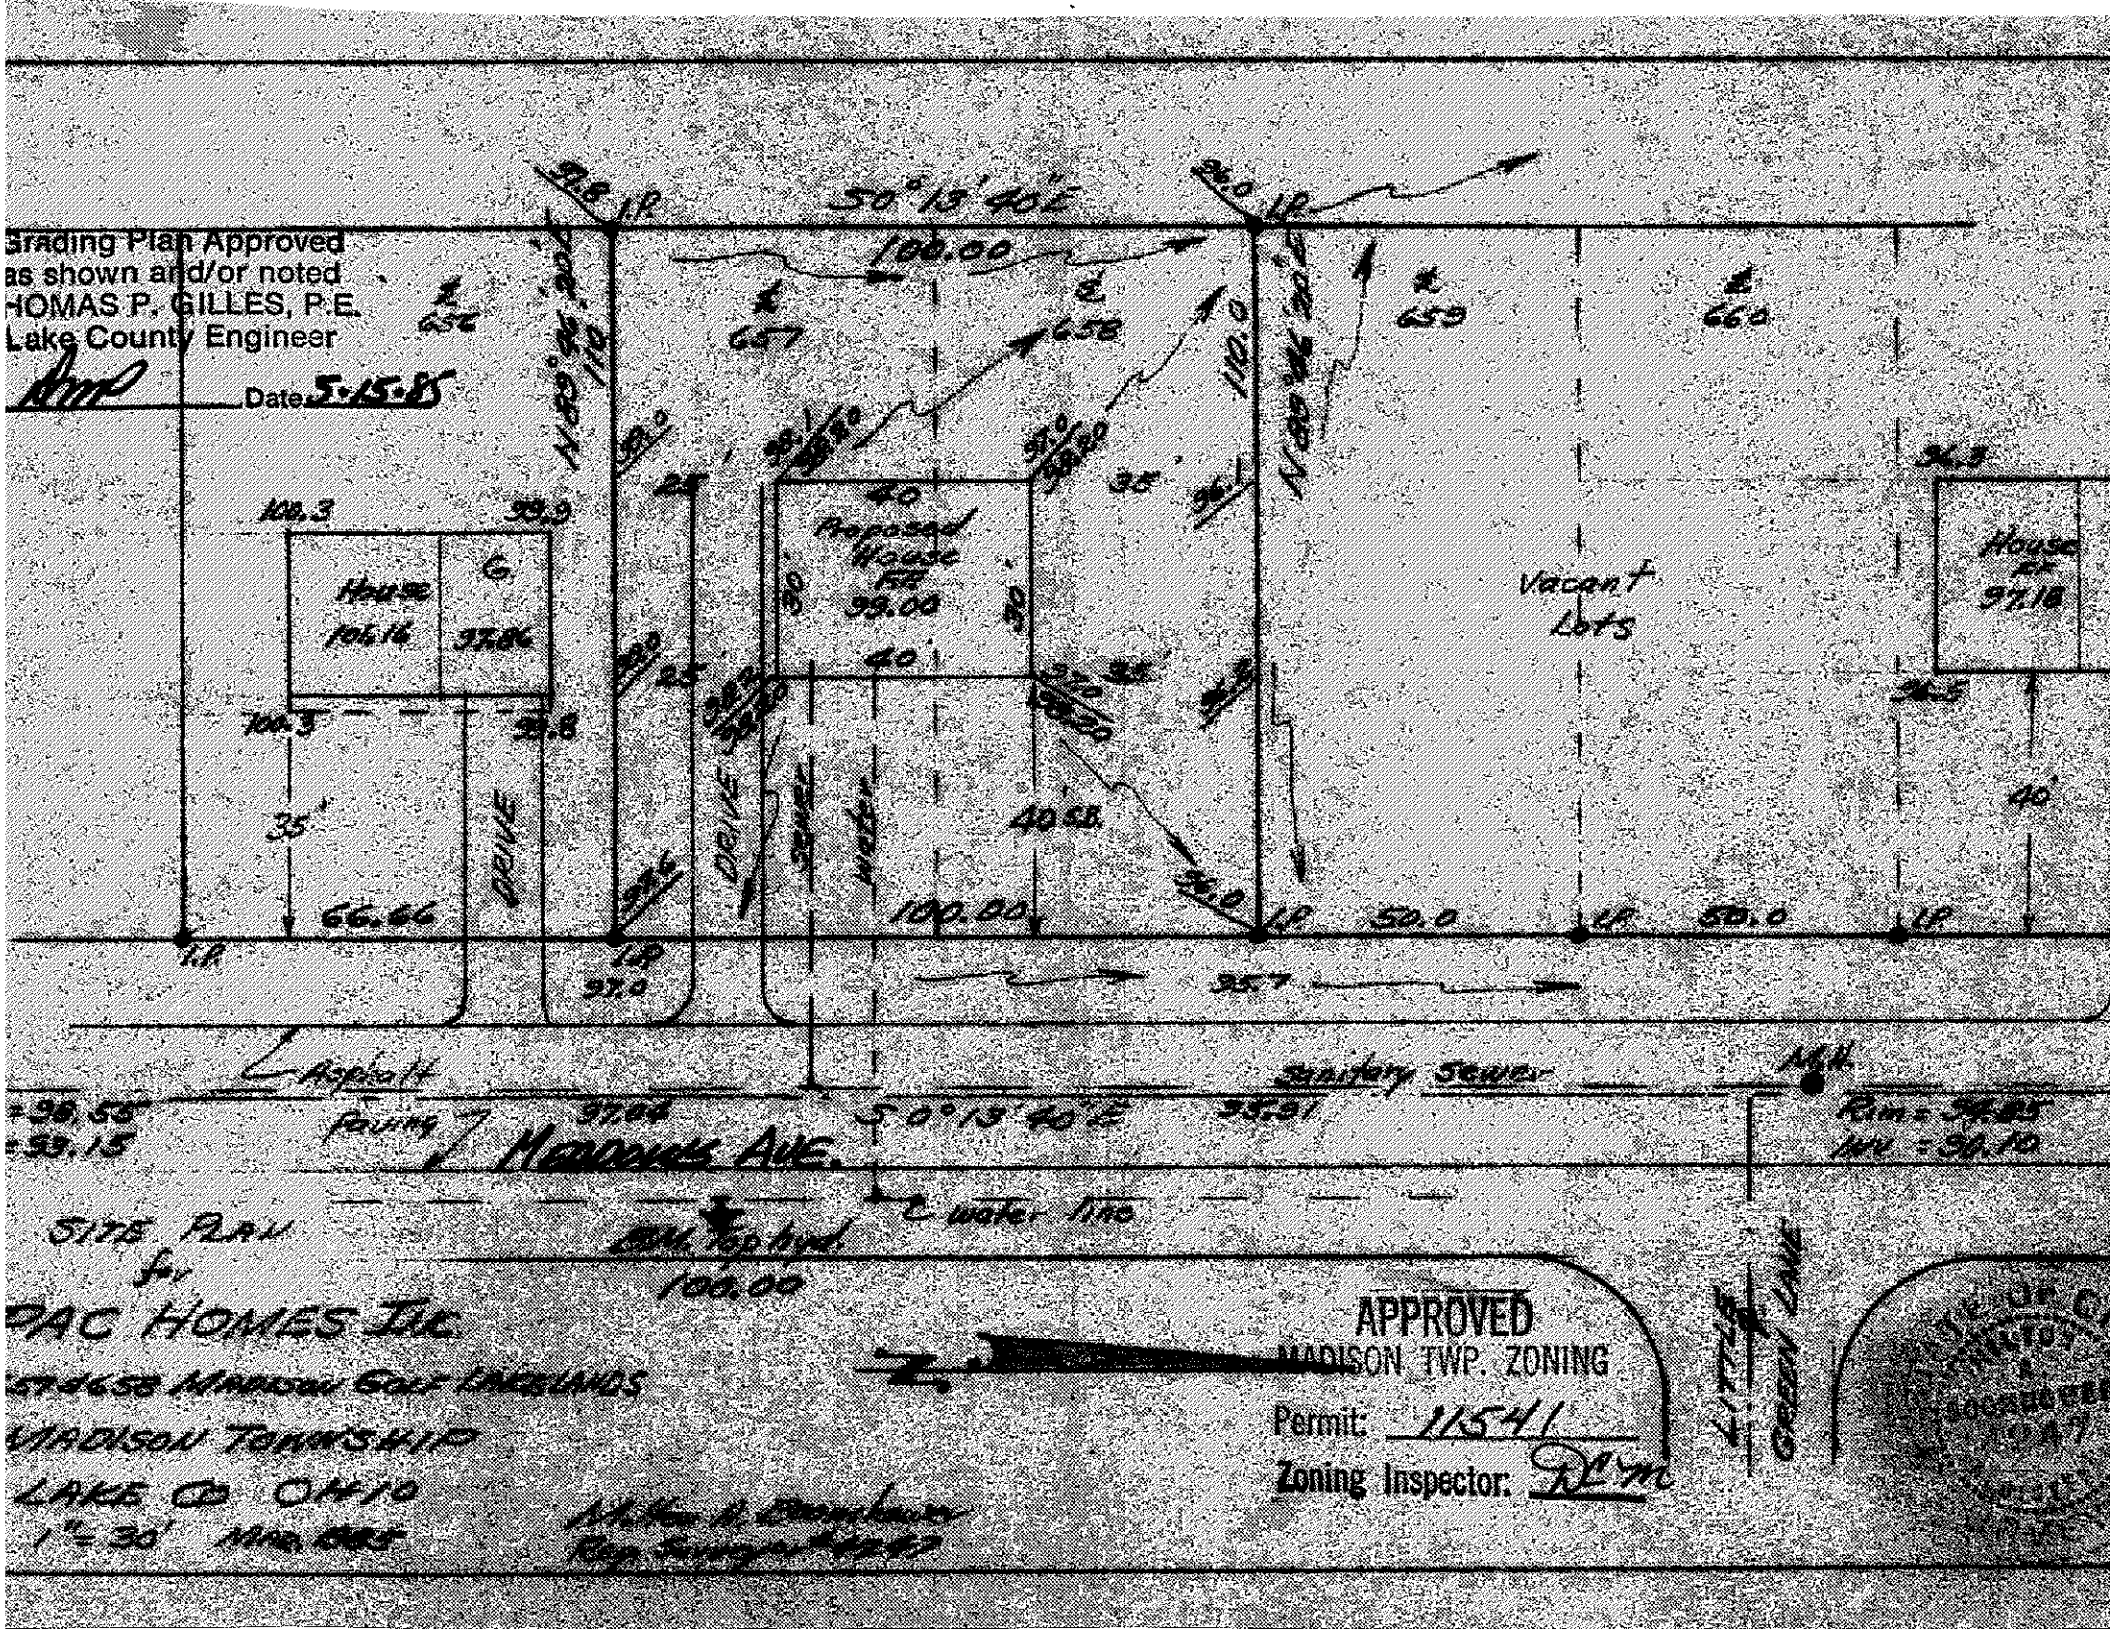

Grading Plan Approved
as shown and/or noted
HOMAS P. GILLES, P.E.
Lake County Engineer
Date 5-15-85
50°13'40"E
100.00
House
101.16
G
97.86
Proposed House
FF
99.00
Vacant Lots
House
FF
97.18
DRIVE
Sewer
Water
Asphalt
Paving
Sanitary Sewer
M.H.
Rim = 94.85
Inv = 90.10
MEADOWS AVE.
water line
BM Top hyd.
100.00
SITE PLAN
for
PAC HOMES INC
MADISON GOLF LAKELANDS
MADISON TOWNSHIP
LAKE CO OHIO
1" = 30'
APPROVED
MADISON TWP. ZONING
Permit: 11541
Zoning Inspector:
LITTLE GREEN LANE