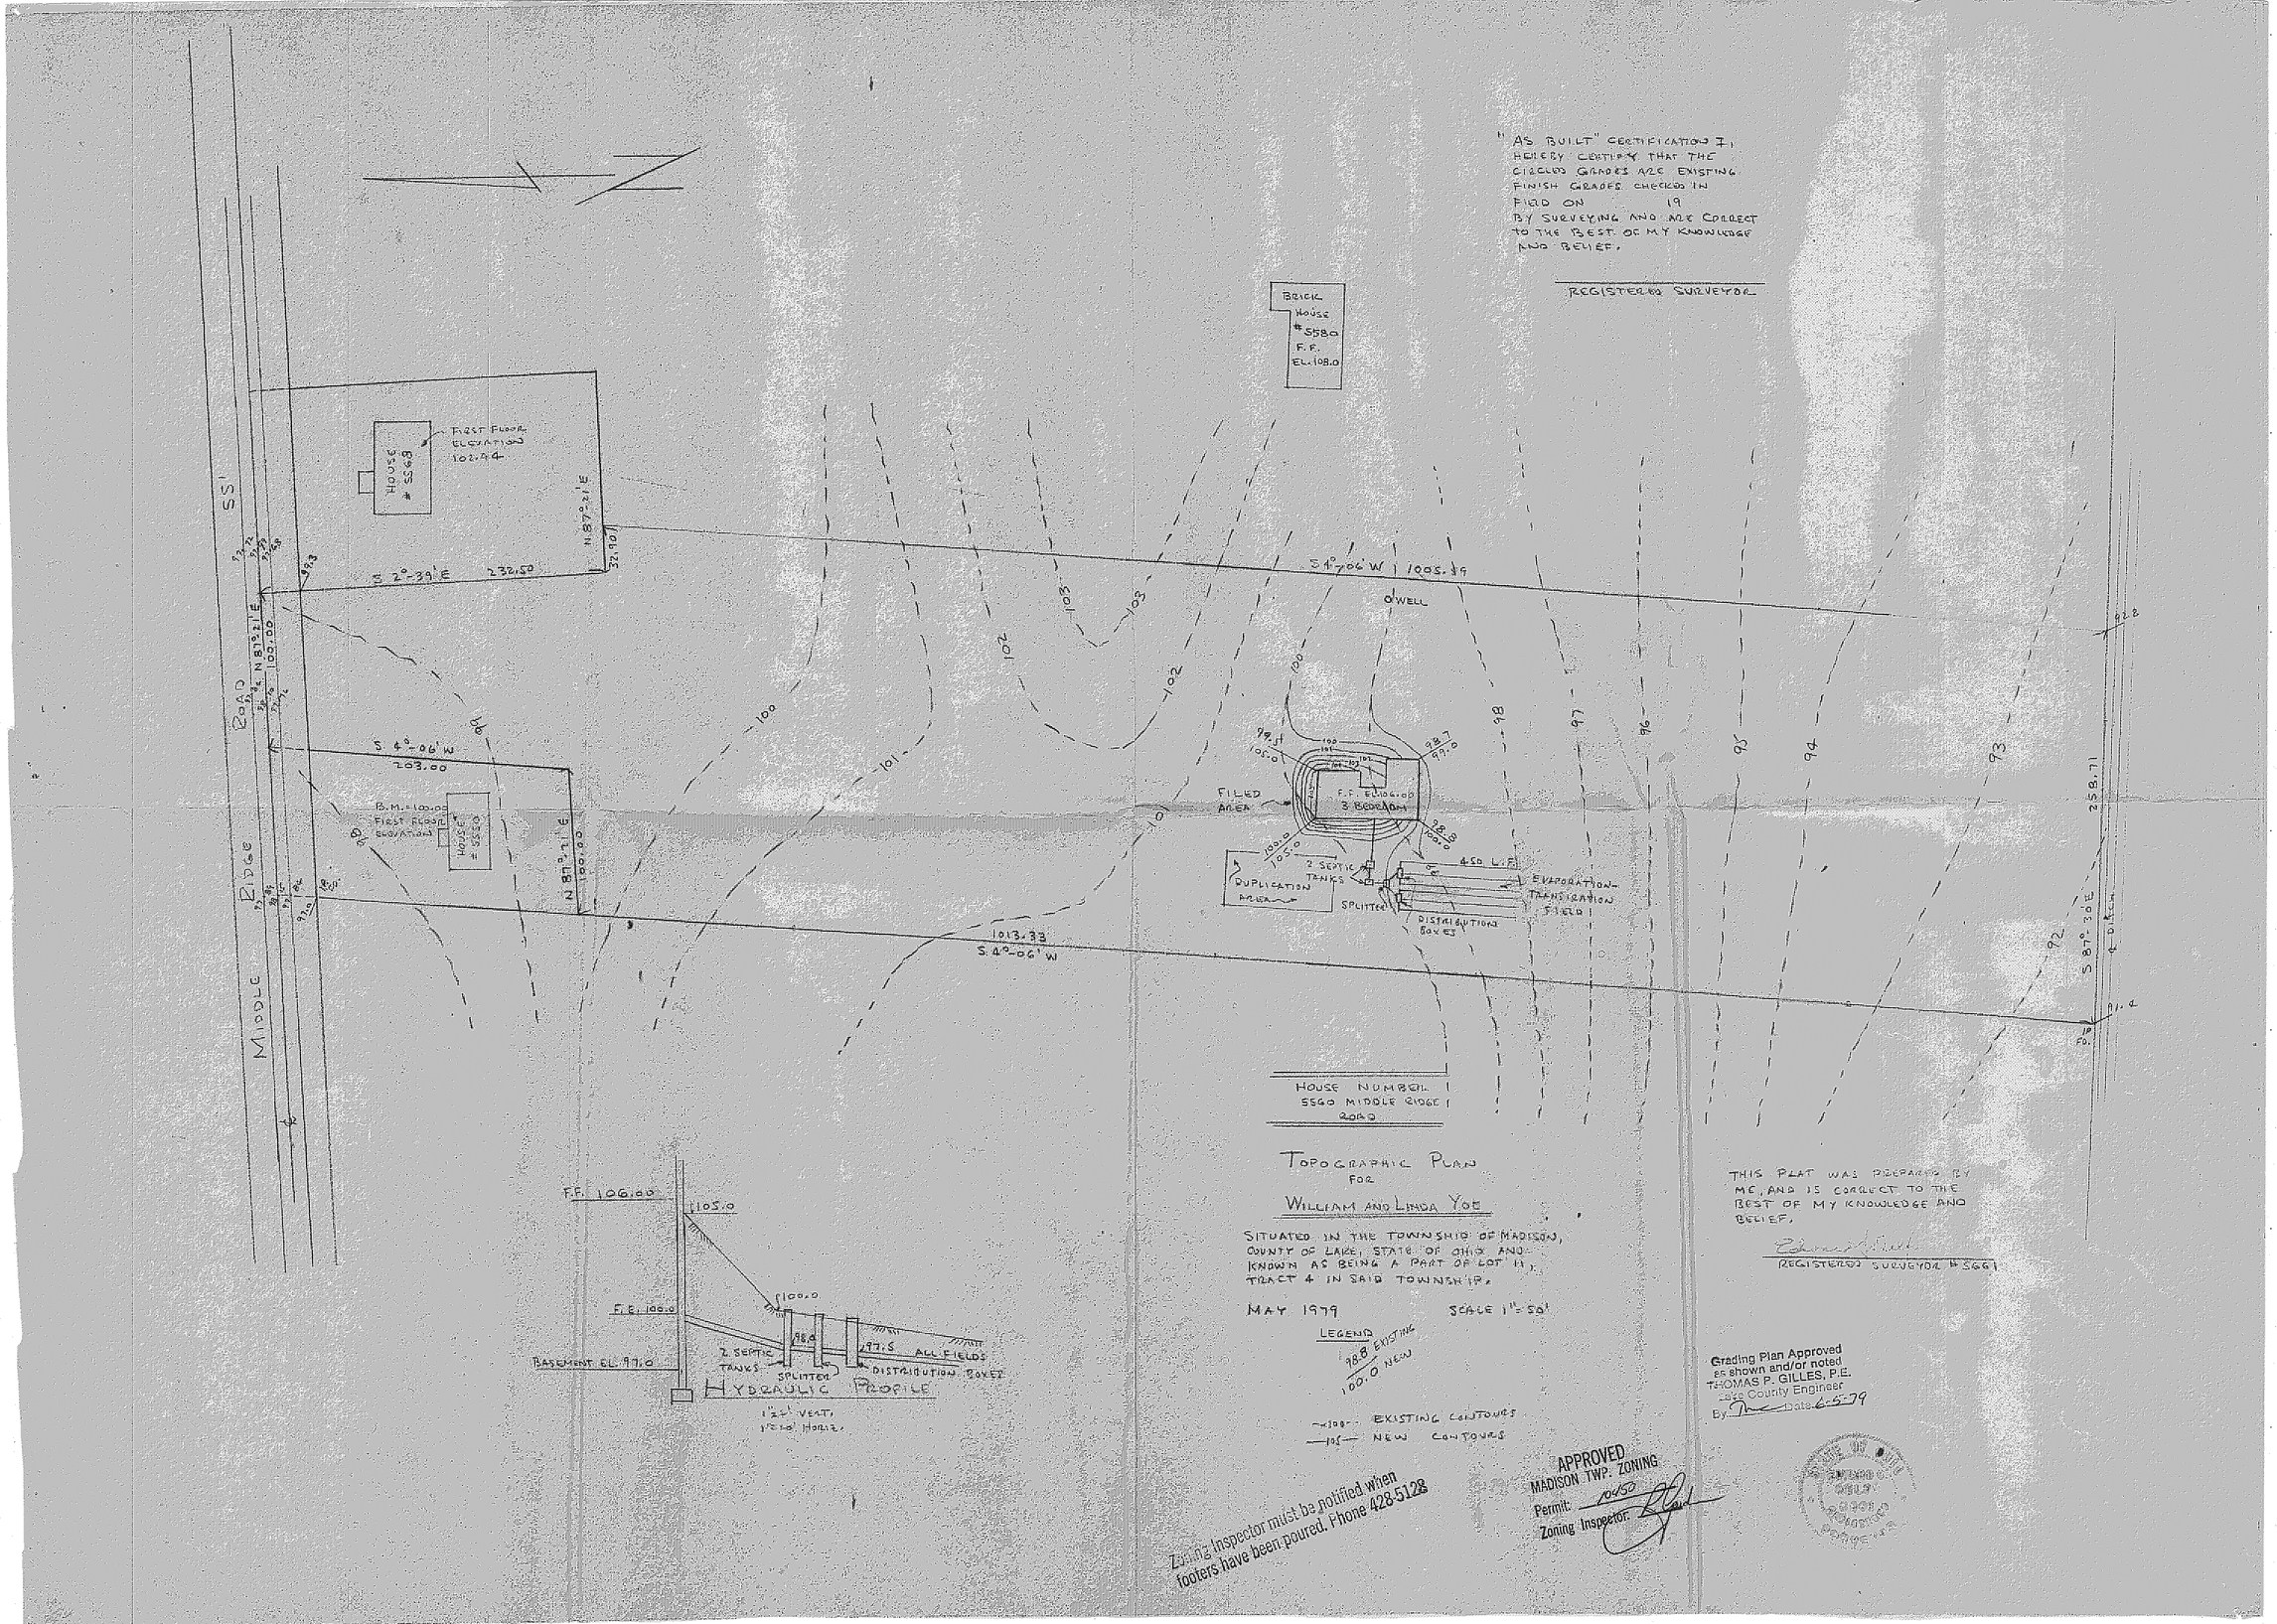
"AS BUILT" CERTIFICATION I, HEREBY CERTIFY THAT THE CIRCLED GRADES ARE EXISTING FINISH GRADES CHECKED IN FIELD ON 19 BY SURVEYING AND ARE CORRECT TO THE BEST OF MY KNOWLEDGE AND BELIEF.
REGISTERED SURVEYOR
BRICK HOUSE #5580 F.F. EL. 108.0
HOUSE #5568
FIRST FLOOR ELEVATION 102.44
S 2°-39' E 232.50
N 87°-21' E 32.90
S 4°-06' W 1005.39
O'WELL
S 4°-06' W 203.00
B.M. = 100.00 FIRST FLOOR ELEVATION
HOUSE #5550
N 87°-21' E 100.00
1013.33 S 4°-06' W
FILED AREA
F.F. EL. 106.00 3 BEDROOM
2 SEPTIC TANKS
DUPLICATION AREA
SPLITTER
450 L.F.
EVAPORATION-TRANSPIRATION FIELD
DISTRIBUTION BOXES
MIDDLE RIDGE ROAD
S 87°-30' E 258.71
HOUSE NUMBER 5560 MIDDLE RIDGE ROAD
TOPOGRAPHIC PLAN FOR WILLIAM AND LINDA YOE
SITUATED IN THE TOWNSHIP OF MADISON, COUNTY OF LAKE, STATE OF OHIO AND KNOWN AS BEING A PART OF LOT 11, TRACT 4 IN SAID TOWNSHIP.
MAY 1979
SCALE 1" = 50'
LEGEND
98.8 EXISTING
100.0 NEW
EXISTING CONTOURS
NEW CONTOURS
THIS PLAT WAS PREPARED BY ME, AND IS CORRECT TO THE BEST OF MY KNOWLEDGE AND BELIEF.
REGISTERED SURVEYOR #5661
F.F. 106.00
105.0
F.E. 100.0
100.0
98.0
97.5
ALL FIELDS
BASEMENT EL. 97.0
2 SEPTIC TANKS
SPLITTER
DISTRIBUTION BOXES
HYDRAULIC PROFILE
1"=2' VERT.
1"=10' HORIZ.
Grading Plan Approved as shown and/or noted
THOMAS P. GILLES, P.E.
Lake County Engineer
By
Date 6-5-79
APPROVED
MADISON TWP. ZONING
Permit: 10450
Zoning Inspector:
Zoning Inspector must be notified when footers have been poured. Phone 428-5128