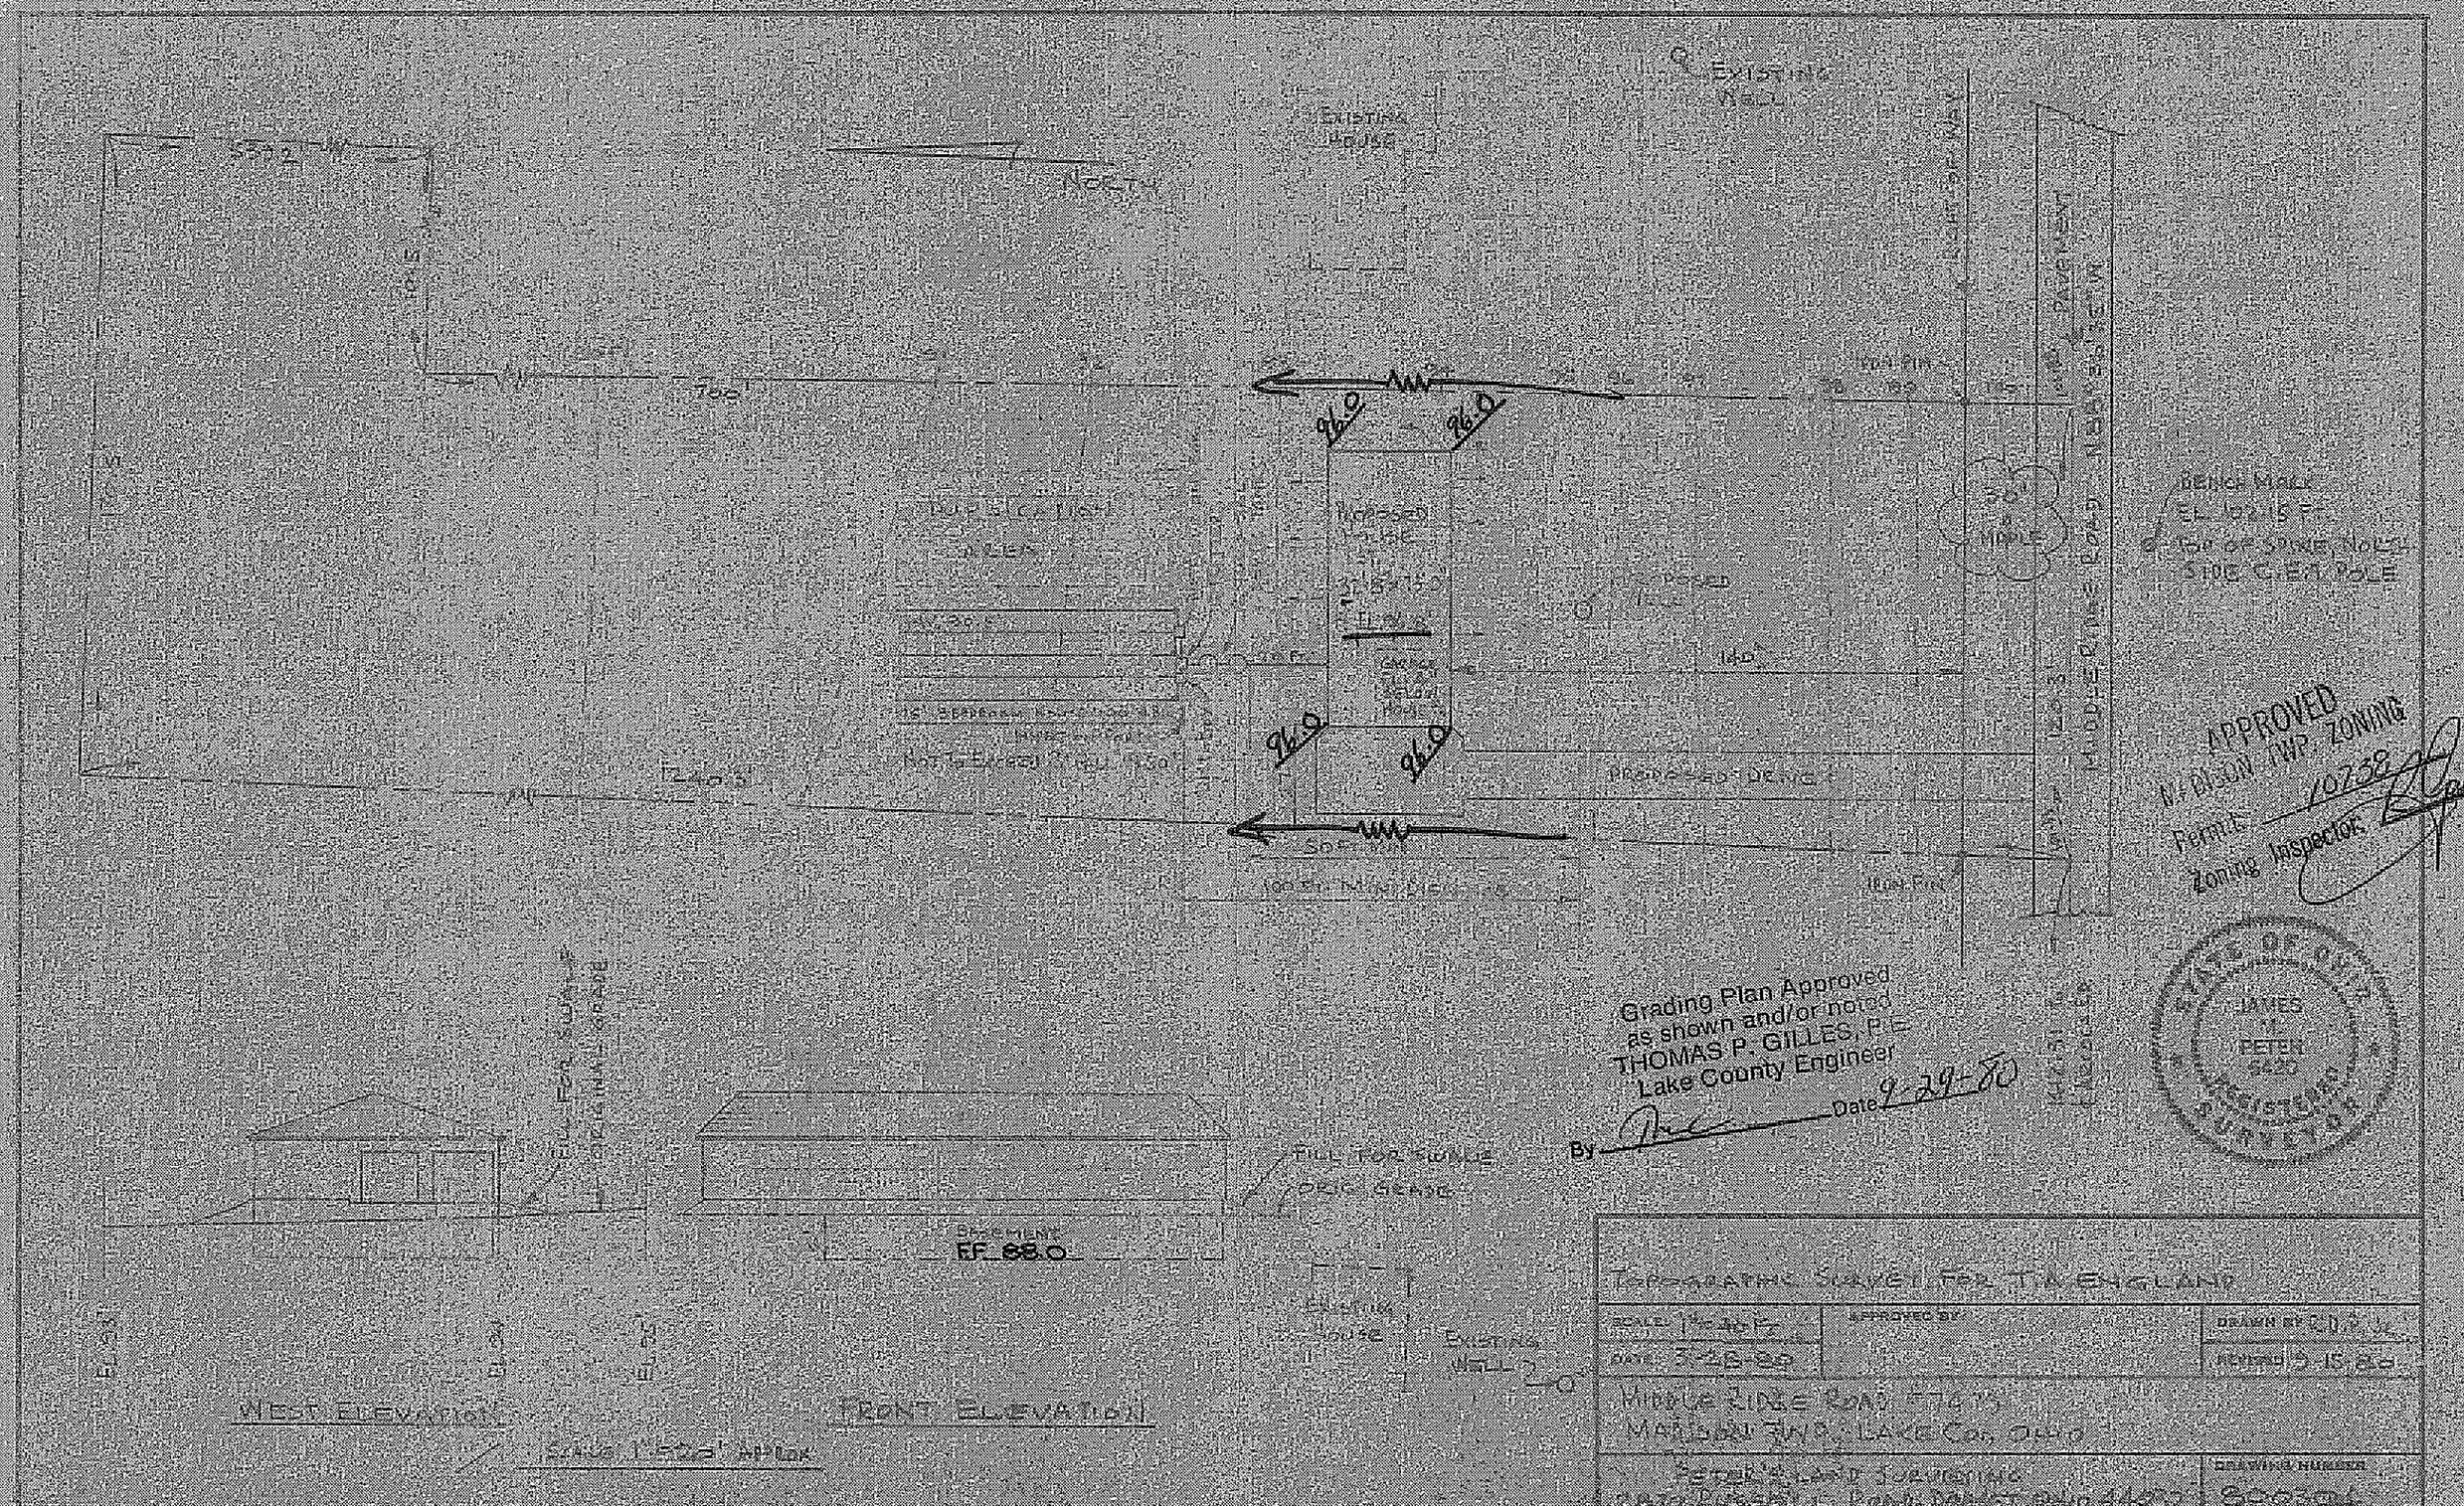

Existing Well
Existing House
North
Right of Way
Pavement
Middle Ridge Road
Bench Mark
El. 102.15 ft.
Top of Spike, North Side C.E.A. Pole
Proposed House
Proposed Drive
Proposed Well
Not to Exceed
Fill for Swale
Original Grade
Basement
EF 88.0
Existing House
Existing Well
West Elevation
Front Elevation
Scale 1"=20' Approx
Grading Plan Approved as shown and/or noted
THOMAS P. GILLES, P.E.
Lake County Engineer
By
Date 9-29-80
APPROVED
MADISON TWP. ZONING
Permit 10738
Zoning Inspector
STATE OF OHIO
JAMES M. PETER
REGISTERED SURVEYOR
Topographic Survey for T.A. England
Scale 1"=40 ft.
Date 3-28-80
Approved by
Drawn by
Revised 9-15-80
Middle Ridge Road
Madison Twp., Lake Co., Ohio
Peter's Land Surveying
Drawing Number