SHEET 1 OF 1

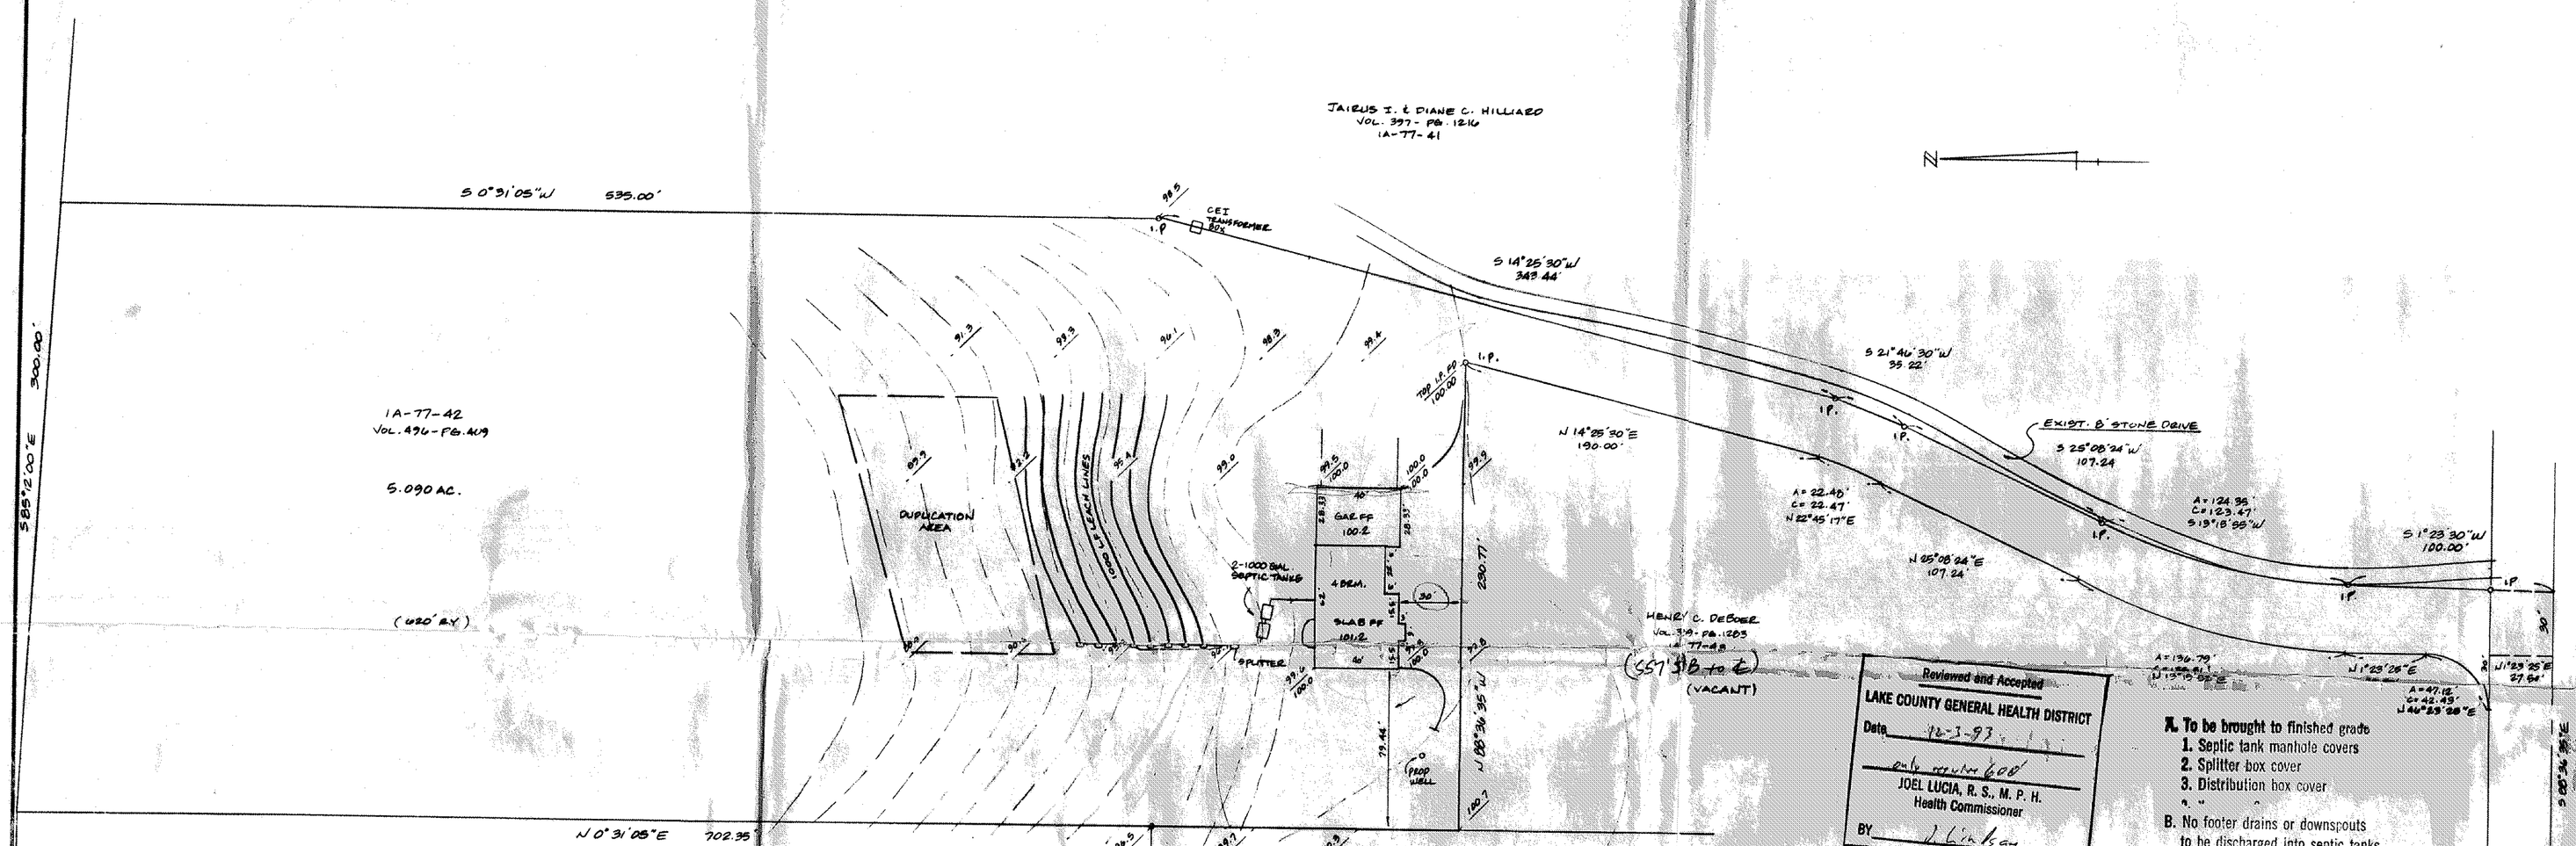

Reviewed and Accepted
LAKE COUNTY GENERAL HEALTH DISTRICT
Date 12-3-93
only require 600'
JOEL LUCIA, R. S., M. P. H.
Health Commissioner
BY J. Lindsey

A. To be brought to finished grade
1. Septic tank manhole covers
2. Splitter box cover
3. Distribution box cover
B. No footer drains or downspouts to be discharged into septic tanks
C. All waste water to be discharged into septic tanks

LOW YIELD WATER FIXTURES REQUIRED ON ALL:
___ Shower Head
___ Toilet

SEWAGE DISPOSAL PERMIT MUST BE OBTAINED BY A LAKE COUNTY LICENSED INSTALLER BEFORE INSTALLATION IS STARTED.

TYPICAL LEACHING TRENCH CROSS SECTION

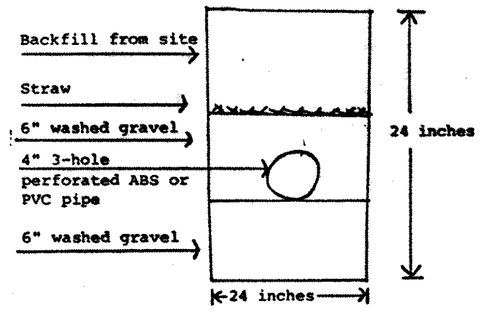

* The standard leaching trench is 24 inches deep, however the trench can vary between 18 to 30 inches deep if necessary. Gravel requireme is standard - amount of backfill would vary.

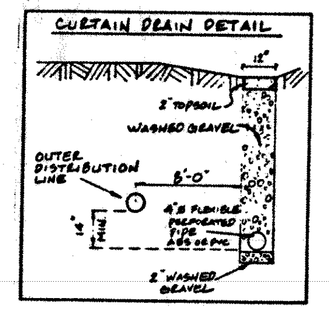

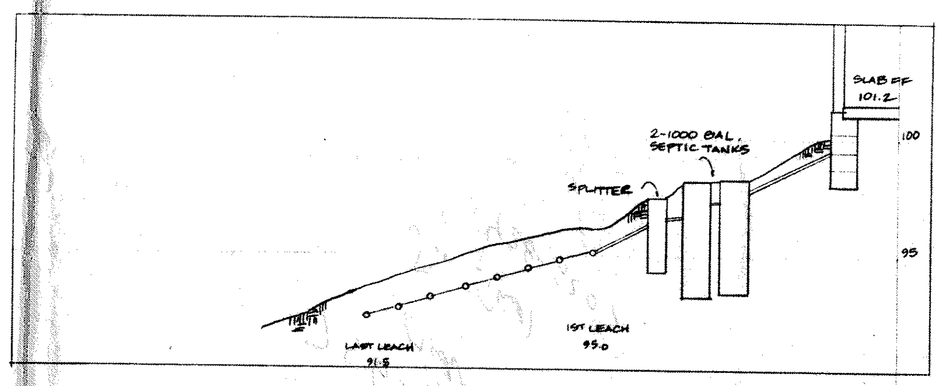

HYDRAULIC PROFILE
HORZ. 1" = 30', VERT. 1" = 5'

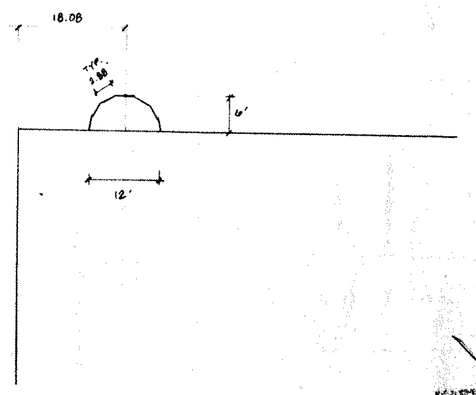

UNEX. DETAIL

APPROVED
MADISON TWP. ZONING
Permit: 13972
Zoning Inspector: [signature]
BZA
DEC. 09 1993

APPROVED
MADISON TOWNSHIP ZONING
OCT 6 1995
PERMIT # 13972
ZONING INSPECTOR [signature]
N.S. Revised

"I, the undersigned hereby certify that this topography indicated by 6", 1' or 2' contours, and elevations shown hereon represent an actual field survey made by me on the 19th day of Nov., 1993 and that the elevations were taken at appropriate intervals and that as of that date they existed as indicated hereon."

Name [signature] Reg. No. #6343

THOMAS P. GILLES, P.E.
Lake County Engineer
By GJH Date 10/10/95

STATE OF OHIO
HARRIS JONES JR.
REGISTERED SURVEYOR

REV NO.	DESCRIPTION	DATE	BY	CHK'D

SITE PLAN
FOR
JIM & KATHY SMITH

BABCOCK, JONES AND ASSOCIATES, INC
CIVIL ENGINEERS - SURVEYORS - LAND PLANNERS
PAINESVILLE OHIO 44077

DATE NOVEMBER 21, 1993
DESIGN BY [initials]
DRAWN BY [initials]
APPROVED BY [initials]

BEING A PART OF LOT #2, TRACT #1
MADISON TWP., LAKE COUNTY, OHIO
PP# 1A-77-42 VOL. 496 - PG. 409

SCALE 1" = 30'
JOB NO 89-270
SHEET 1 OF 1