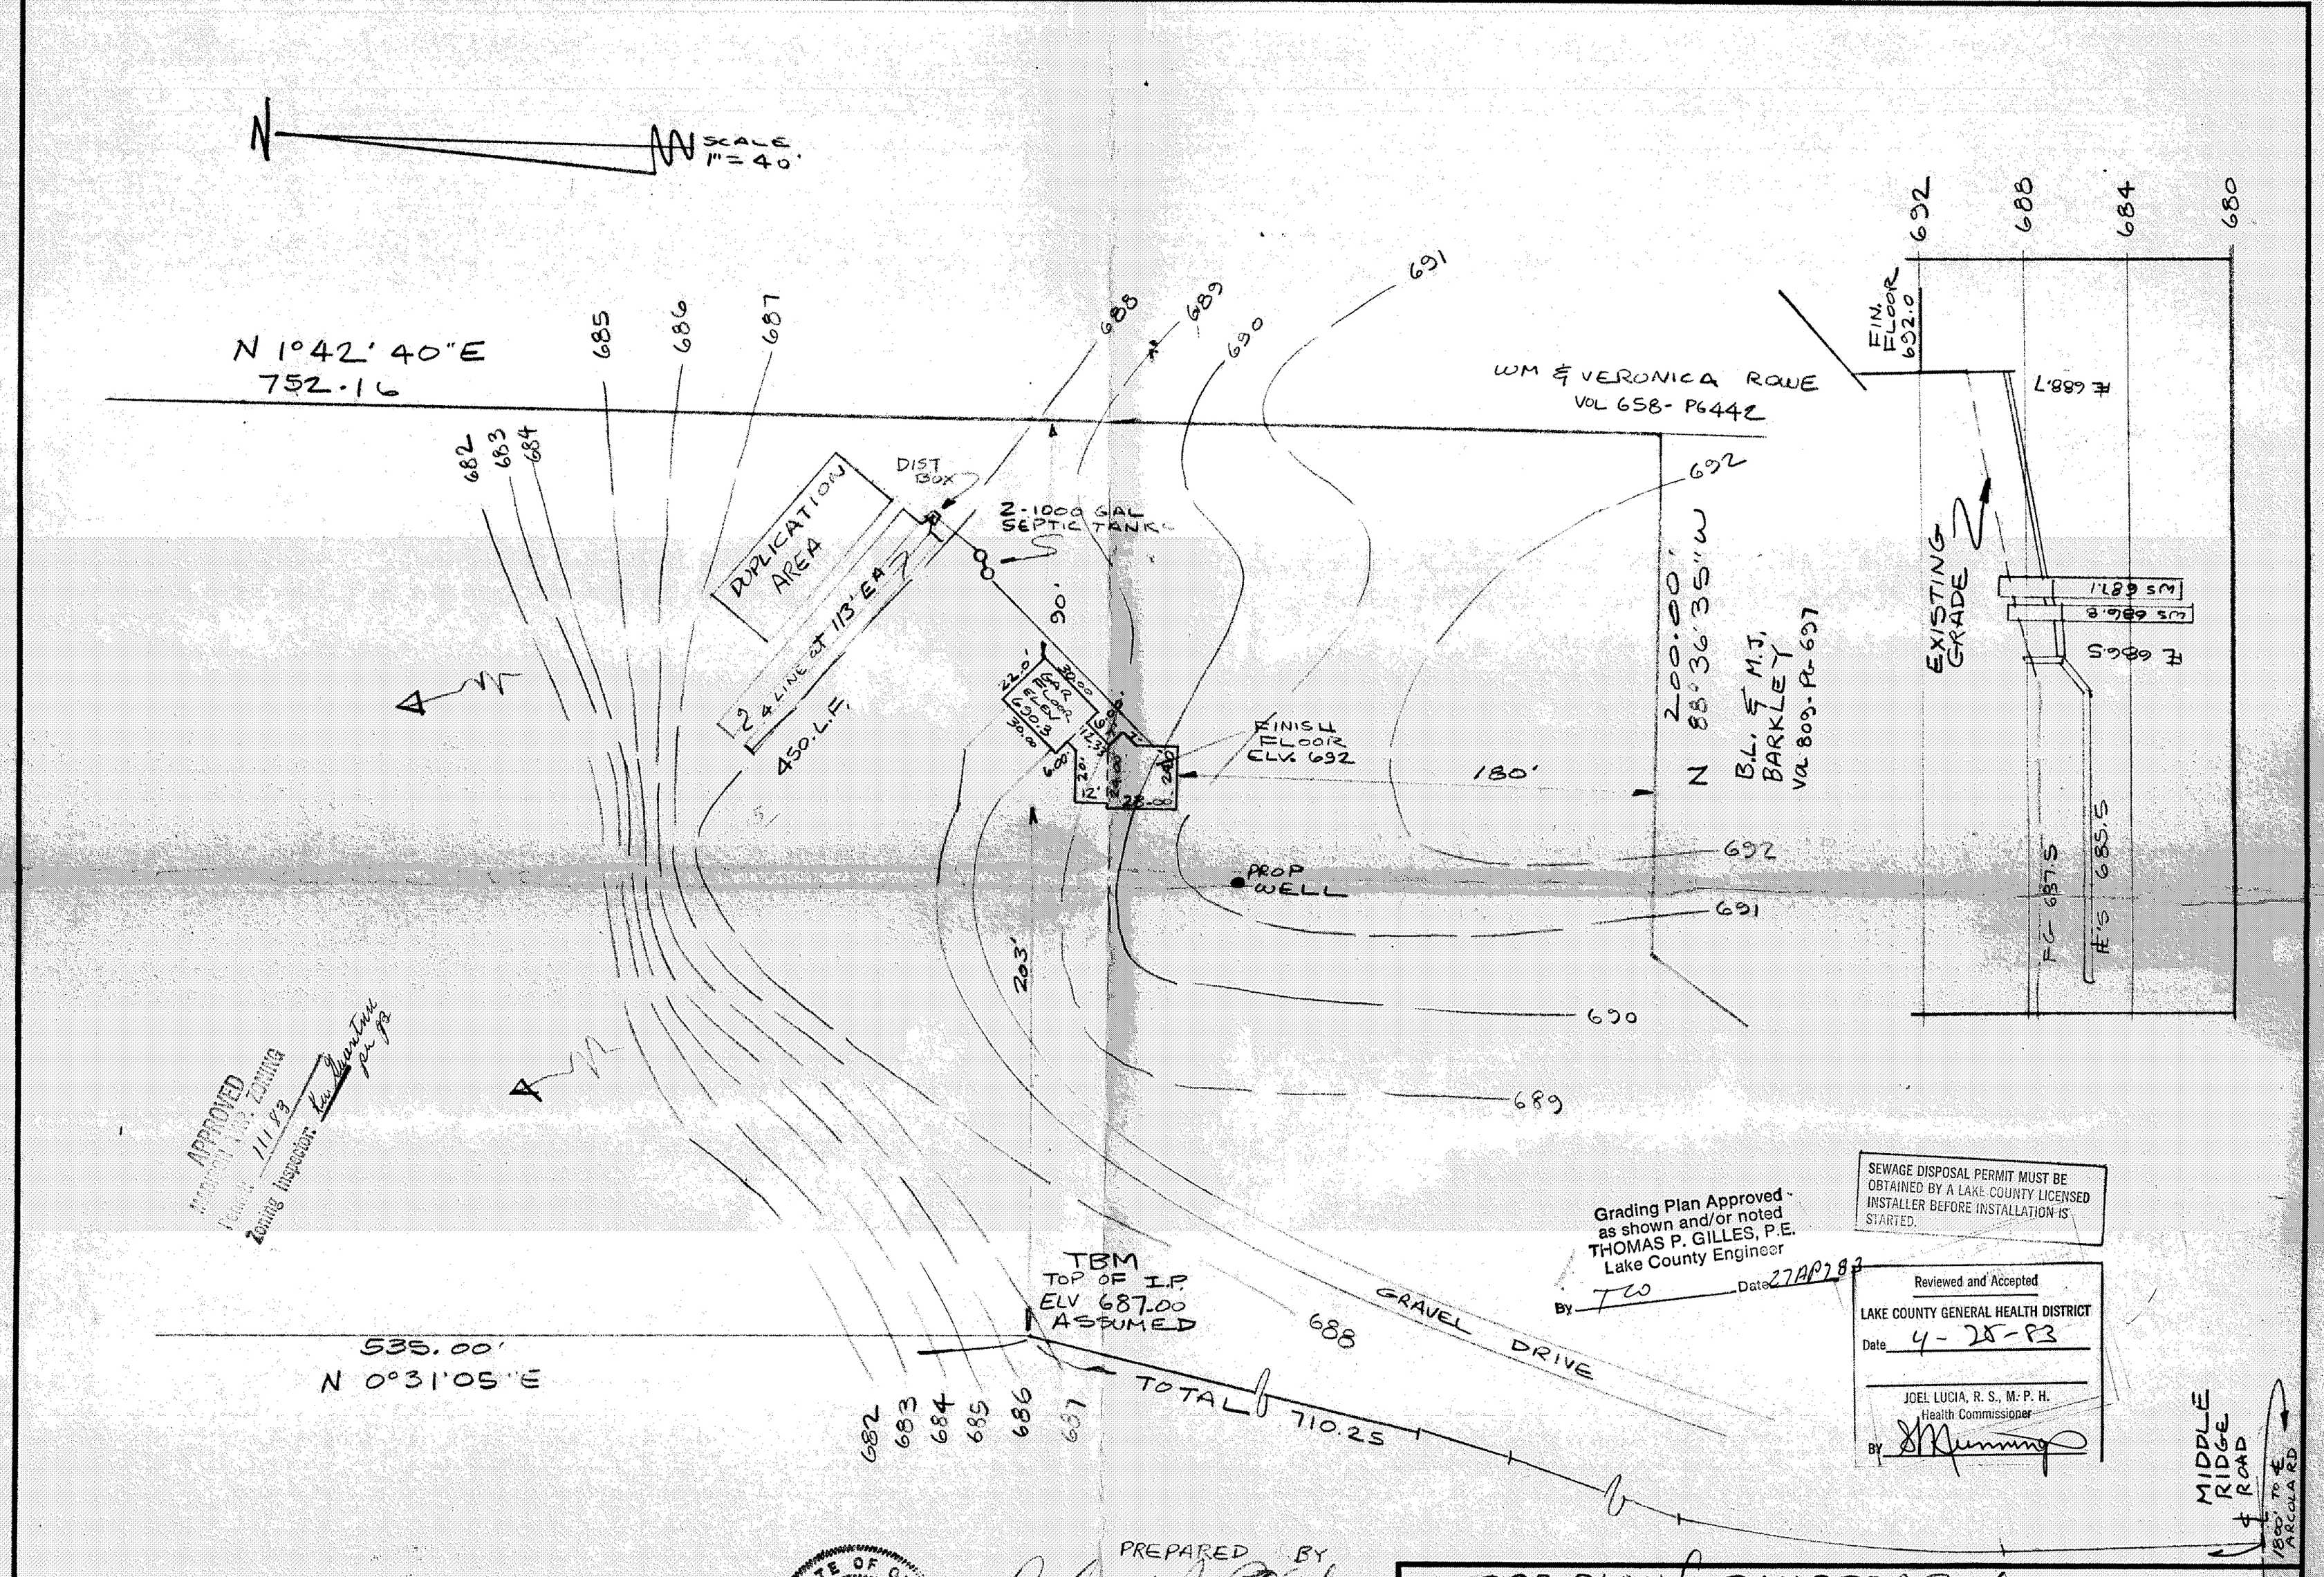

APPROVED
MADISON TWP. ZONING
Permit 11183
Zoning Inspector: [signature] per gs

Grading Plan Approved as shown and/or noted
THOMAS P. GILLES, P.E.
Lake County Engineer
By TW Date 27 APR 83

SEWAGE DISPOSAL PERMIT MUST BE OBTAINED BY A LAKE COUNTY LICENSED INSTALLER BEFORE INSTALLATION IS STARTED.

Reviewed and Accepted
LAKE COUNTY GENERAL HEALTH DISTRICT
Date 4-25-83
JOEL LUCIA, R. S., M. P. H.
Health Commissioner
BY [signature]

STATE OF OHIO
RICHARD BILSKI 5244
REGISTERED SURVEYOR

PREPARED BY
[signature]
RICHARD J. BILSKI PS#5244

SITE PLAN for DAN SPEAR of PART OF 6.965 ACRES IN ORIG LOT No 2, TRACT No 1 IN MADISON TWP-LAKE COUNTY OHIO

DATE
SCALE
DRAWN BY
CH'K'D BY
F.B.# PG.

COLPETZER · WOODS
CONSULTANTS, INC.
MENTOR, OHIO 44060

SHEET OF
CONTRACT NO. 83-064