SITE PLAN

MADISON TOWNSHIP LAKE COUNTY, OHIO

for RYAN HOMES CLIENT OWNER

ADDRESS STREET CITY ZIP

MADISON GOLF CAMPGROUND RECORD SUBDIVISION		LOT	TRACT
C	68		
VOLUME	PAGE	VOLUME	PAGE
1140	STIRLING RD		
SUBLOT NO	STREET	PERM PARCEL #	STREET

LEGEND

SANITARY MANHOLE

STORM MANHOLE

INLET OR CATCH BASIN

HYDRANT

EXISTING CONTOURS

PROPOSED CONTOURS

EXIST. ELEV. 100.0

1000 PROP. ELEV

WATER VALVE (GAS)

WATER METER (GAS)

AS BUILT ELEVATION 100

DIRECTION OF SURFACE DRAINAGE

REMARKS

ALL BOUNDARY DATA SHOWN WAS OBTAINED FROM (DEEDS, RECORDED SUBDIVISION PLAT, OR OTHER PUBLIC RECORDS)

DESIGN CERTIFICATION

THIS PLAT WAS PREPARED BY ME, AND IS CORRECT TO THE BEST OF MY KNOWLEDGE AND BELIEF.

Richard R. Hayfield P.S. #5506

NAME SURVEYOR REGISTRATION NO.

CHECK LIST

DIMENSIONS
BEARINGS
TIE TO NEAREST STREET
SUBLOT NO. PARCEL NO.
SURROUNDING OWNERS
BLDG DIMENSIONS FIN GR.
BLDG TIES FLR GRADES
APRON TYPE WIDTH THICKNESS
SIDEWALK TYPE WIDTH THICKNESS
CULVERT TYPE DIA LENGTH

WATER MAIN SIZE LOCATION
SAN SEWER SIZE % GR LOC.
SAN M.H. CAST ELEV. INV ELEV.
SAN CONN. SIZE LOC. DEPTH
STORM SEWER SIZE % GR. LOC.
STORM MH. CAST ELEV. INV. ELEV.
PAVT. TYPE GRADE CURBS
GAS LINE LOC. SIZE PRESSURE
SEPTIC TANK SIZE LOC.
WELL LOCATION

RIVISIONS		
NO	DATE	BY
1		
2		
3		
4		
5		

PLAN PREPARED BY:

DEBEVEC-SALO & ASSOC., INC.
CIVIL ENGINEERS — SURVEYORS NAME
130 E. JACKSON ST. PAINESVILLE, O.
ADDRESS

DRAWN BY SWARTZ	SCALE 1"=30'	PHONE NO.
CHKD R.H.	DATE 2-20-72	DRAWING NO. 3528
CREW CHIEF	APP'D	

Grading Plan Approved as shown and/or noted
THOMAS P. GILLES, P.E.
Lake County Engineer

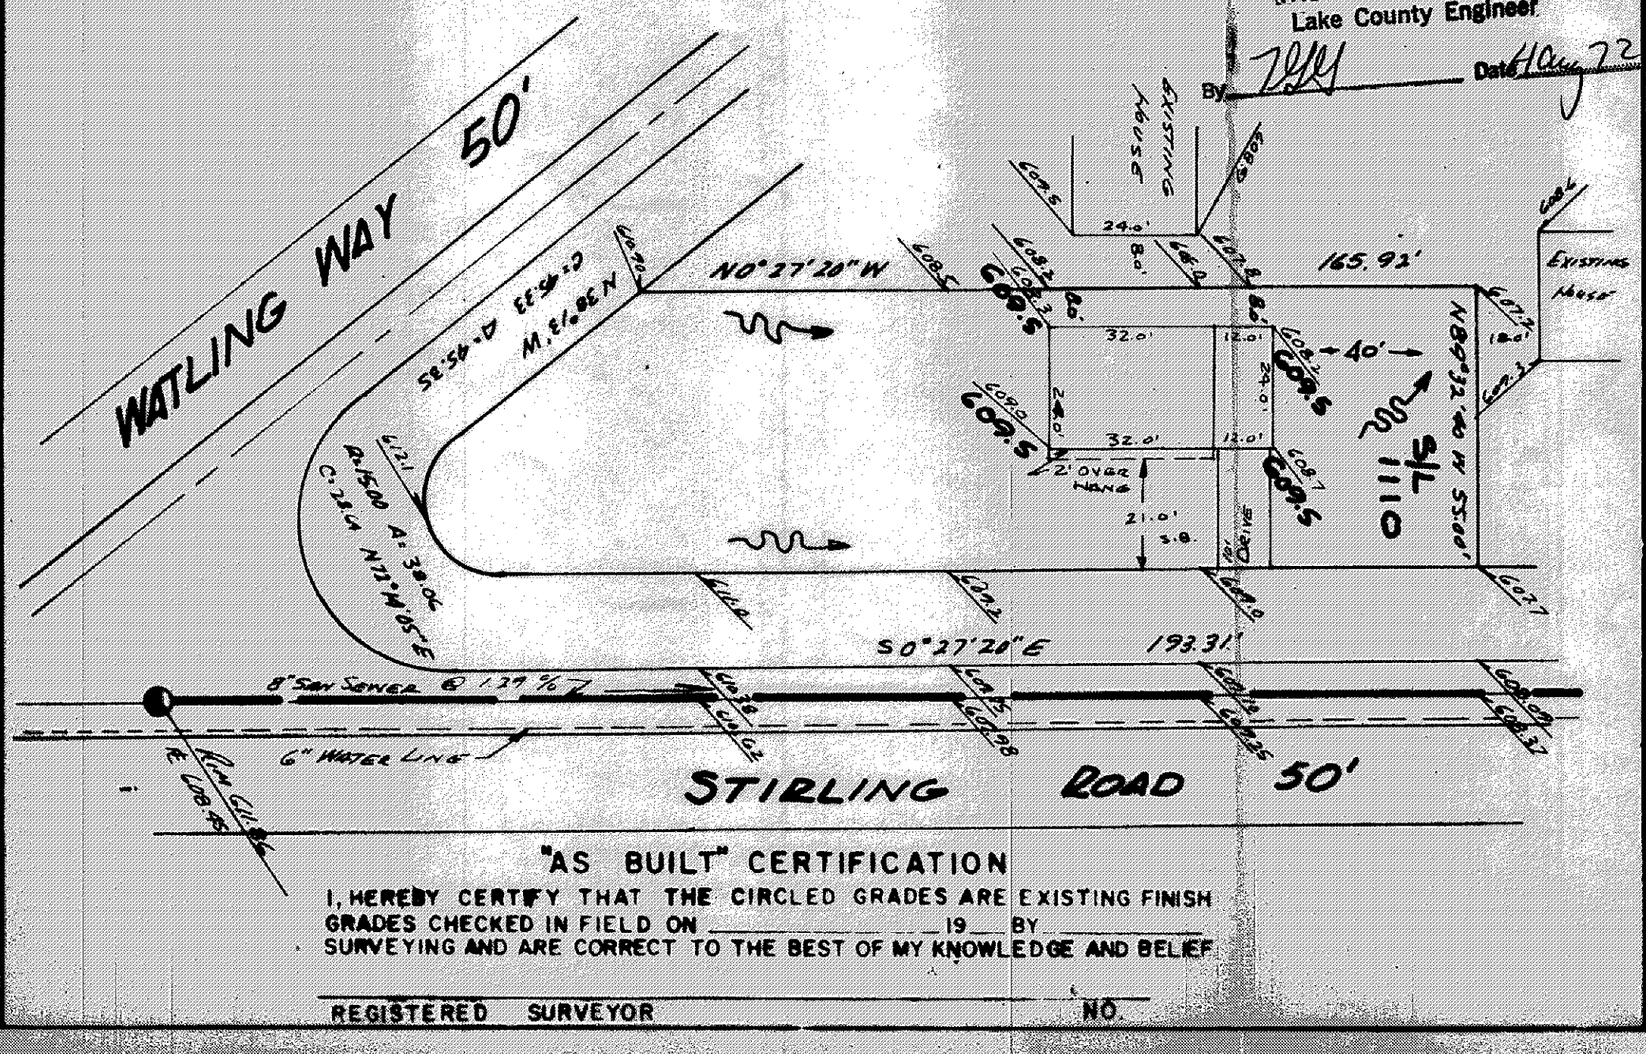

"AS BUILT" CERTIFICATION

I, HEREBY CERTIFY THAT THE CIRCLED GRADES ARE EXISTING FINISH GRADES CHECKED IN FIELD ON _____ 19__ BY _____ SURVEYING AND ARE CORRECT TO THE BEST OF MY KNOWLEDGE AND BELIEF

_____ NO. _____

REGISTERED SURVEYOR