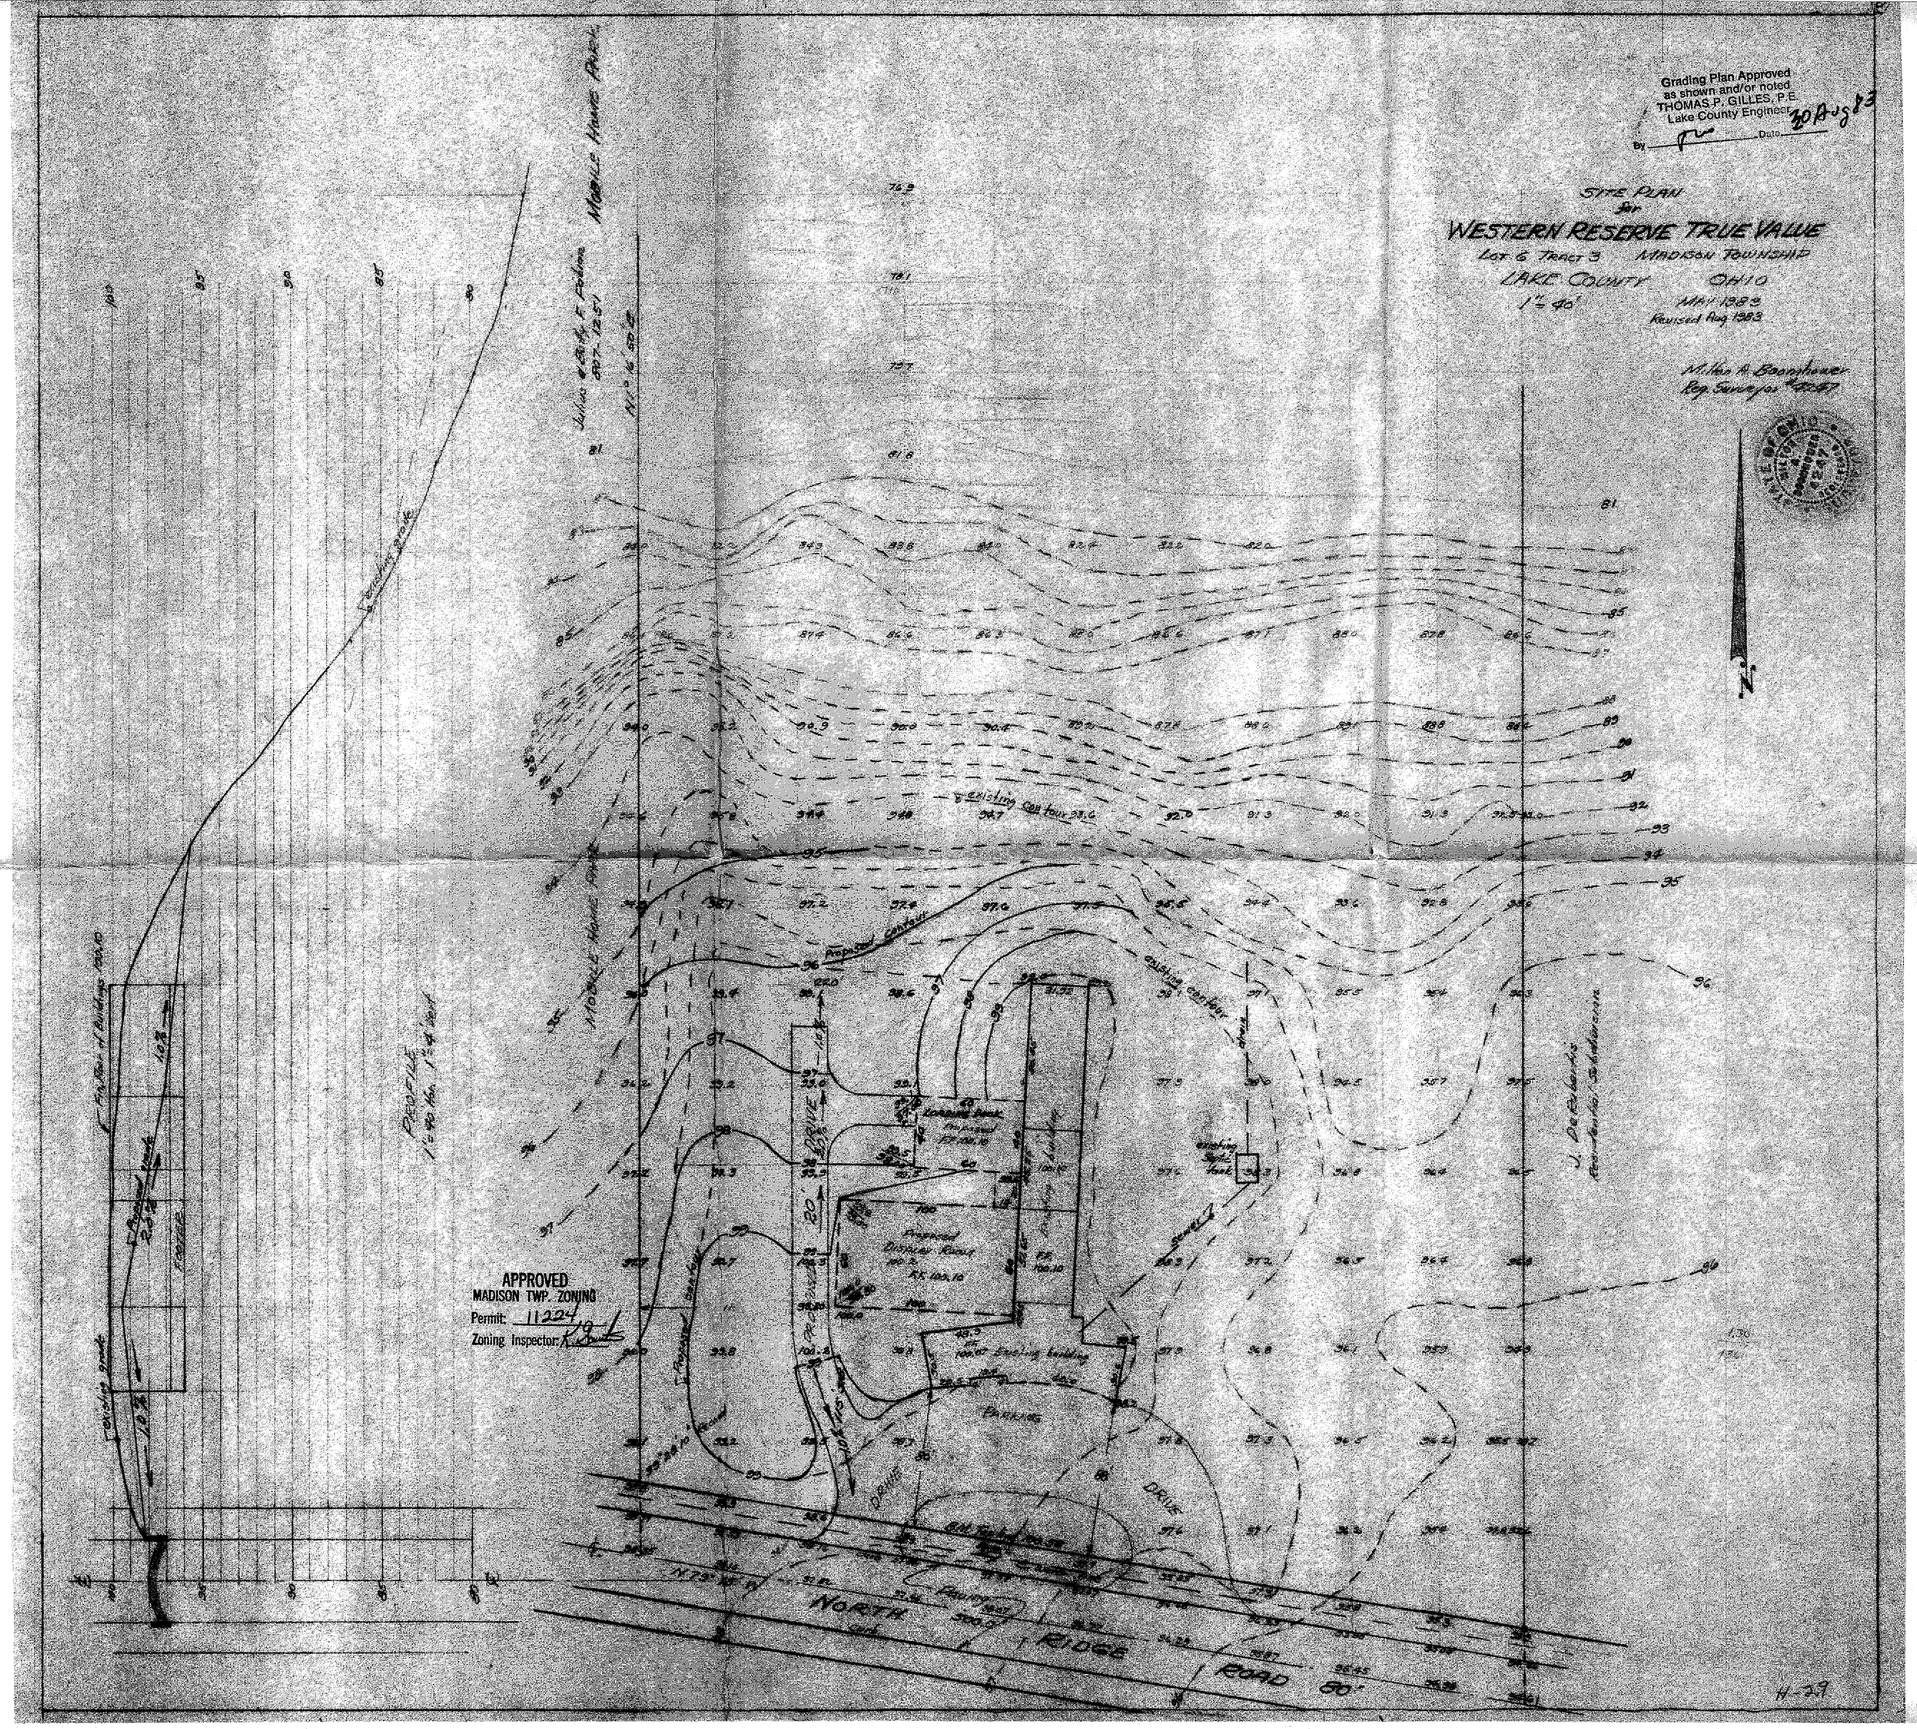
Grading Plan Approved
as shown and/or noted
THOMAS P. GILLES, P.E.
Lake County Engineer
By
Date 30 Aug 83
SITE PLAN
for
WESTERN RESERVE TRUE VALUE
LOT 6 TRACT 3 MADISON TOWNSHIP
LAKE COUNTY OHIO
1" = 40'
MAY 1983
Revised Aug 1983
Milton A. Boomhower
Reg. Surveyor #4247
MOBILE HOME PARK
PROFILE
1" = 40 Hor. 1" = 4 Vert
existing grade
Proposed contour
existing contour
Proposed Display Room
Existing building
PARKING
DRIVE
NORTH RIDGE ROAD 80'
J. DeRubertis
Residential Subdivision
APPROVED
MADISON TWP. ZONING
Permit: 11224
Zoning Inspector:
H-29