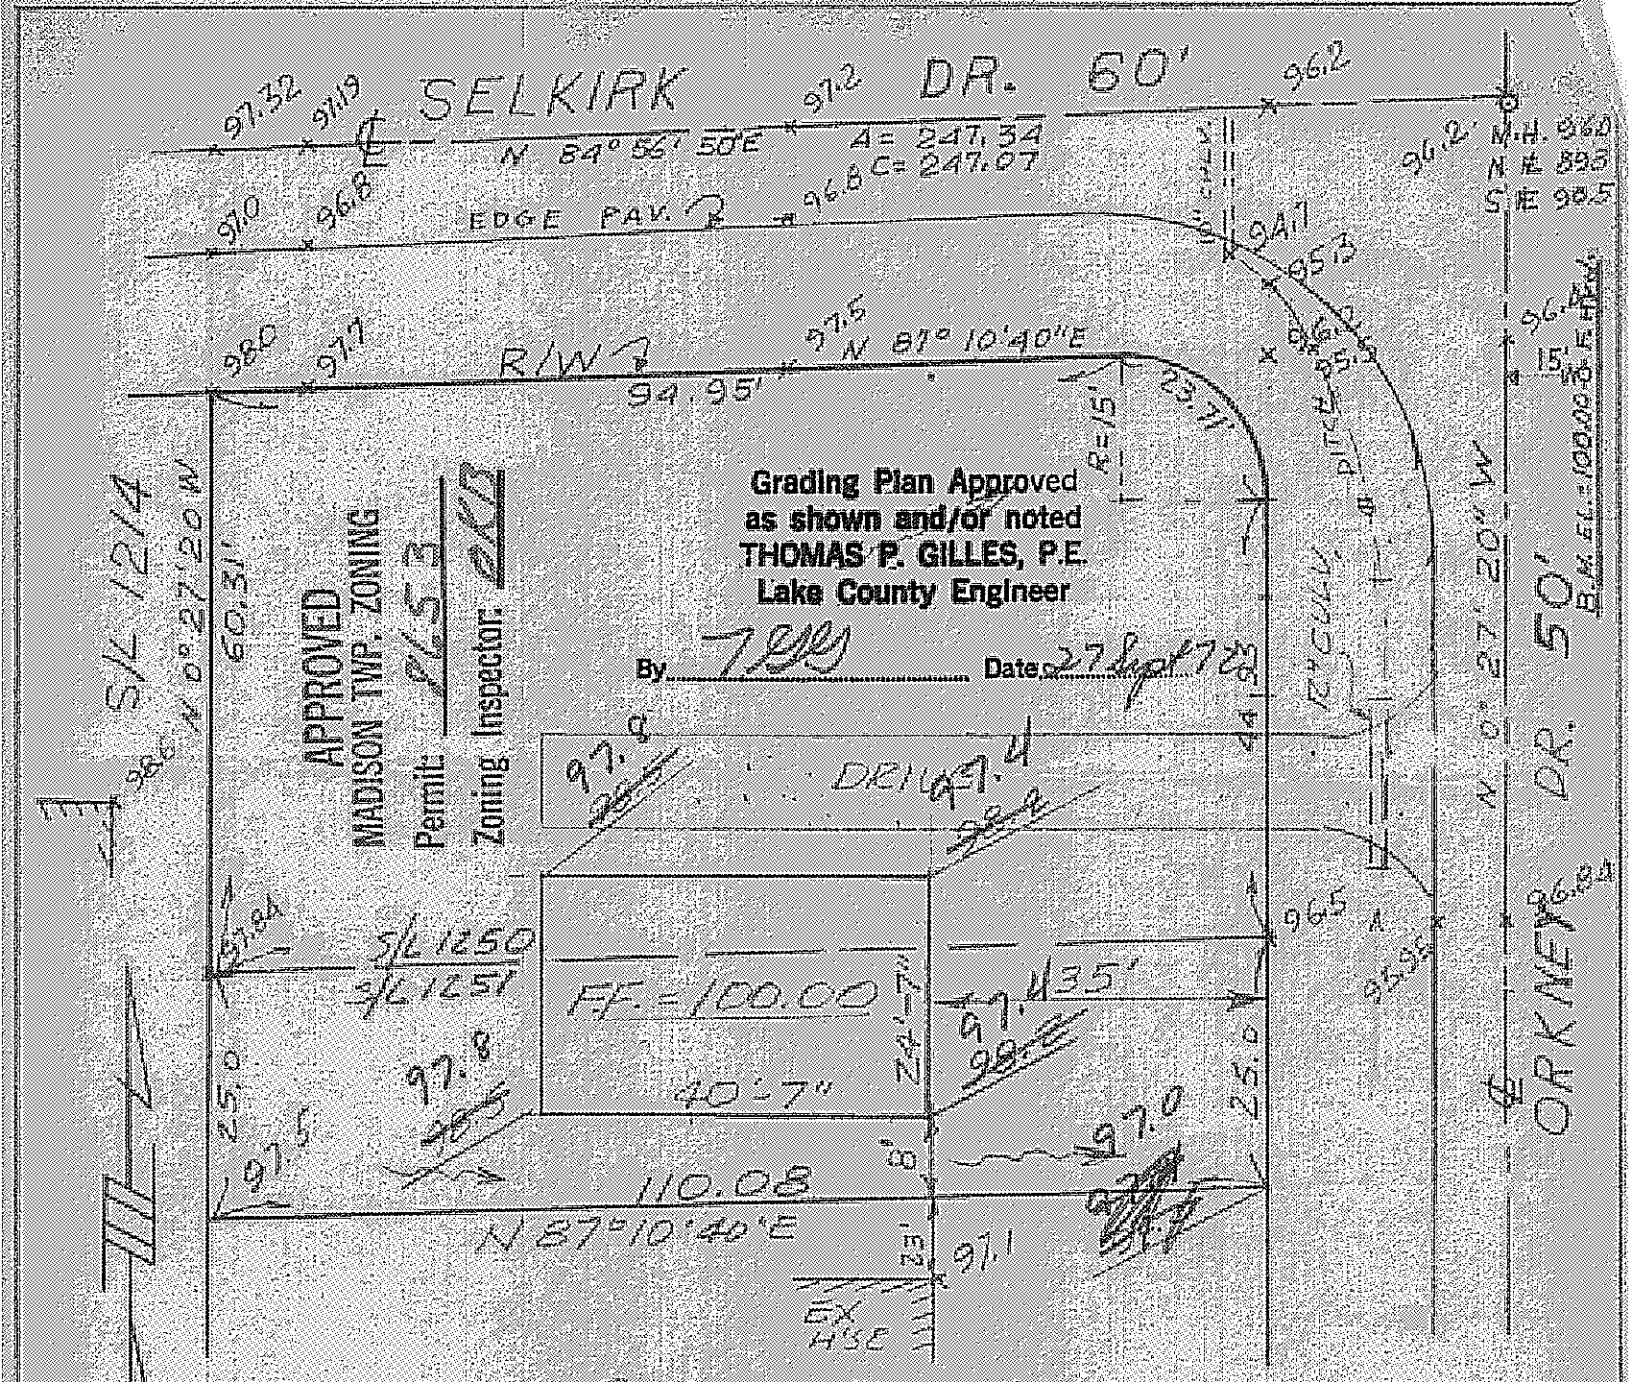

GRADING PLAN FOR

GINGER CONSTRUCTION CO.

S/L 1250 & PART OF S/L 1251 MADISON GOLF LAKELAND

MADISON TWP. — LAKE COUNTY, OHIO

SCALE: 1"=20' JUNE, 1972

As Built Certification

I Hereby Certify That The Circled Grades Are Existing Finish—

Grades Checked In The Field On _____ 197____

Survey Is Corrected To The Best Of My Knowledge And Belief—

Fullerton-Kerr & Assoc.

by _____

REG. SURVEYOR