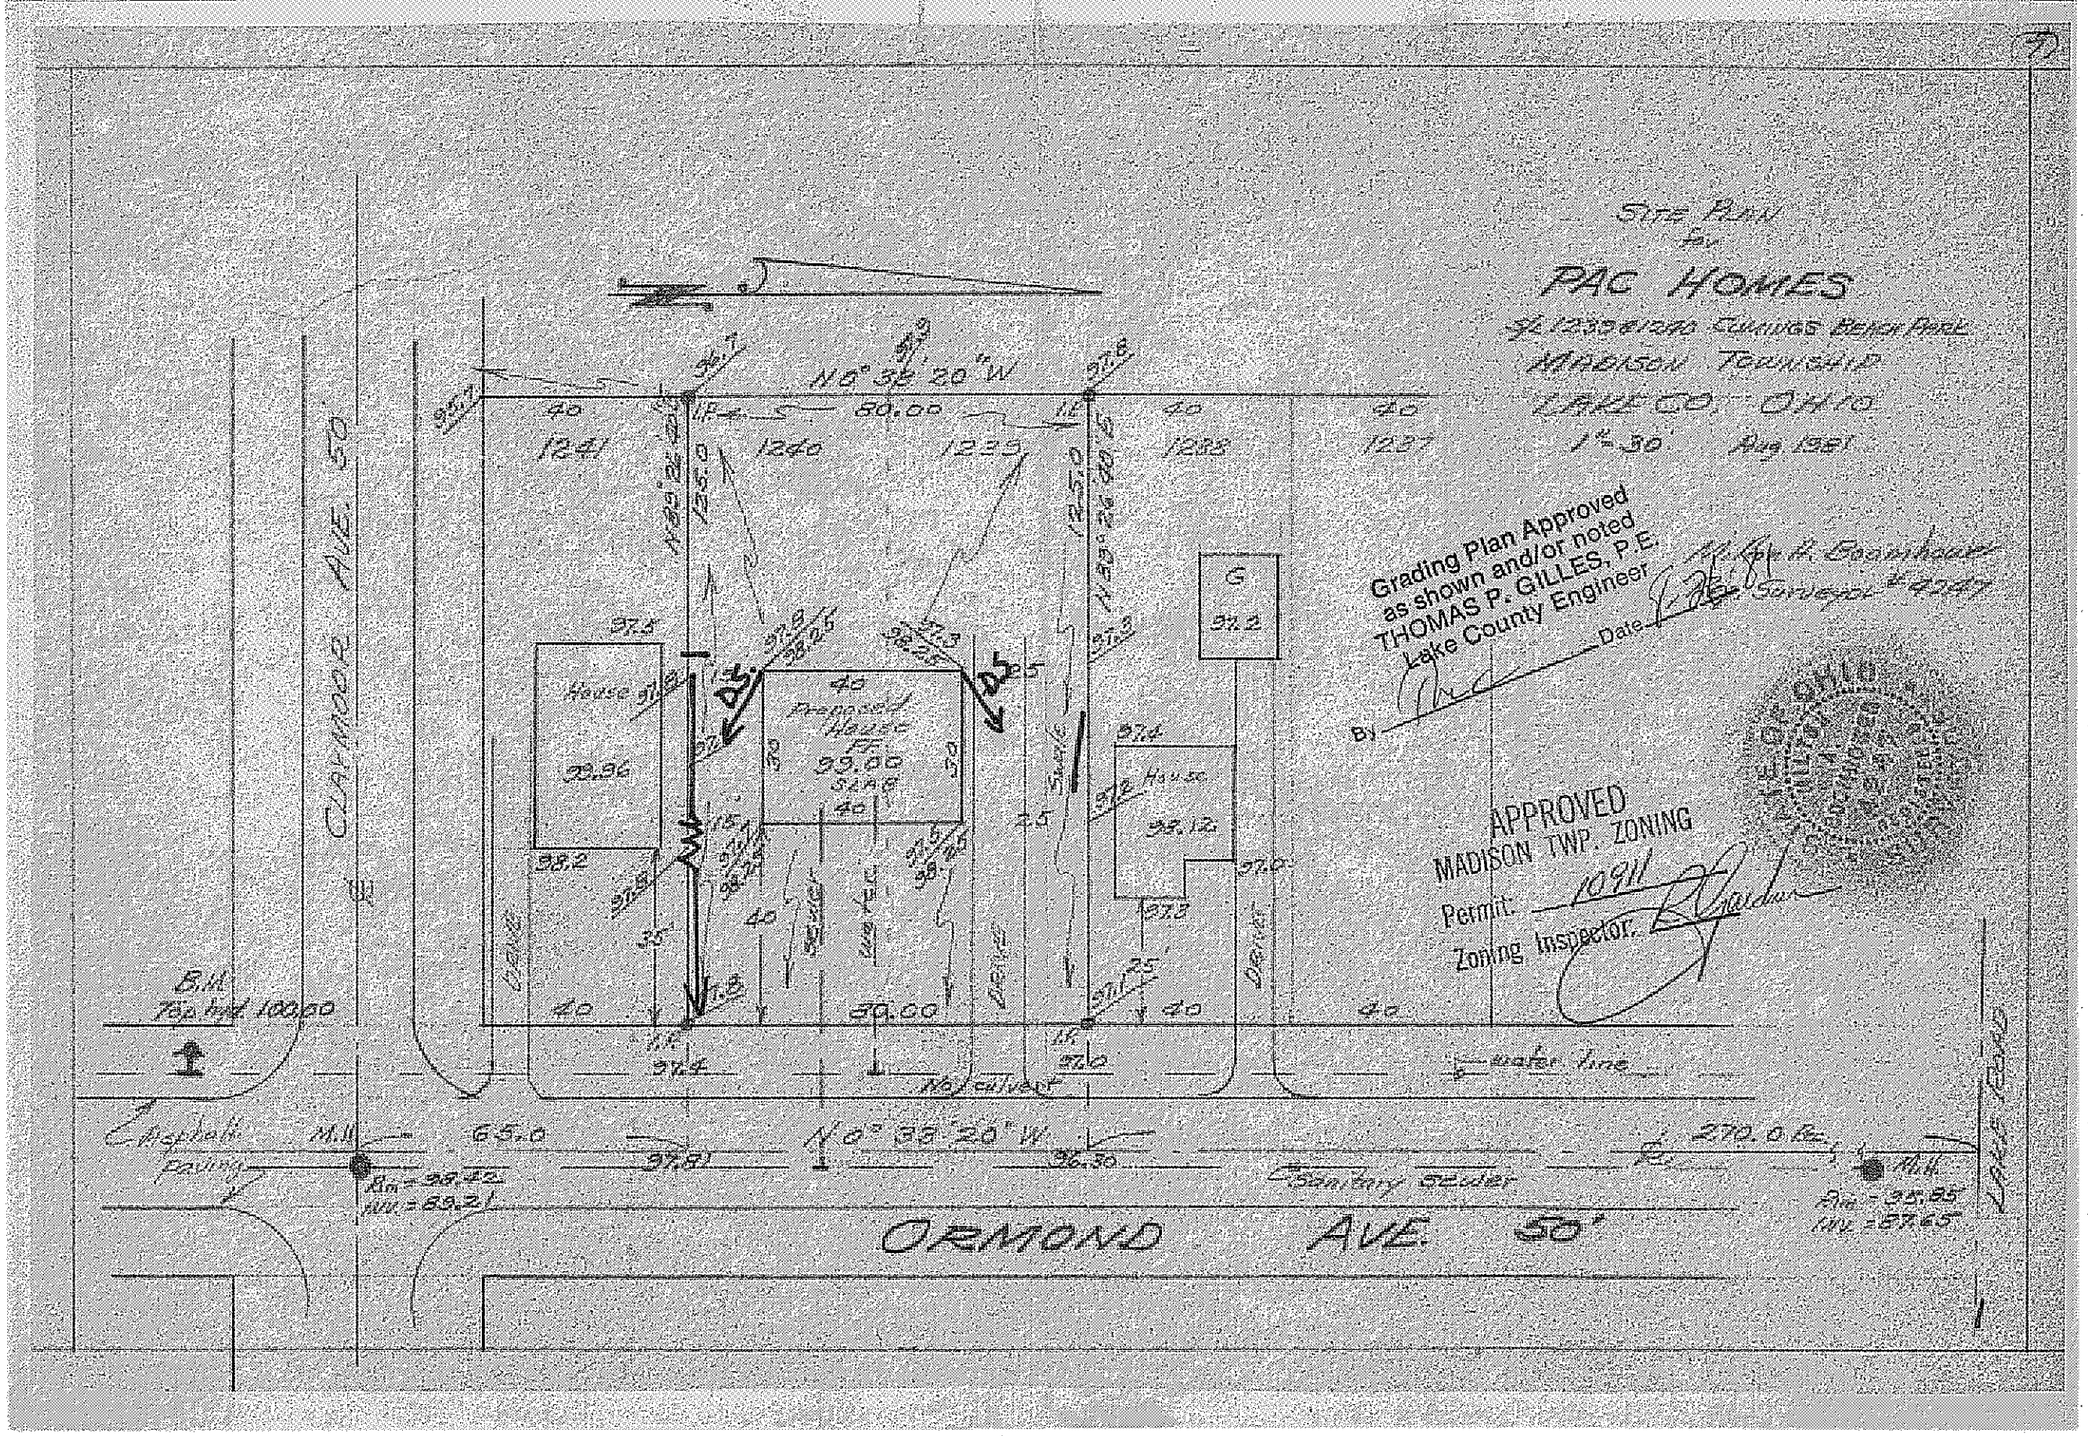

SITE PLAN
for
PAC HOMES
S/L 1239 & 1240 CUMINGS BEACH PARK
MADISON TOWNSHIP
LAKE CO. OHIO
1" = 30'
Aug 1981
Grading Plan Approved
as shown and/or noted
THOMAS P. GILLES, P.E.
Lake County Engineer
By
Date
APPROVED
MADISON TWP. ZONING
Permit: 10911
Zoning Inspector:
N 0° 33' 20" W
80.00
1241
1240
1239
1238
1237
House
99.96
Proposed House
FF
99.00
SLAB
House
98.12
G
97.2
CLAYMOOR AVE. 50
B.M.
Top hyd. 100.00
Asphalt paving
M.H.
65.0
N 0° 33' 20" W
270.0 Rc.
Sanitary sewer
water line
No culvert
ORMOND AVE. 50'
LAKE ROAD