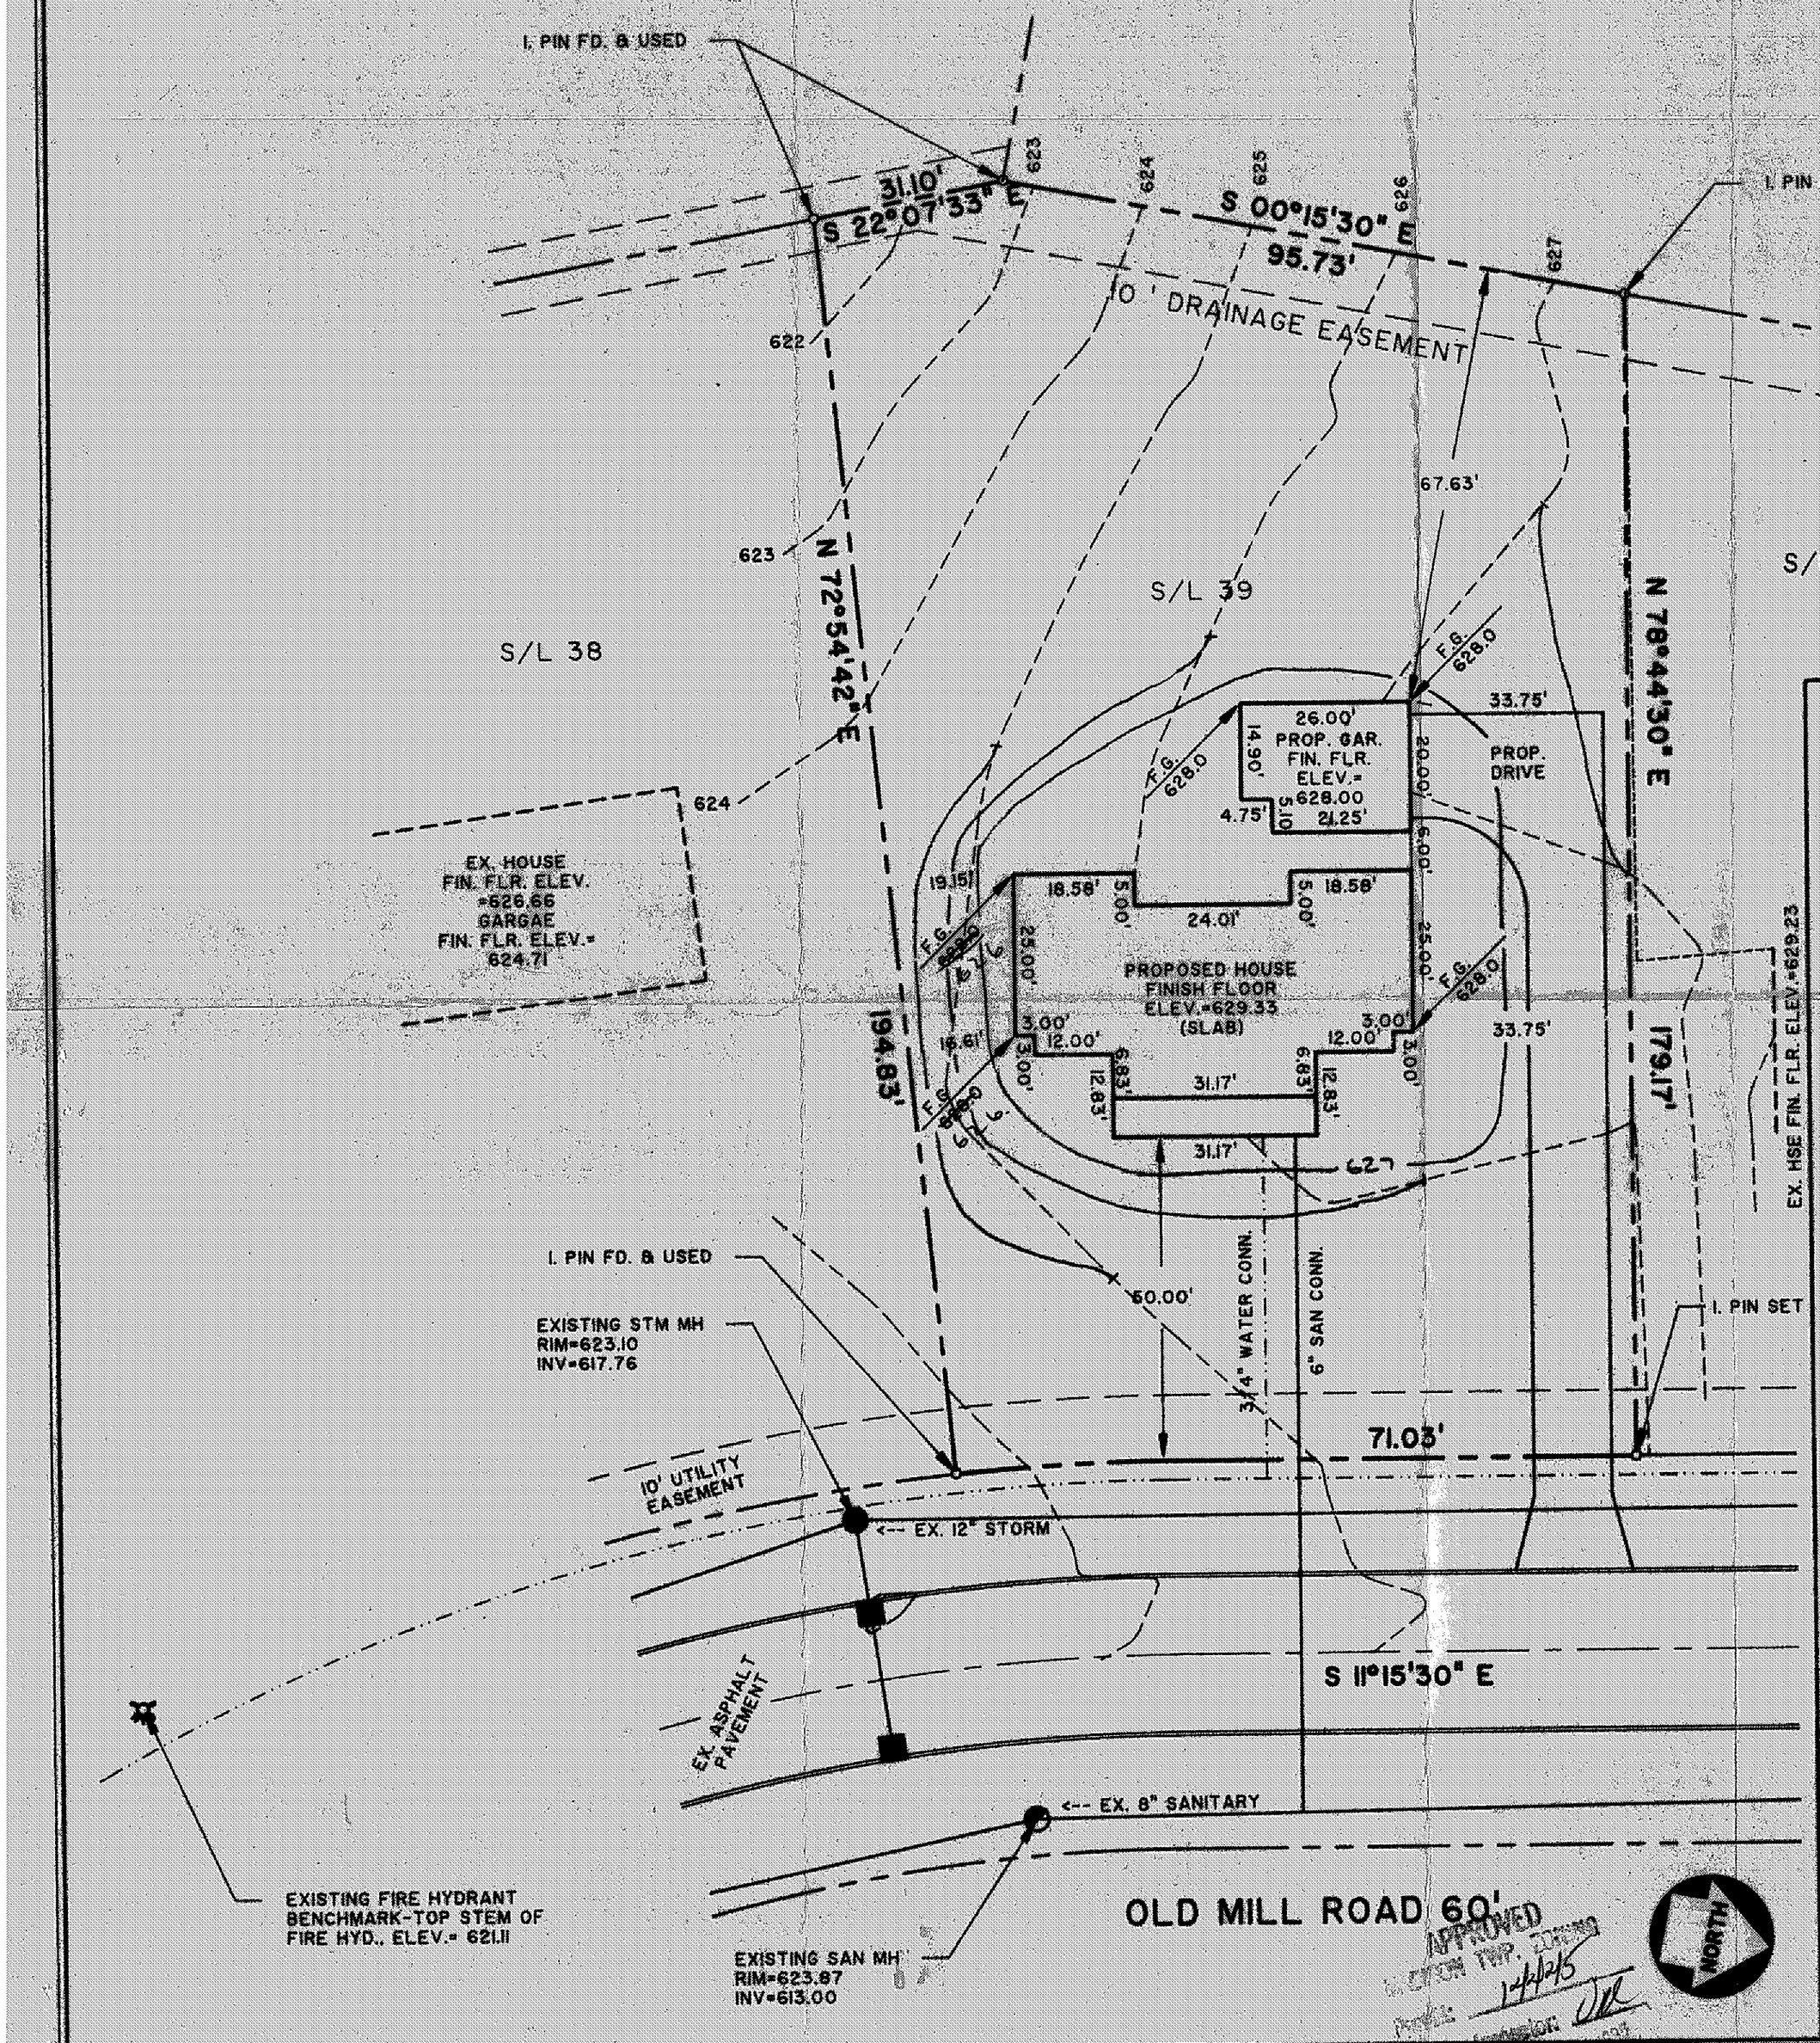

Grading Plan Approved as shown and/or noted
THOMAS P. GILLES, P.E.
Lake County Engineer
By GJH Date 1595
LOWER SOUTH F.G.'S TO 626±

GRAPHIC SCALE

20 0 10 20 40 80

(IN FEET)
1 inch = 20 ft.

GENERAL NOTES:

1. DRIVEWAY APRON TO BE 6" THICK
2. BENCHMARK - TOP STEM OF FIRE HYDRANT LOCATED IN FRONT OF SUBLOT No. 37, ELEV.=621.11

LEGEND

EXISTING CONTOUR
PROPOSED CONTOUR

100.00 / 100.00 — EXISTING ELEVATION / PROPOSED ELEVATION

CERTIFICATION

"I THE UNDERSIGNED HEREBY CERTIFY THAT THIS TOPOGRAPHY INDICATED BY 1' CONTOURS AND ELEVATIONS SHOWN HEREON REPRESENTS AN ACTUAL SURVEY MADE BY ME ON THE 22nd DAY OF DEC. , 1994 AND THE ELEVATIONS WERE TAKEN AT APPROPRIATE INTERVALS AND AS OF THAT DAY THEY EXISTED AS INDICATED HEREON.

"I HEREBY CERTIFY THAT THIS PLAN WAS PREPARED BY ME AND IS CORRECT TO THE BEST OF MY KNOWLEDGE"

DAVID W. NOVAK, P.S. No. 7507

STATE OF OHIO DAVID W. NOVAK S-7507 REGISTERED PROFESSIONAL SURVEYOR

PREPARED BY:

Himebaugh and Novak
Surveyors and Site Consultants
8663 Tyler Boulevard
Mentor, Ohio 44060-4346
(216) 974-7670, (216) 255-5900 FAX.
(4286263 Bill Aubert)

SITE PLAN:	SUBLOT NO. 39 OLD MILL ROAD, 60' MADISON RAY ZIRKLE SUB NO. 2, VOL. V, PG. 3
PREPARED FOR:	NEUBERT CONSTRUCTION, INC.
SCALE:	1" = 20'
DATE:	DEC. 28, 1994
DRAWN BY:	DAVID W. NOVAK

APPROVED MADISON TWP. ZONING 14/4/95 Project Inspector 1/5/95

94-137

REF. NO. 90-015

FORM No. A-004 (01/17/94)