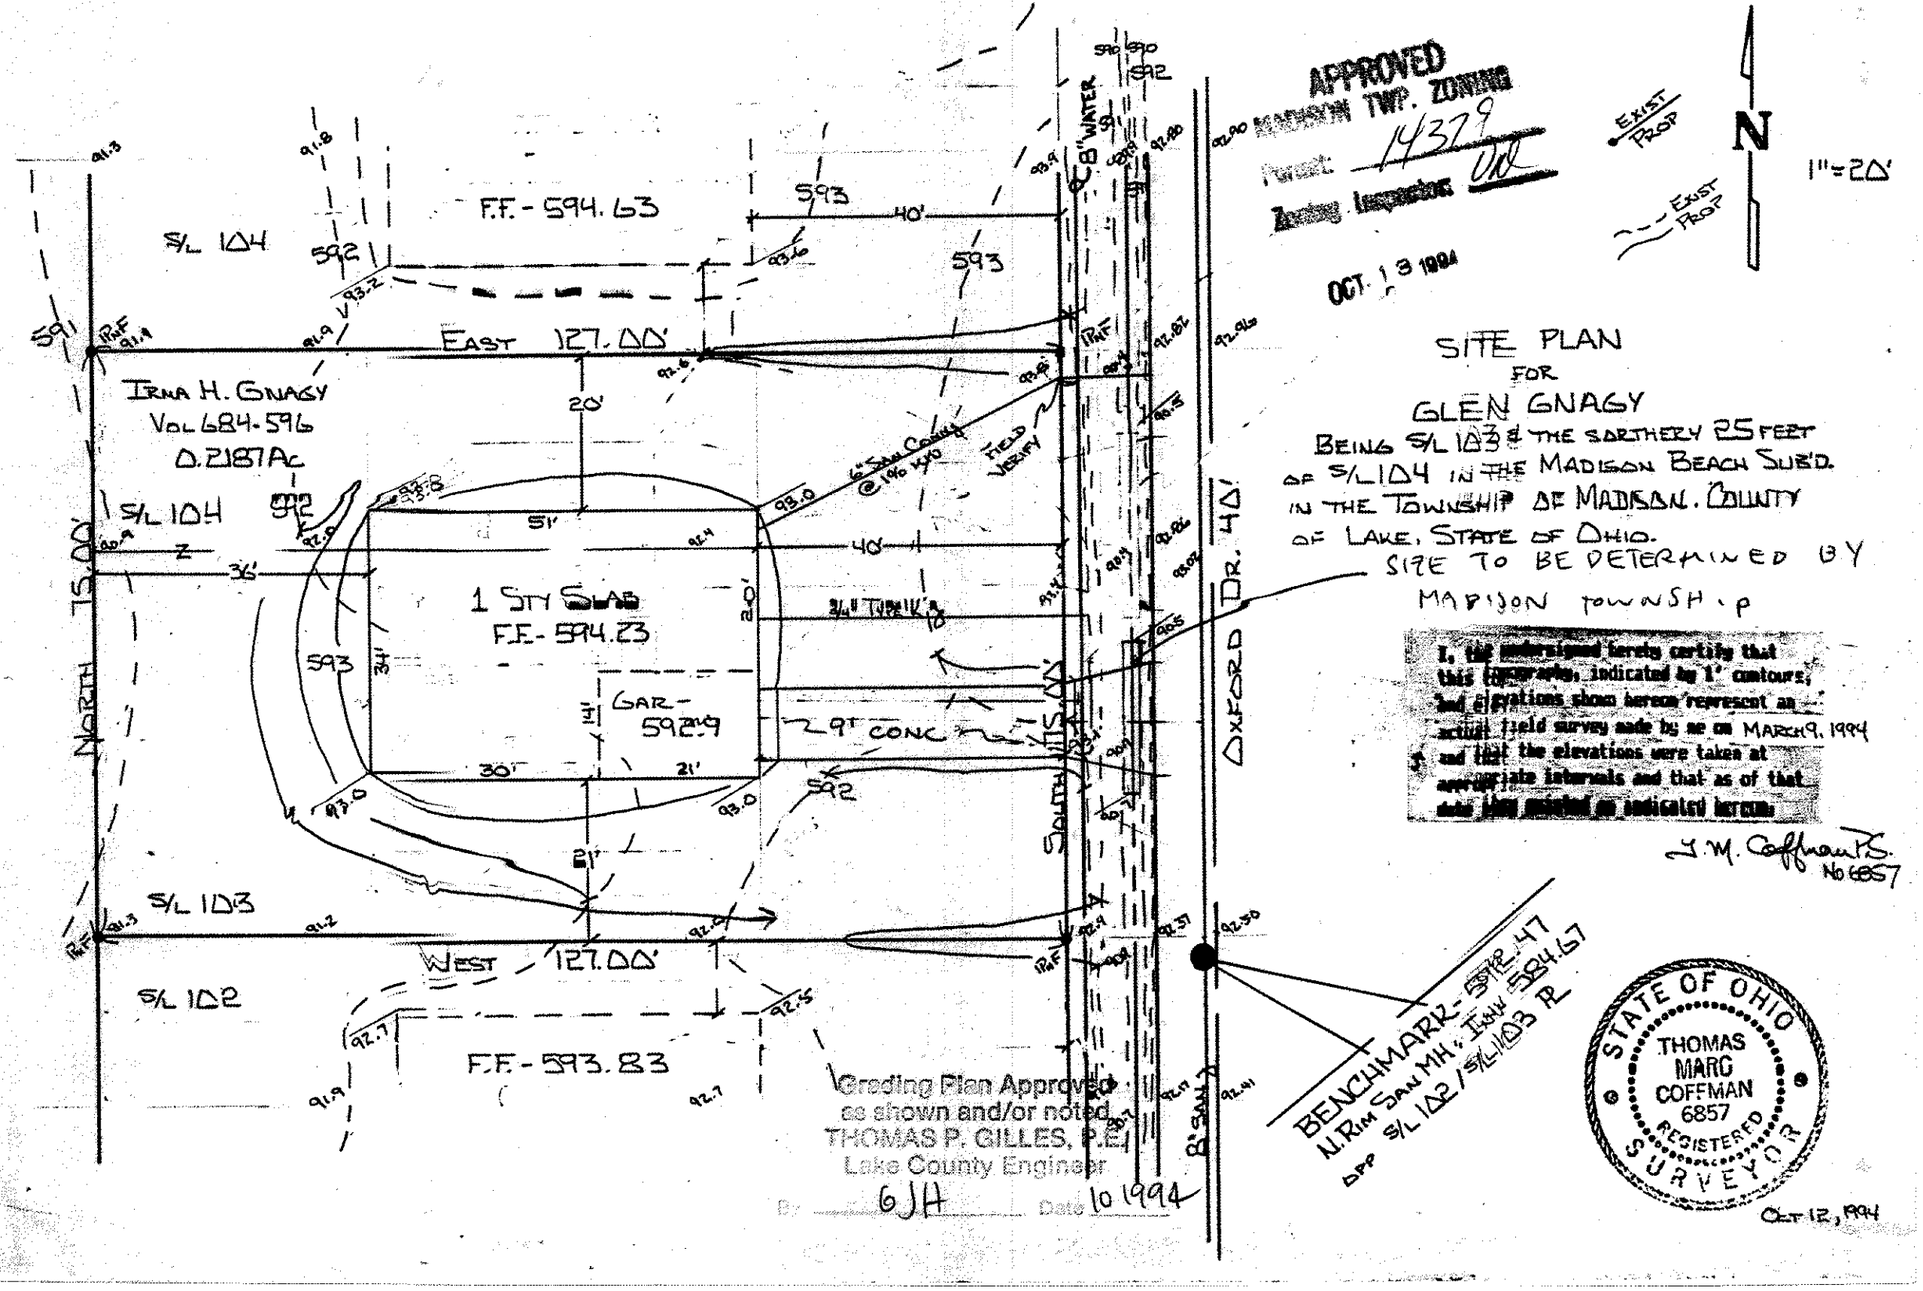
APPROVED
MADISON TWP. ZONING
Permit: 14379
Zoning Inspector: [illegible]
OCT. 13 1994
EXIST PROP
EXIST PROP
N
1"=20'
SITE PLAN
FOR
GLEN GNAGY
BEING S/L 103 & THE SORTHERY 25 FEET OF S/L 104 IN THE MADISON BEACH SUB'D. IN THE TOWNSHIP OF MADISON. COUNTY OF LAKE, STATE OF OHIO.
SIZE TO BE DETERMINED BY MADISON TOWNSHIP
I, the undersigned hereby certify that this topography, indicated by 1' contours, and elevations shown hereon represent an actual field survey made by me on MARCH 9, 1994 and that the elevations were taken at appropriate intervals and that as of that date they existed as indicated hereon.
J. M. Coffman P.S. No 6857
STATE OF OHIO
THOMAS MARC COFFMAN
6857
REGISTERED
SURVEYOR
OCT 12, 1994
Grading Plan Approved as shown and/or noted
THOMAS P. GILLES, P.E.
Lake County Engineer
By GJH Date 10 1994
F.F. - 594.63
S/L 104
EAST 127.00'
IRMA H. GNAGY
VOL 684-596
0.2187 Ac
S/L 104
1 STY SLAB
F.F. - 594.23
GAR - 592.9
9' CONC
S/L 103
WEST 127.00'
S/L 102
F.F. - 593.83
NORTH 75.00'
SOUTH 75.00'
OXFORD DR. 40'
8" WATER
8" SAN
6" SAN CONN @ 1% KYD
FIELD VERIFY
3/4" TYPE K
BENCHMARK - 592.47
N. RIM SAN MH. INV 584.67
OPP S/L 102 / S/L 103 PL