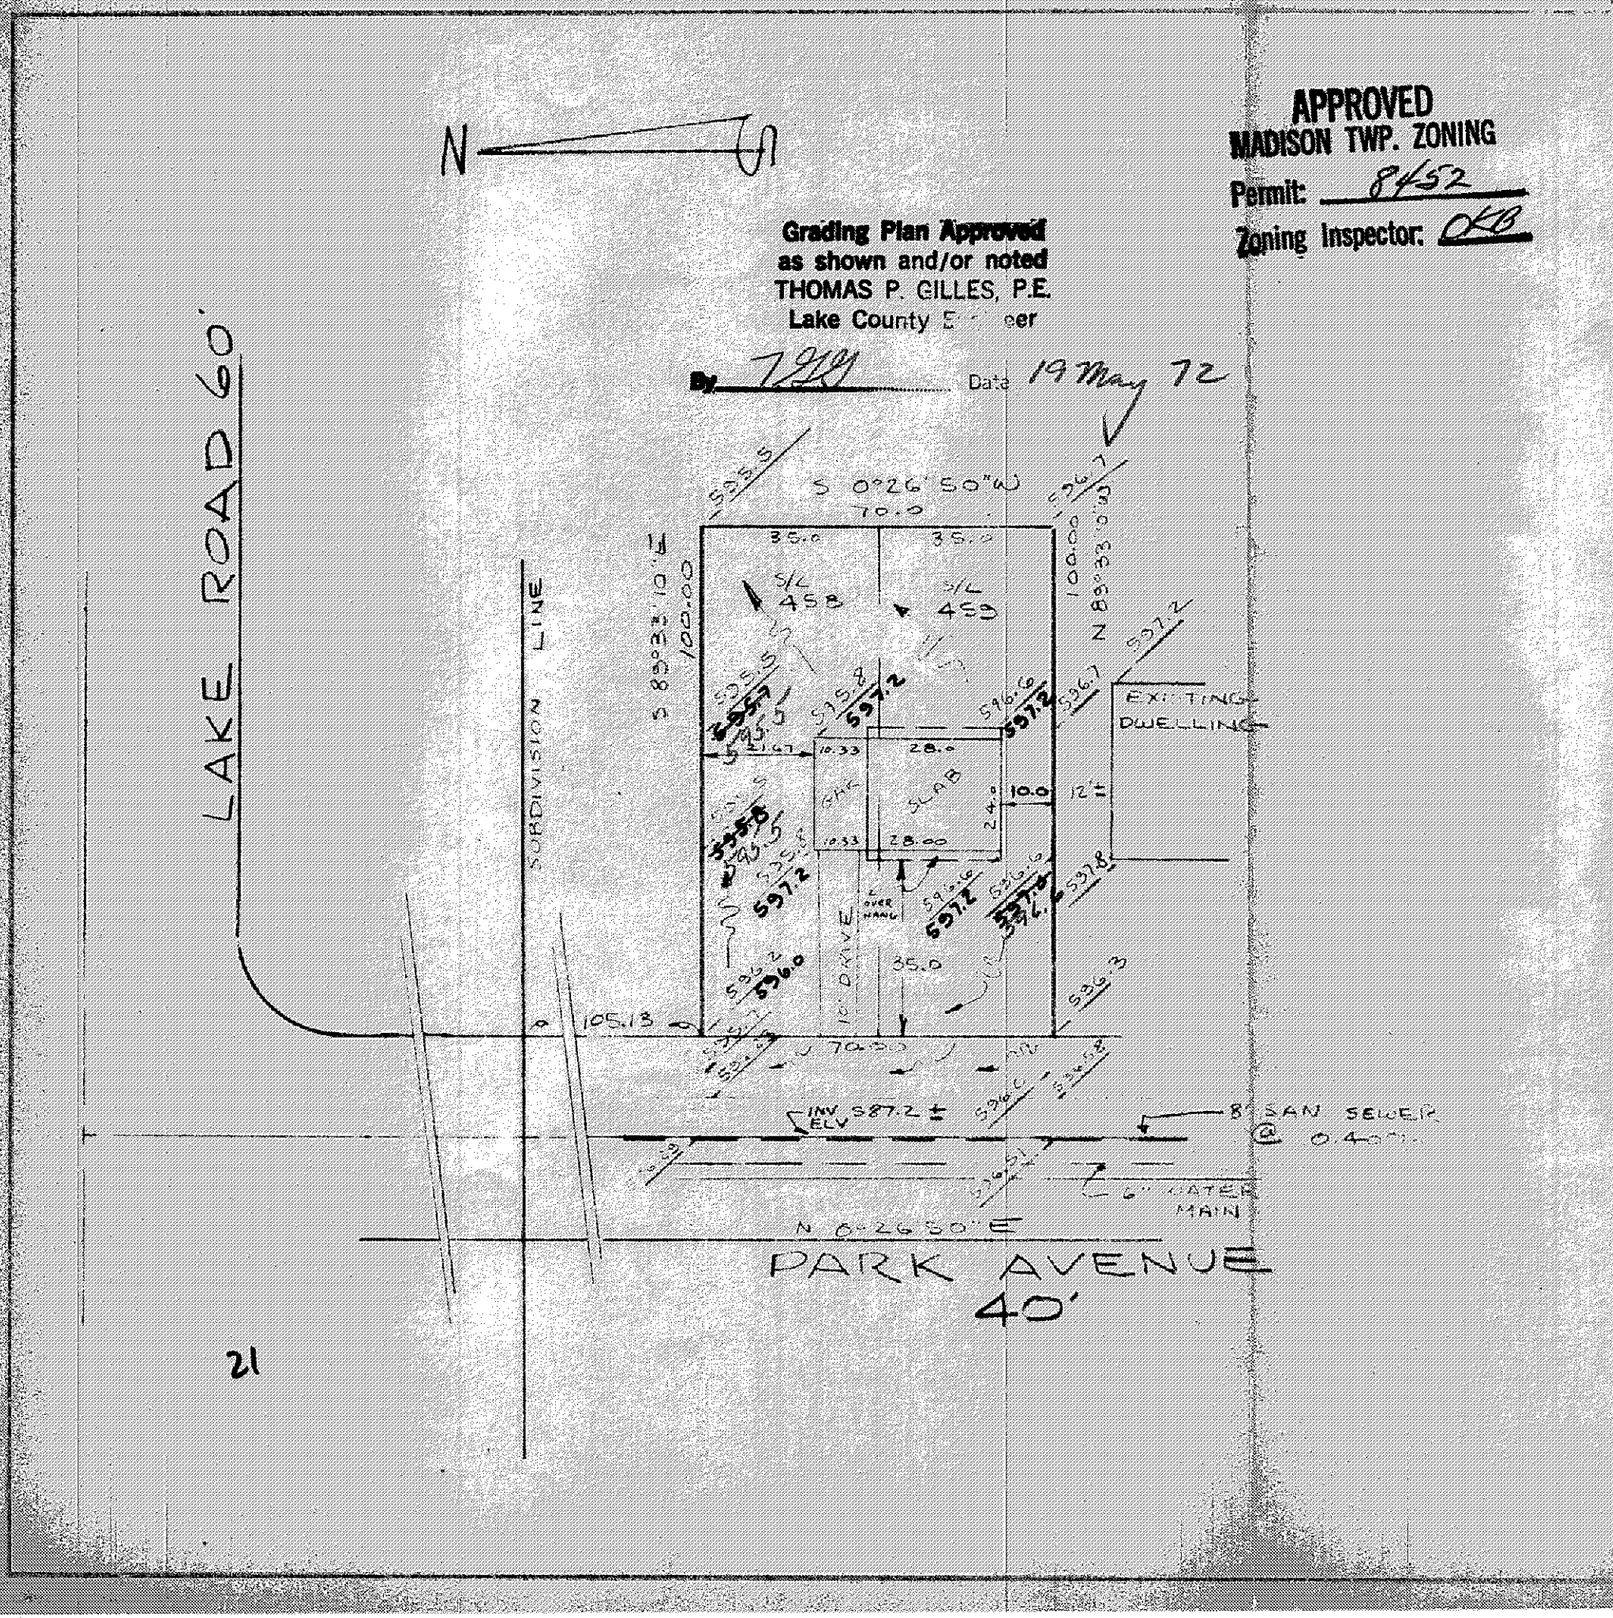

APPROVED
MADISON TWP. ZONING
Permit: 8452
Zoning Inspector: OKB

Grading Plan Approved
as shown and/or noted
THOMAS P. GILLES, P.E.
Lake County Engineer

By TGG **Date** 19 May 72

SITE PLAN

MADISON LAKE COUNTY, OHIO
TOWNSHIP

for WINSLOW HOMES INC.
CLIENT OWNER

1503 Park Ave Madison 44057
ADDRESS STREET CITY ZIP

MADISON-LAKELAND SUBD No 2
RECORD SUBDIVISION
D 52
VOLUME PAGE
458-459 PARK AVE
SUBLOT NO STREET

LOT TRACT
VOLUME PAGE
PERM PARCEL # STREET

LEGEND

SANITARY MANHOLE
STORM MANHOLE
INLET OR CATCH BASIN
HYDRANT
EXISTING CONTOURS
PROPOSED CONTOURS
EXIST ELEV 100.0 / 100.0 PROP ELEV

WATER VALVE (GAS)
WATER METER (GAS)
AS BUILT ELEVATION 100
DIRECTION OF SURFACE DRAINAGE

REMARKS

ALL BOUNDARY DATA SHOWN WAS OBTAINED FROM (DEEDS, RECORDED SUBDIVISION PLAT OR OTHER PUBLIC RECORDS)

DESIGN CERTIFICATION

THIS PLAT WAS PREPARED BY ME, AND IS CORRECT TO THE BEST OF MY KNOWLEDGE AND BELIEF

Richard J Bilski PS #5244
NAME SURVEYOR REGISTRATION NO.

CHECK LIST

DIMENSIONS
BEARINGS
TIE TO NEAREST STREET
SUBLOT NO PARCEL NO
SURROUNDING OWNERS
BLDG DIMENSIONS FIN GR
BLDG TIES FLR GRADES
APRON TYPE WIDTH THICKNESS
SIDEWALK TYPE WIDTH THICKNESS
CULVERT TYPE DIA LENGTH

WATER MAIN SIZE LOCATION
SAN SEWER SIZE % GR LOC
SAN MH CAST ELEV INV ELEV
SAN CONN SIZE LOC DEPTH
STORM SEWER SIZE % GR LOC
STORM MH CAST ELEV INV ELEV
PAVT TYPE GRADE CURBS
GAS LINE LOC SIZE PRESSURE
SEPTIC TANK SIZE LOC
WELL LOCATION

RIVISIONS		
NO	DATE	BY
1	5-10-72	RJB
2		
3		
4		
5		

PLAN PREPARED BY:

DEBEVEC-SALO & ASSOC, INC.
ENGINEERS SURVEYORS NAME
130 E JACKSON ST PAINESVILLE, O.
ADDRESS

DRAWN BY RJB	SCALE 1" = 30'	PHONE NO
CHK'D	DATE FEB '71	DRAWING NO 3309-458
CREW CHIEF	APP'D	