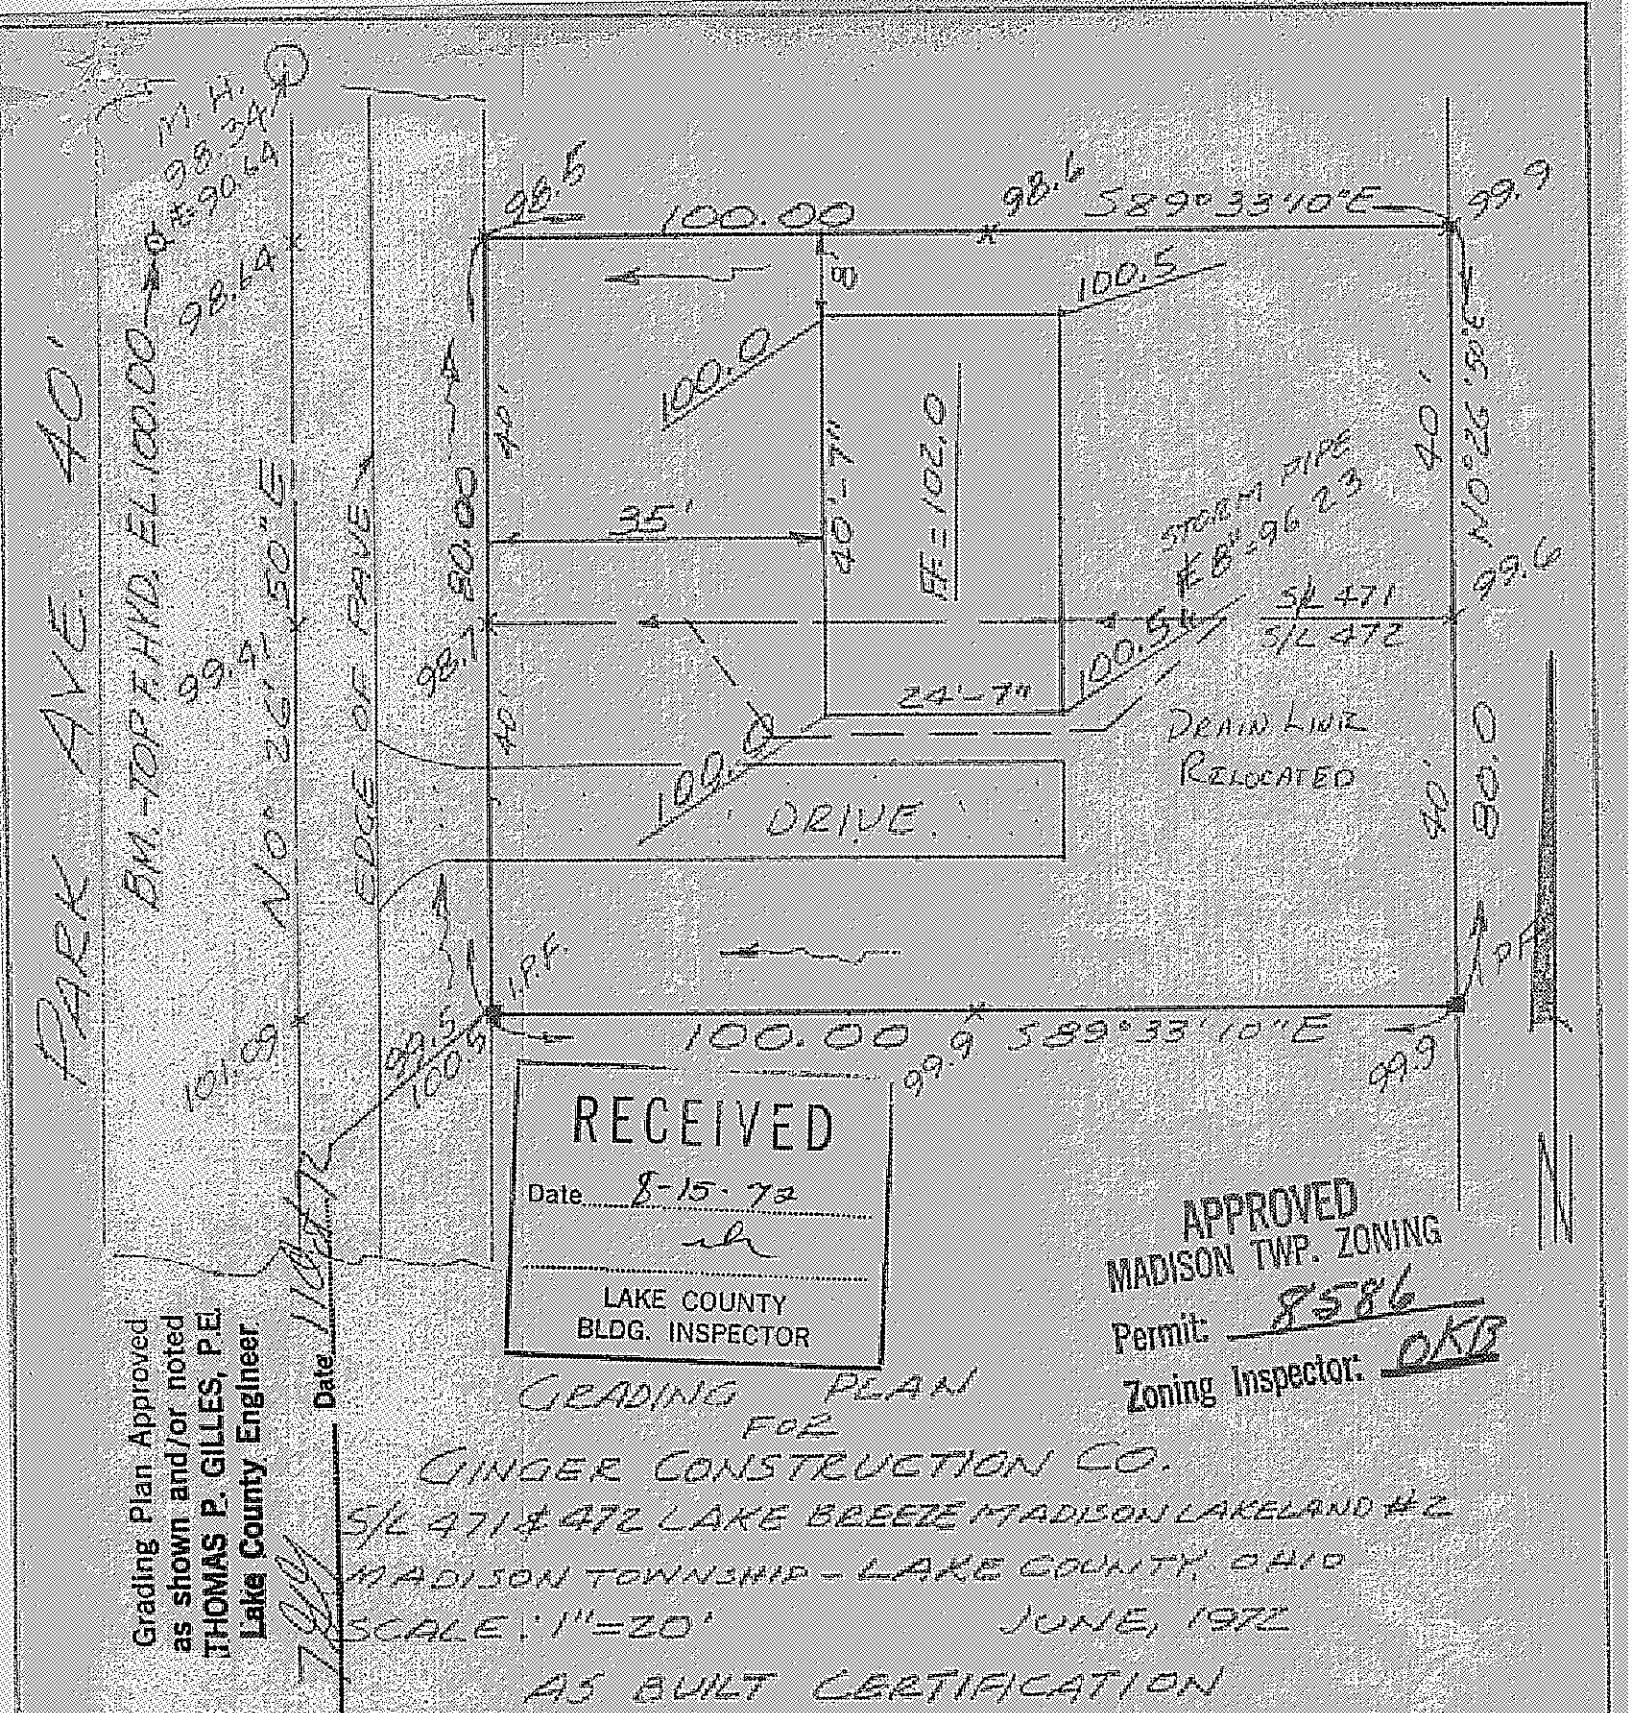

RECEIVED
Date 8-15-72
LAKE COUNTY
BLDG. INSPECTOR

APPROVED
MADISON TWP. ZONING
Permit: 8586
Zoning Inspector: OKB

Grading Plan Approved as shown and/or noted
THOMAS P. GILLES, P.E.
Lake County Engineer
Date 10-27-72
By

GRADING PLAN
FOR
GINGER CONSTRUCTION CO.
S/L 471 & 472 LAKE BREEZE MADISON LAKELAND #2
MADISON TOWNSHIP - LAKE COUNTY, OHIO
SCALE: 1" = 20' JUNE, 1972

AS BUILT CERTIFICATION

I HEREBY CERTIFY THAT THE CIRCLED GRADES ARE EXISTING FINISH GRADES CHECKED IN THE FIELD ON _____ 197__

SURVEY IS CORRECT TO THE BEST OF MY KNOWLEDGE AND BELIEF.

FULLERTON-REECE & ASSOC.

REG. SURVEYOR No. 1557