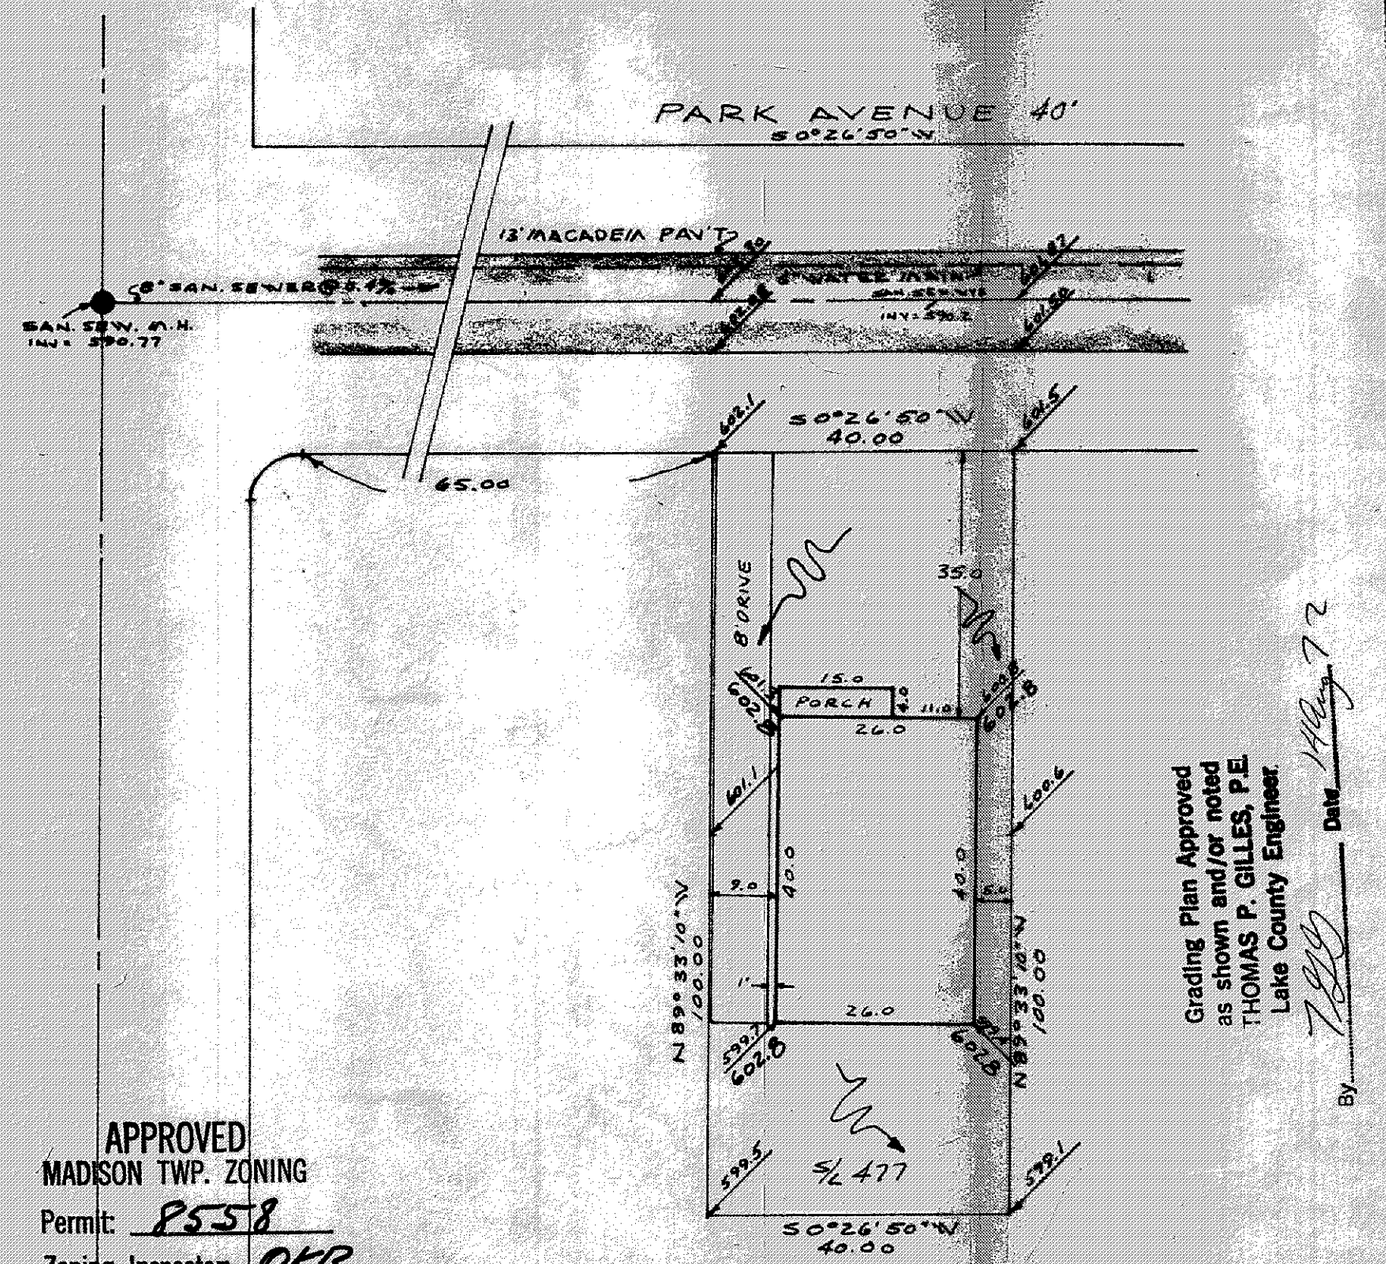

APPROVED
MADISON TWP. ZONING
Permit: 8558
Zoning Inspector: OKB

Grading Plan Approved
as shown and/or noted
THOMAS P. GILLES, P.E.
Lake County Engineer
By

SITE PLAN

Madison TOWNSHIP LAKE COUNTY, OHIO

for: Ryan Homes
CLIENT OWNER

1579 Park Ave. Madison 44057
ADDRESS STREET CITY ZIP

RECORD B	Madison Lakeland SUBDIVISION	LOT	TRACT
VOLUME 377	PAGE 52	VOLUME	PAGE
SUBLOT NO	Park Ave STREET	PERM PARCEL #	STREET

LEGEND

SANITARY MANHOLE
STORM MANHOLE
INLET OR CATCH BASIN
HYDRANT
EXISTING CONTOURS
PROPOSED CONTOURS 100.0
EXIST. ELEV. 100.0 PROP. ELEV.
WATER VALVE (GAS)
WATER METER (GAS)
AS BUILT ELEVATION
DIRECTION OF SURFACE DRAINAGE

REMARKS

ALL BOUNDARY DATA SHOWN WAS OBTAINED FROM (DEEDS, RECORDED SUBDIVISION PLAT, OR OTHER PUBLIC RECORDS)

DESIGN CERTIFICATION

THIS PLAT WAS PREPARED BY ME, AND IS CORRECT TO THE BEST OF MY KNOWLEDGE AND BELIEF.

Richard R. Hayfield P.S. #5506
NAME SURVEYOR REGISTRATION NO.

CHECK LIST

DIMENSIONS
BEARINGS
TIE TO NEAREST STREET
SUBLOT NO PARCEL NO
SURROUNDING OWNERS
BLDG DIMENSIONS FIN GR
BLDG TIES FLR GRADES
APRON TYPE WIDTH THICKNESS
SIDEWALK TYPE WIDTH THICKNESS
CULVERT TYPE DIA LENGTH

WATER MAIN SIZE LOCATION
SAN SEWER SIZE % GR. LOC.
SAN M.H. CAST ELEV. INV ELEV.
SAN CONN SIZE LOC. DEPTH
STORM SEWER SIZE % GR. LOC.
STORM M.H. CAST ELEV. INV. ELEV.
PAVT TYPE GRADE CURBS
GAS LINE LOC. SIZE PRESSURE
SEPTIC TANK SIZE LOC.
WELL LOCATION

REVISIONS		
NO	DATE	BY
1		
2		
3		
4		
5		

PLAN PREPARED BY:
DE DEVEC, SALO & ASSOC., INC.
CIVIL ENGINEERS - SURVEYORS NAME
150 E. JACKSON ST PAINESVILLE, O. ADDRESS

DRAWN BY S. Salo 72	SCALE 1"=20'	PROJECT	
CHK'D R.H.	DATE 6-26-72	DRAWING NO	3528
CREW C. Hill	REV'D		

11X17 PRINTED ON NO. 1000H CLEARPRINT