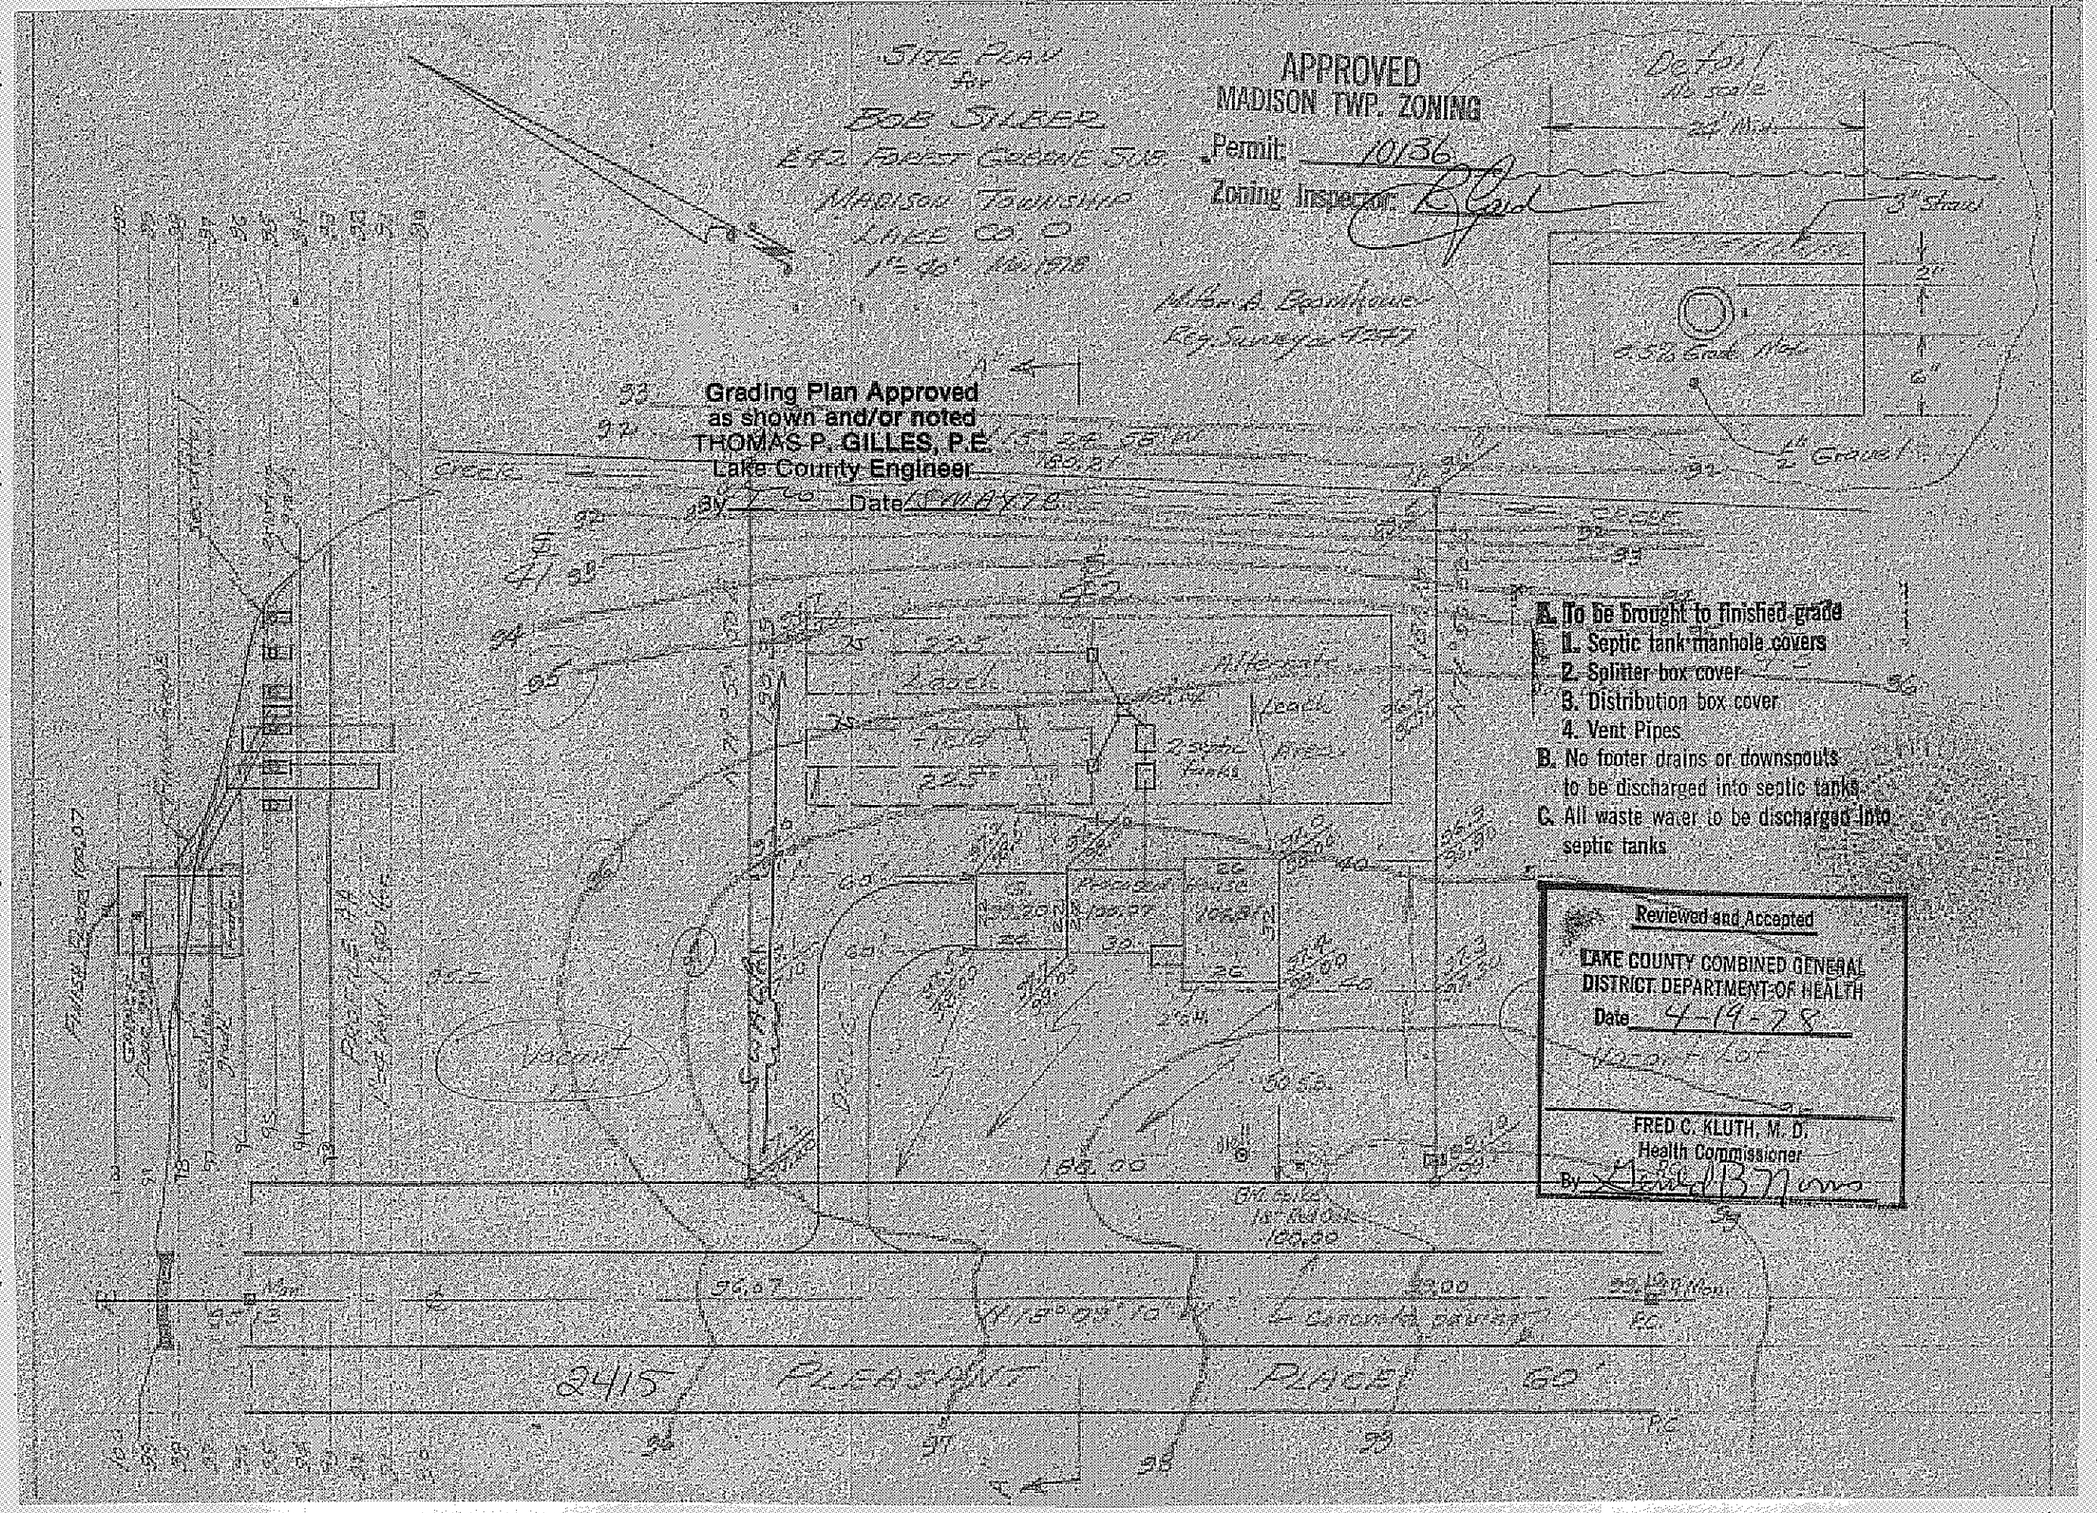

SITE PLAN
for
BOB SILBER
242 FOREST GREENE SUB.
MADISON TOWNSHIP
LAKE CO. O
1"=40' Mar 1978
APPROVED
MADISON TWP. ZONING
Permit: 10136
Zoning Inspector:
Grading Plan Approved
as shown and/or noted
THOMAS P. GILLES, P.E.
Lake County Engineer
By
Date 15 MAY 78
Detail
No scale
3" Strand
2"
6"
1/2" Gravel
A. To be brought to finished grade
1. Septic tank manhole covers
2. Splitter box cover
3. Distribution box cover
4. Vent Pipes
B. No footer drains or downspouts to be discharged into septic tanks
C. All waste water to be discharged into septic tanks
Reviewed and Accepted
LAKE COUNTY COMBINED GENERAL DISTRICT DEPARTMENT OF HEALTH
Date 4-19-78
FRED C. KLUTH, M. D.
Health Commissioner
By
Vacant
2415 PLEASANT PLACE 60'