SITE PLAN
FOR
TOM REED. GEN'L CONTRACTOR
BEING SUBLOT 16 IN THE MADISON
PALISADES. TOWNSHIP OF MADISON.
COUNTY OF LAKE. STATE OF OHIO

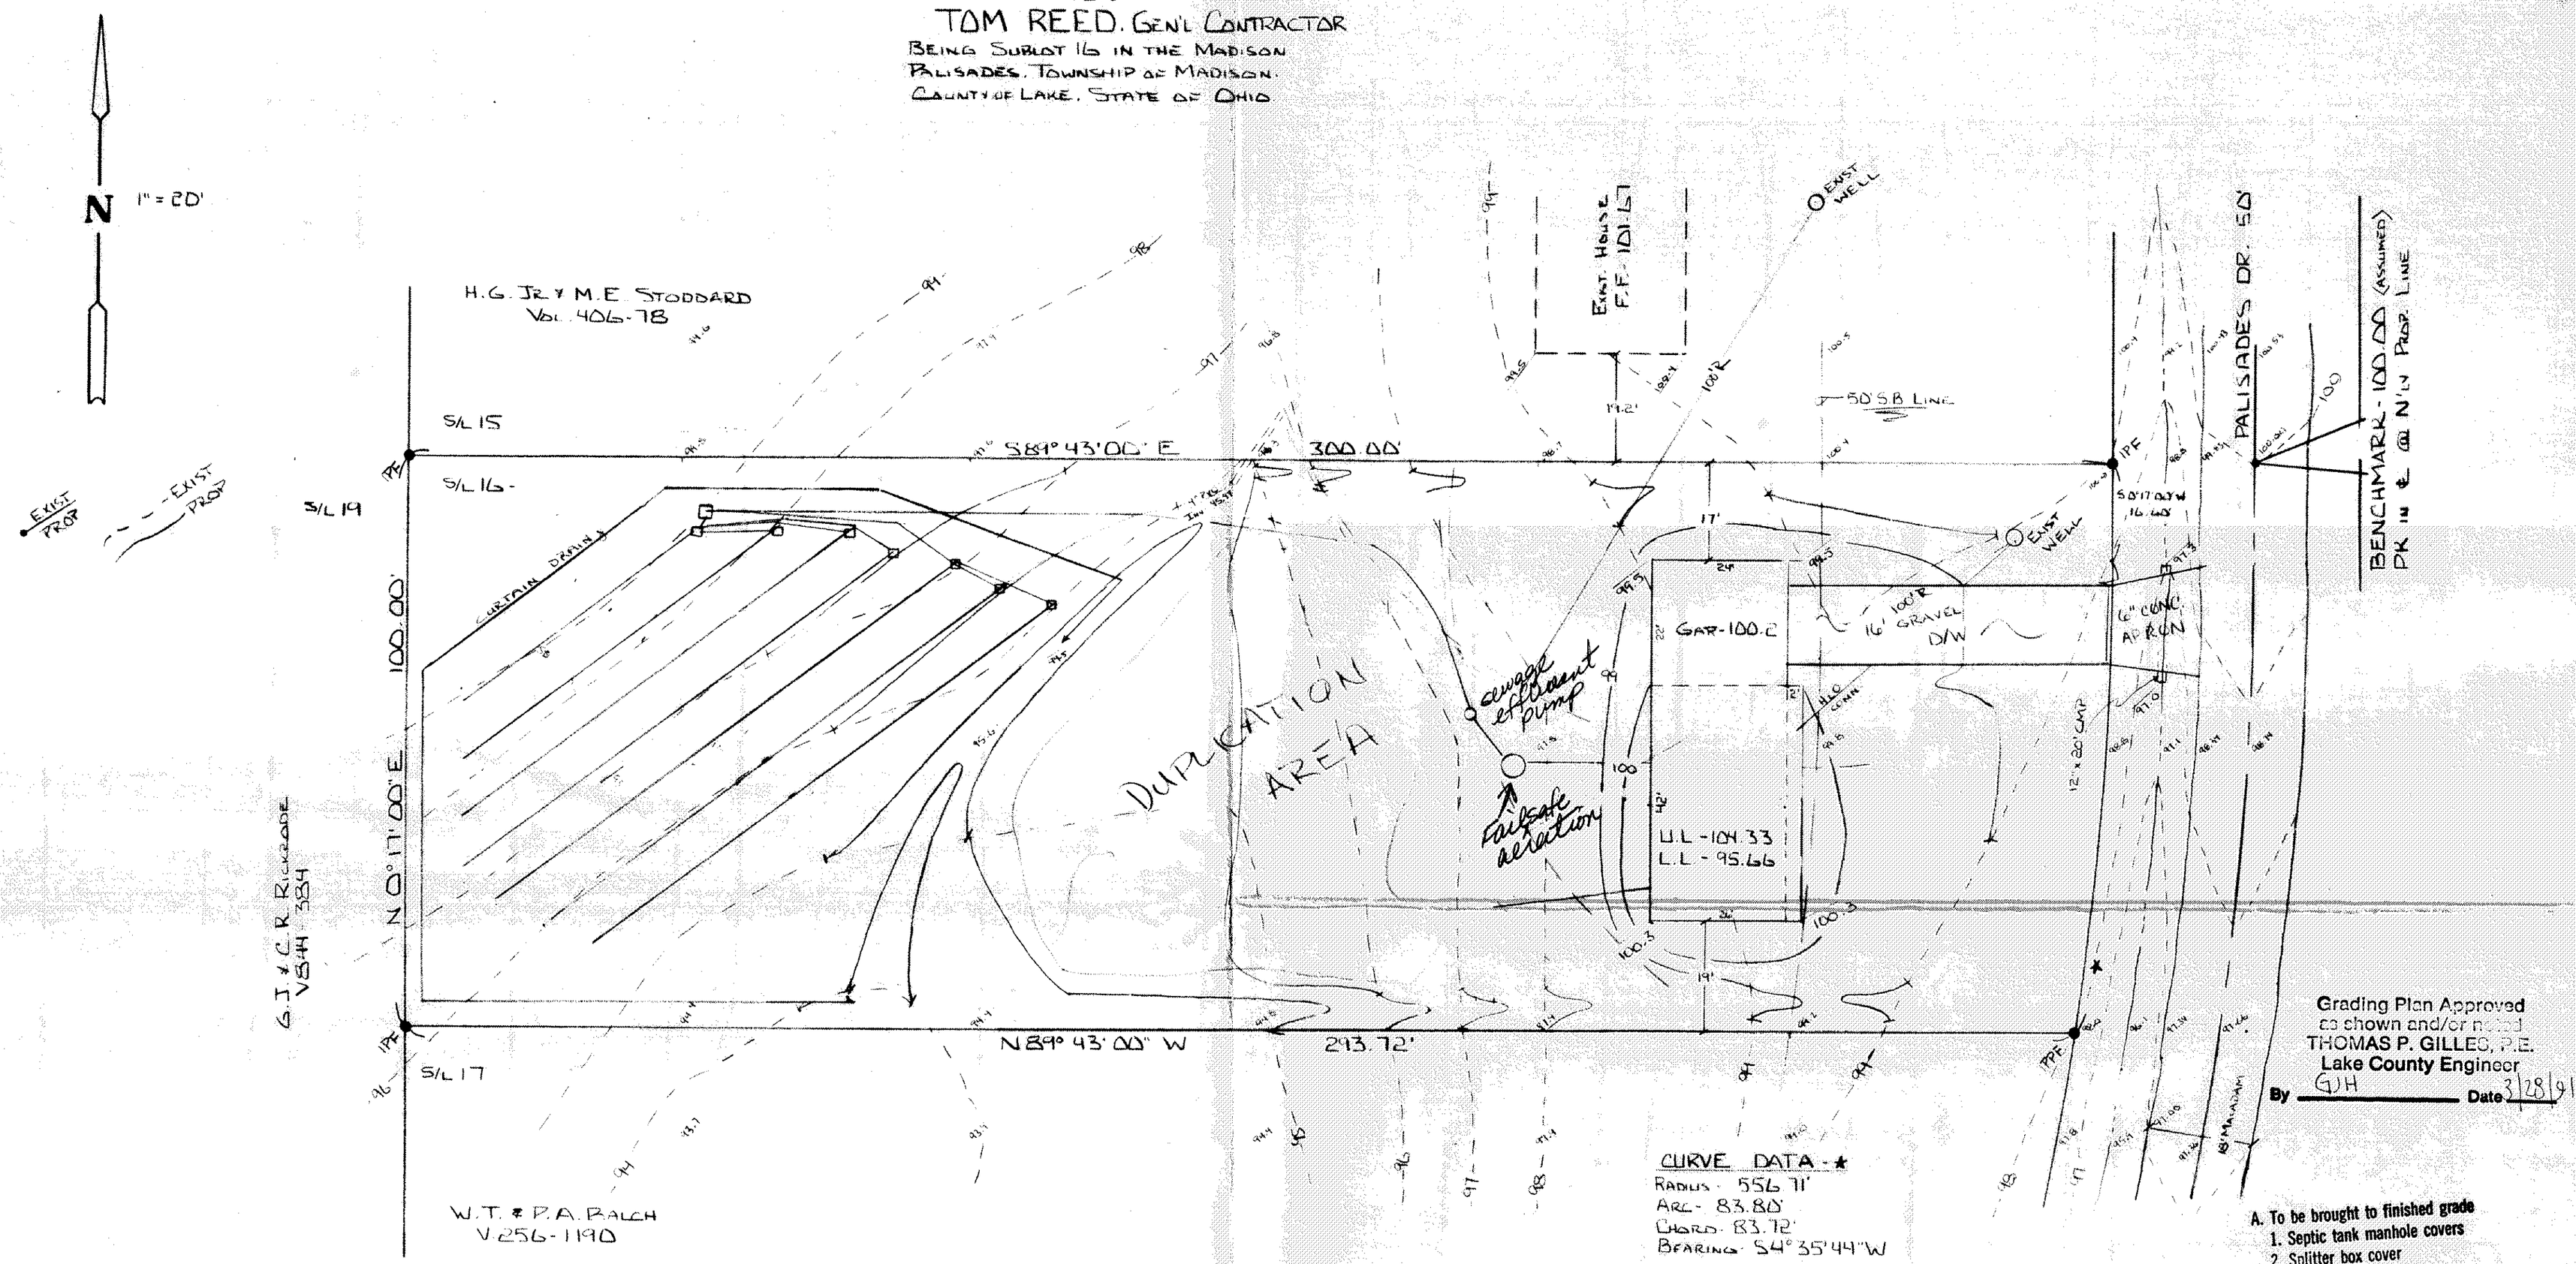

Grading Plan Approved
as shown and/or noted
THOMAS P. GILLES, P.E.
Lake County Engineer
By GJH Date 3/28/91

A. To be brought to finished grade
1. Septic tank manhole covers
2. Splitter box cover
3. Distribution box cover

B. No footer drains or downspouts to be discharged into septic tanks

C. All wise water to be discharged into septic tanks

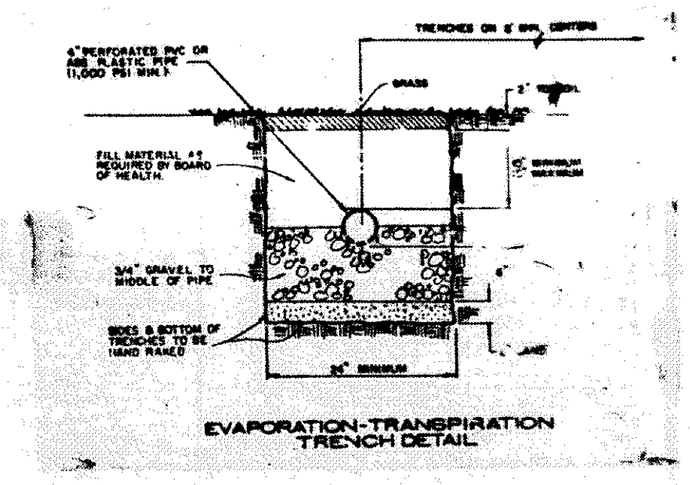

EVAPORATION-TRANSPIRATION TRENCH DETAIL

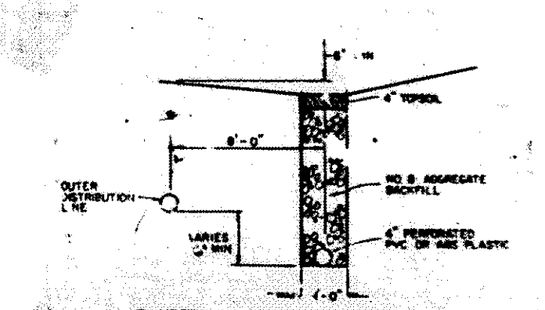

CURTAIN DRAIN DETAIL

I, the undersigned hereby certify that this topography, indicated by 1' contours, and elevations shown hereon represent an actual field survey made by me on 8-23-90 and that the elevations were taken at appropriate intervals and that as of that date they existed as indicated hereon.

STATE OF OHIO
THOMAS MARC COFFMAN
6857
REGISTERED

T.M. Coffman P.S. No. 6857

3 BEDROOM BI-LEVEL HOME
HYDRAULIC PROFILE
VERT. 1" = 4' HORZ 1" = 4'

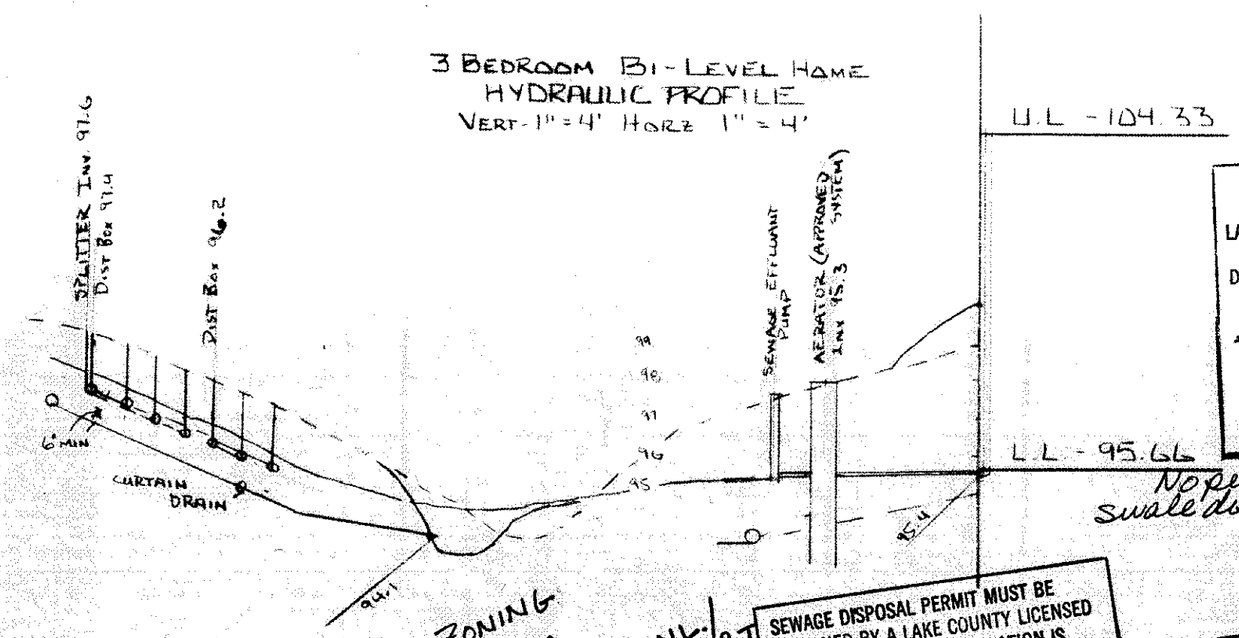

Reviewed and Accepted
LAKE COUNTY GENERAL HEALTH DISTRICT
Date 2-28-91
See Notes below
JOEL LUCIA, R.S., M.P.H.
Health Commissioner
By Laura Kramer Kunz

No permit to be issued until swale discharge has been established on neighboring property

ZONING
#12942
2/13/91 PER: VL/C.T.

SEWAGE DISPOSAL PERMIT MUST BE OBTAINED BY A LAKE COUNTY LICENSED INSTALLER BEFORE INSTALLATION IS STARTED.

LOW YIELD WATER FIXTURES REQUIRED ON ALL:
__ Shower Head
__ Toilet
__ _____