SCALE: 1"=20'

SITE PLAN
FOR
TOM REED GEN'L CONTRACTOR
BEING S/L No. 17 AND PART OF S/L No. 18 IN THE MADISON PALISADES SUBDIVISION IN MADISON TOWNSHIP, LAKE COUNTY, OHIO.

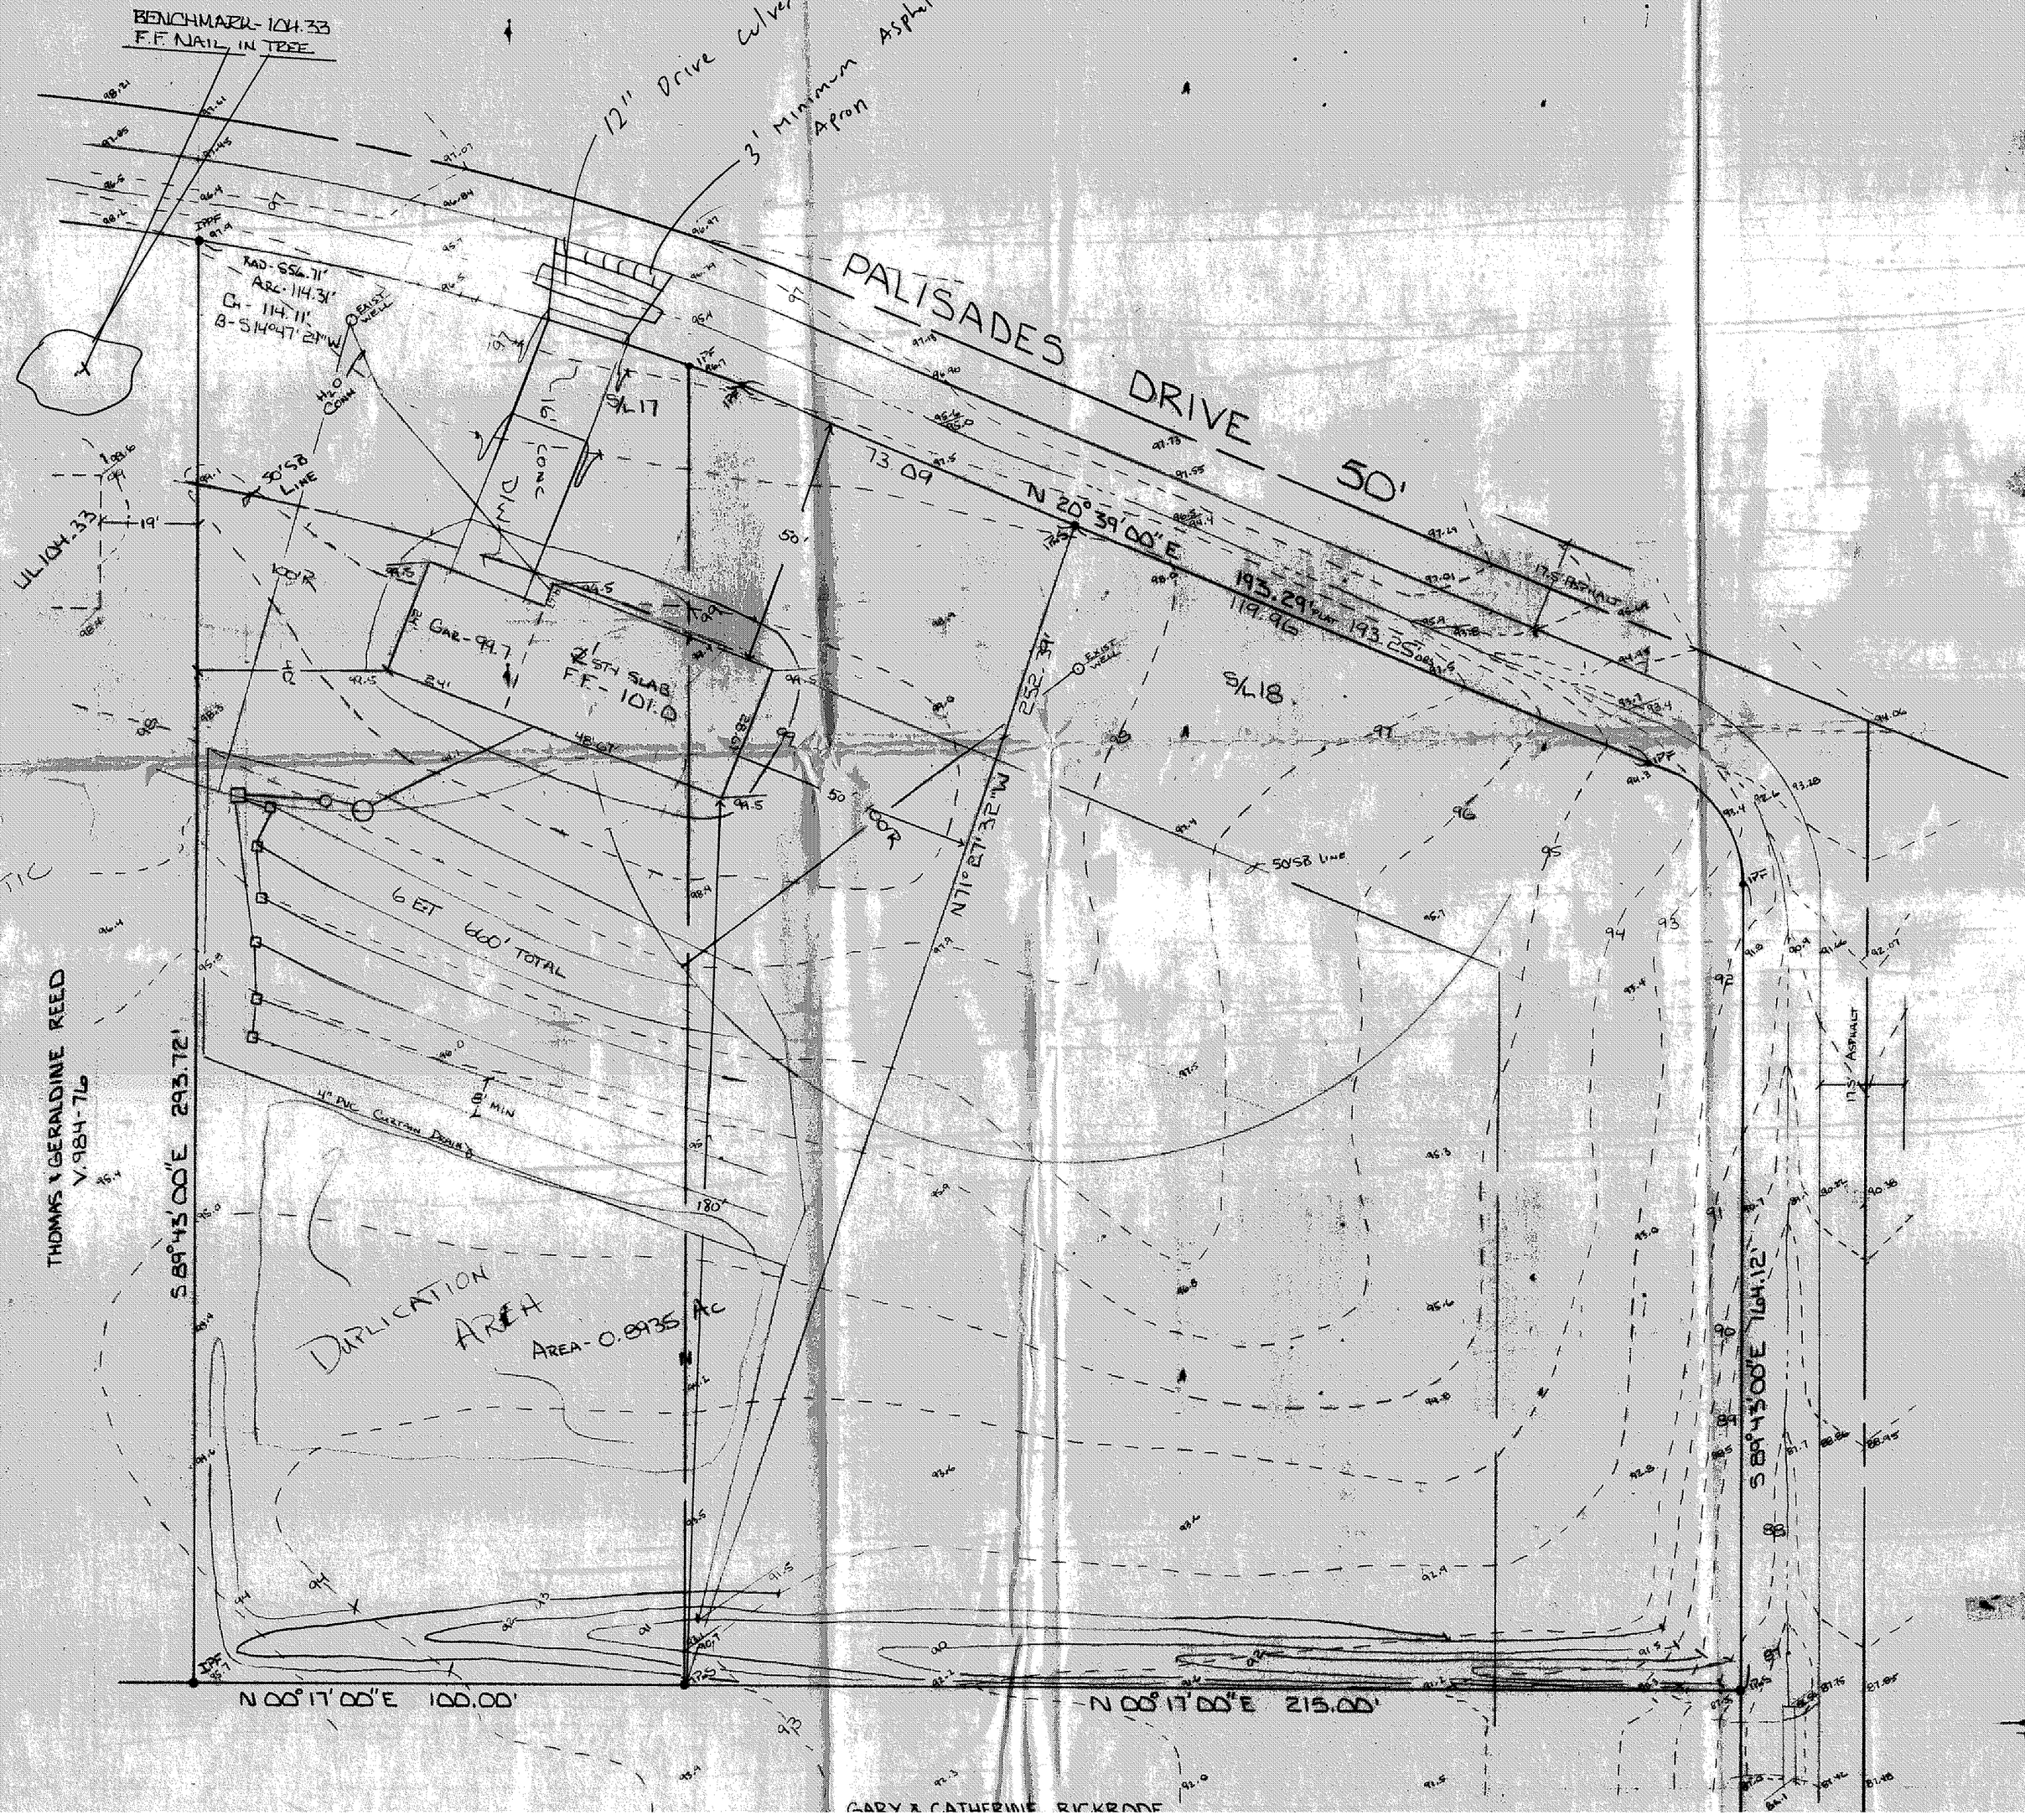

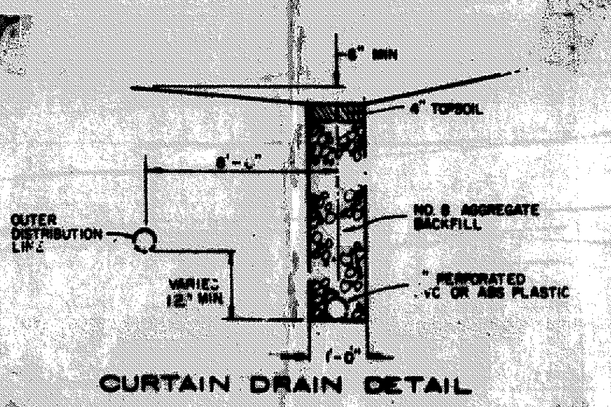

CURTAIN DRAIN DETAIL

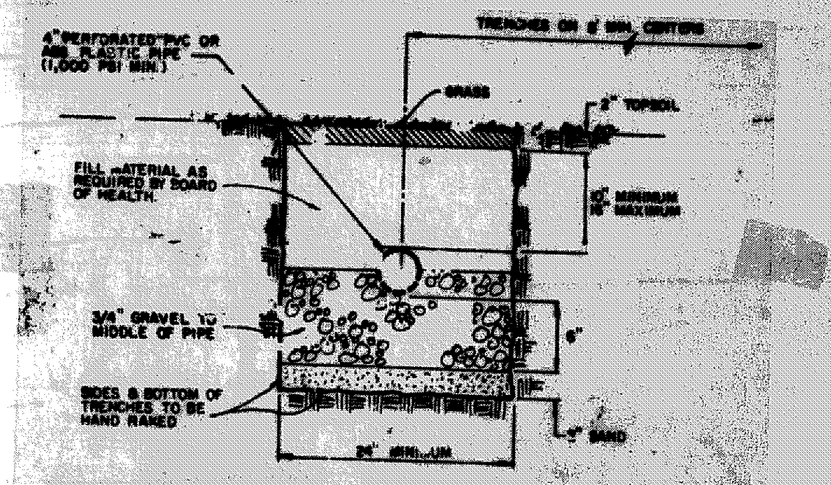

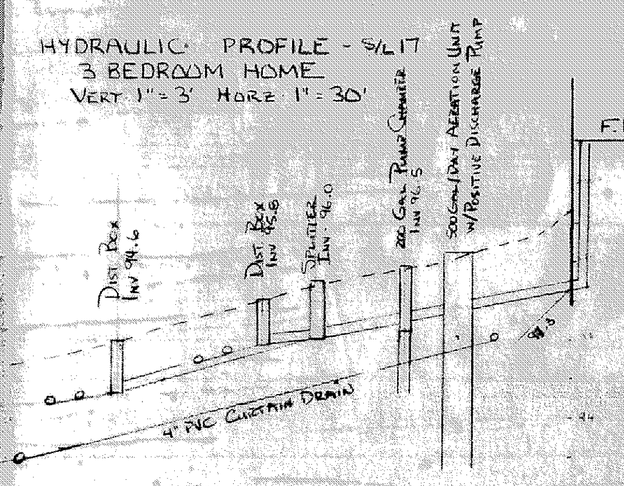

Grading Plan Approved
as shown and/or noted
THOMAS P. GILLES, P.E.
Lake County Engineer
By GJH Date 7-19-96
- Health Department Approval Required
- 12" Drive culvert
- 3' minimum Asphalt Apron

APPROVED
MADISON TOWNSHIP ZONING
JUN 28 1996
PERMIT # 14993
ZONING INSPECTOR

I, the undersigned hereby certify this topography, indicated by 1' contours, and elevations shown hereon represent an actual field survey by me on MARCH 12, 1996 and that the were taken at appropriate intervals and that as of that date they existed as indicated hereon.

THOMAS M. HOFFMAN P.S. No. 6857

STATE OF OHIO — THOMAS M. HOFFMAN — 6857 — REGISTERED SURVEYOR

APRIL 23, 1996

VILLAGE SURVEYING CO.
P.O. BOX 1096, FAIRPORT HARBOR, OHIO 44077
(216) 357-1359