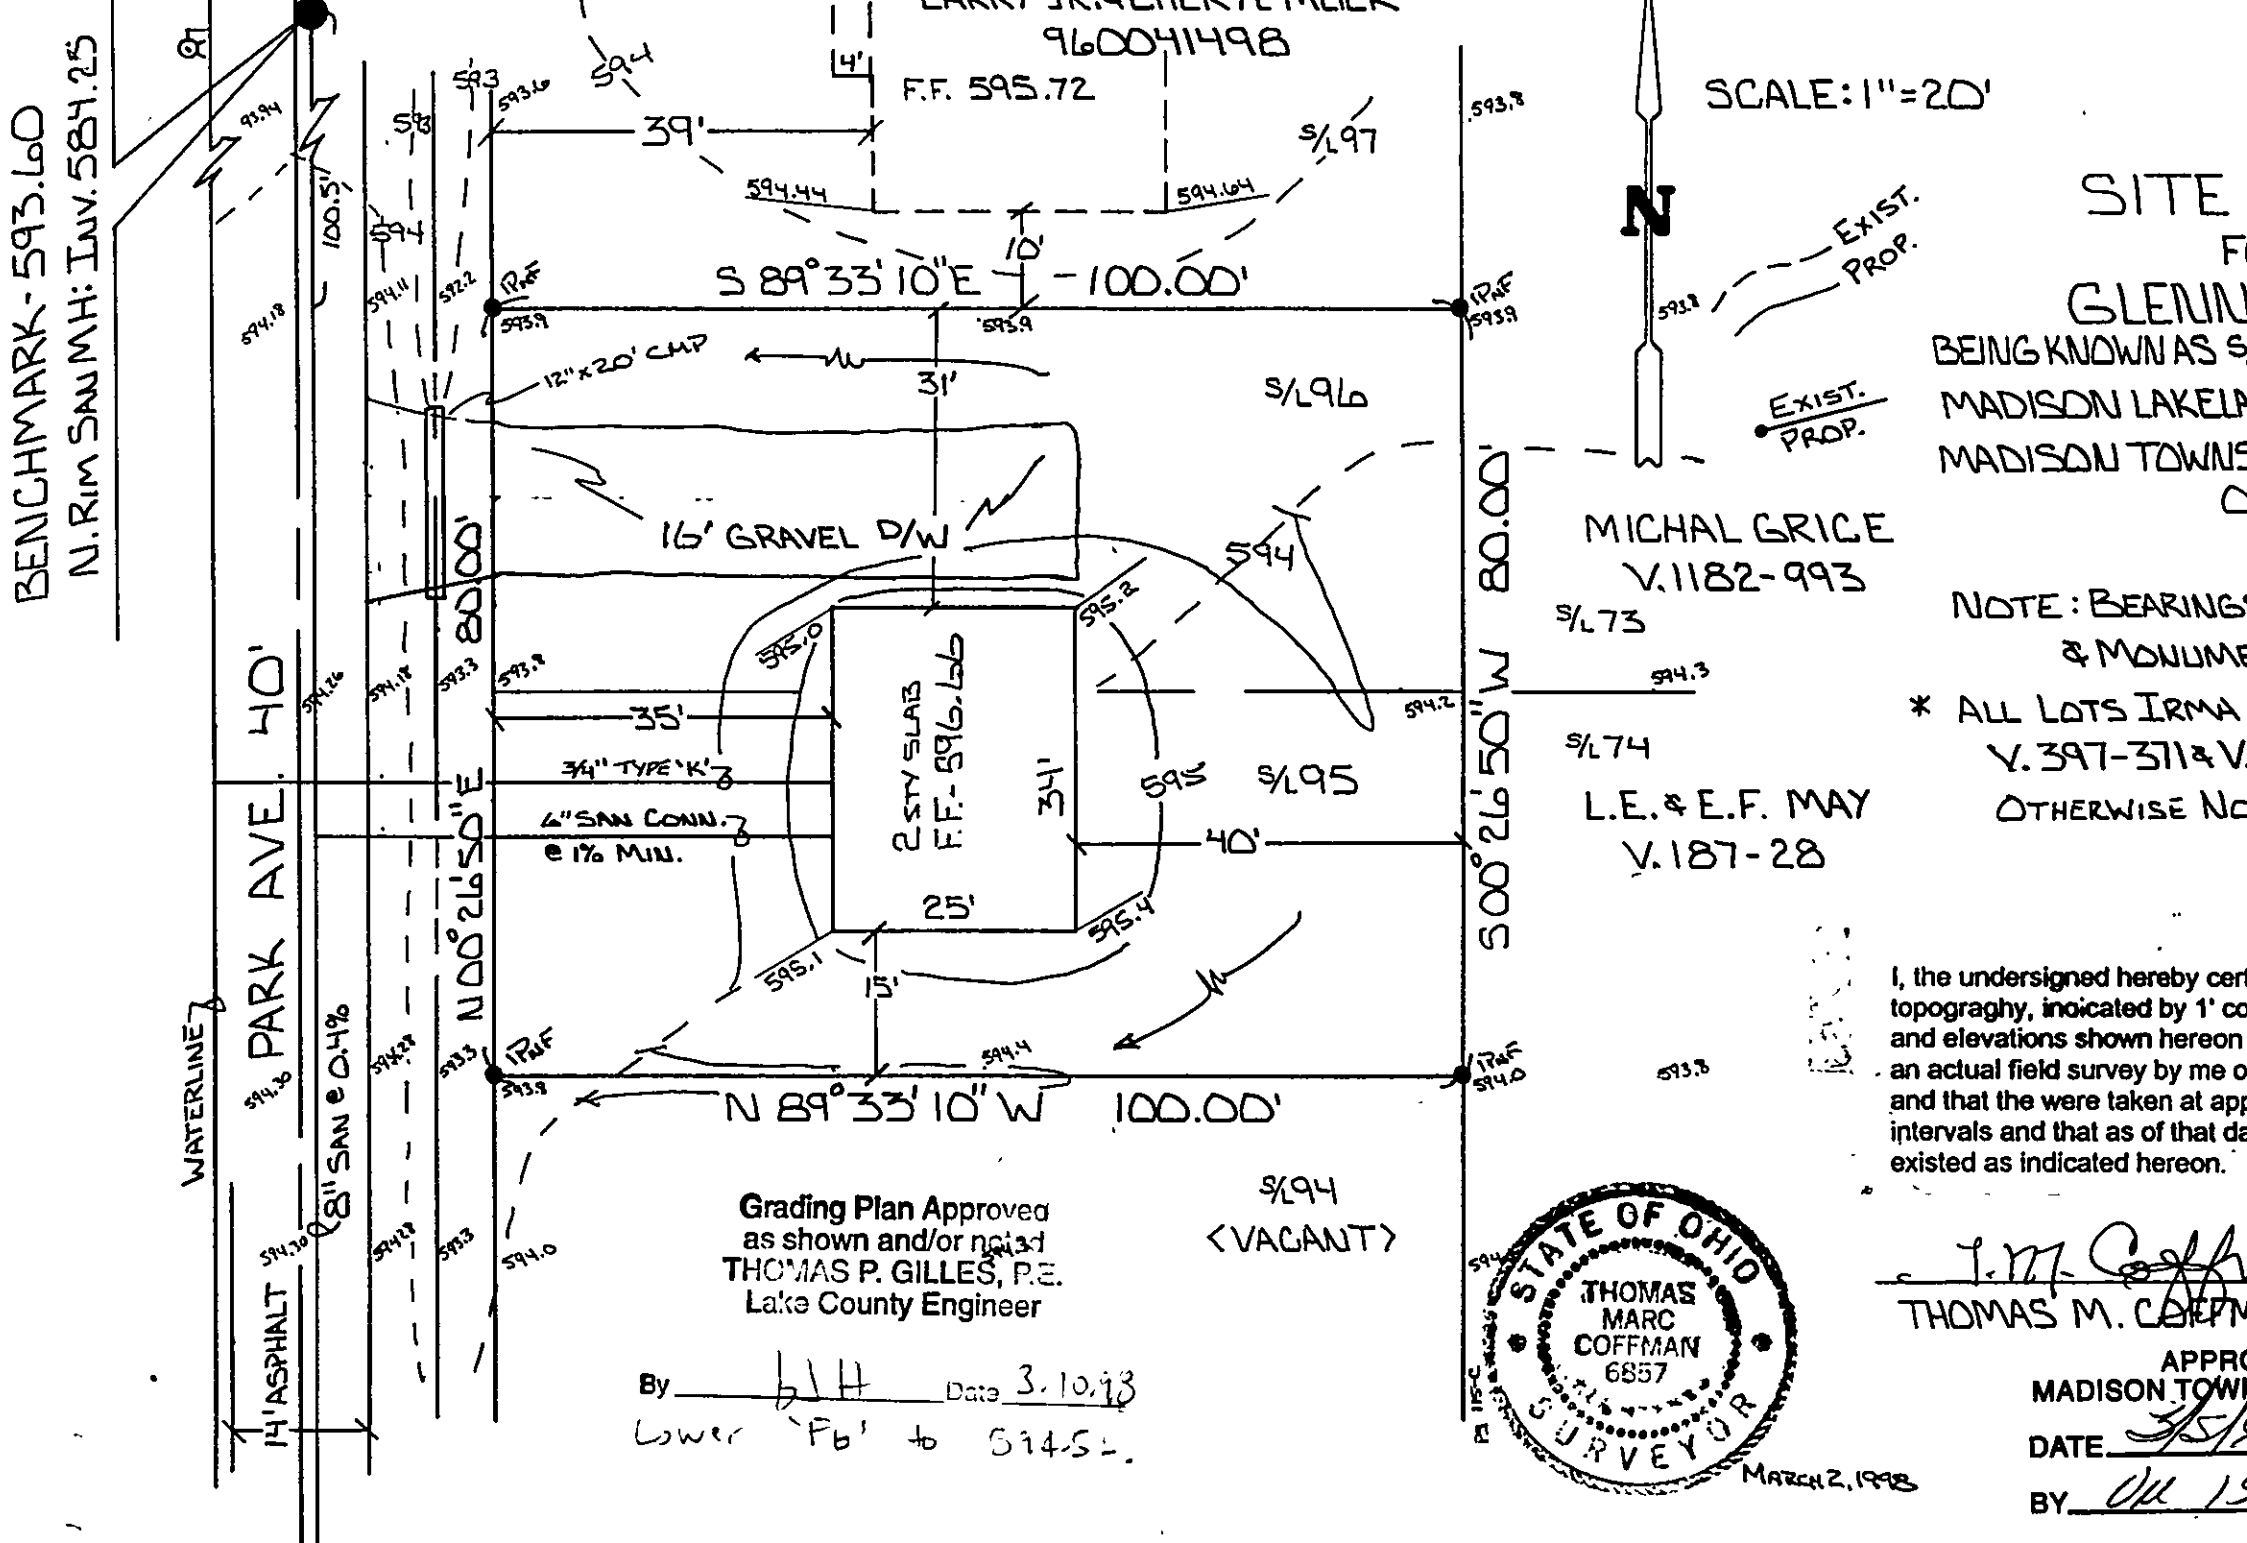

BENCHMARK - 593.60
N. RIM SAN MH: INV. 584.25
960041498
F.F. 595.72
SCALE: 1"=20'
N
S 89°33'10"E 100.00'
12"x20' CMP
16' GRAVEL D/W
2 STY SLAB F.F. - 596.66
3/4" TYPE 'K'
6" SAN CONN. @ 1% MIN.
N 00°26'50"E 80.00'
S 00°26'50"W 80.00'
N 89°33'10"W 100.00'
PARK AVE. 40'
WATERLINE
8" SAN @ 0.4%
14' ASPHALT
S/L 97
S/L 96
S/L 95
S/L 94
<VACANT>
MICHAL GRICE
V.1182-993
S/L 73
S/L 74
L.E. & E.F. MAY
V.187-28
EXIST.
PROP.
SITE
GLENN
BEING KNOWN AS S
MADISON LAKELA
MADISON TOWNS
NOTE: BEARINGS
& MONUME
* ALL LOTS IRMA
V.397-371 & V.
OTHERWISE NO
I, the undersigned hereby cer
topograghy, indicated by 1' co
and elevations shown hereon
an actual field survey by me o
and that the were taken at app
intervals and that as of that da
existed as indicated hereon.
THOMAS M. COFFM
APPRO
MADISON TOWN
DATE
BY
STATE OF OHIO
THOMAS MARC COFFMAN 6857
SURVEYOR
MARCH 2, 1998
Grading Plan Approved
as shown and/or noted
THOMAS P. GILLES, P.E.
Lake County Engineer
By
Date 3.10.98
Lower 'Fb' to 594.52