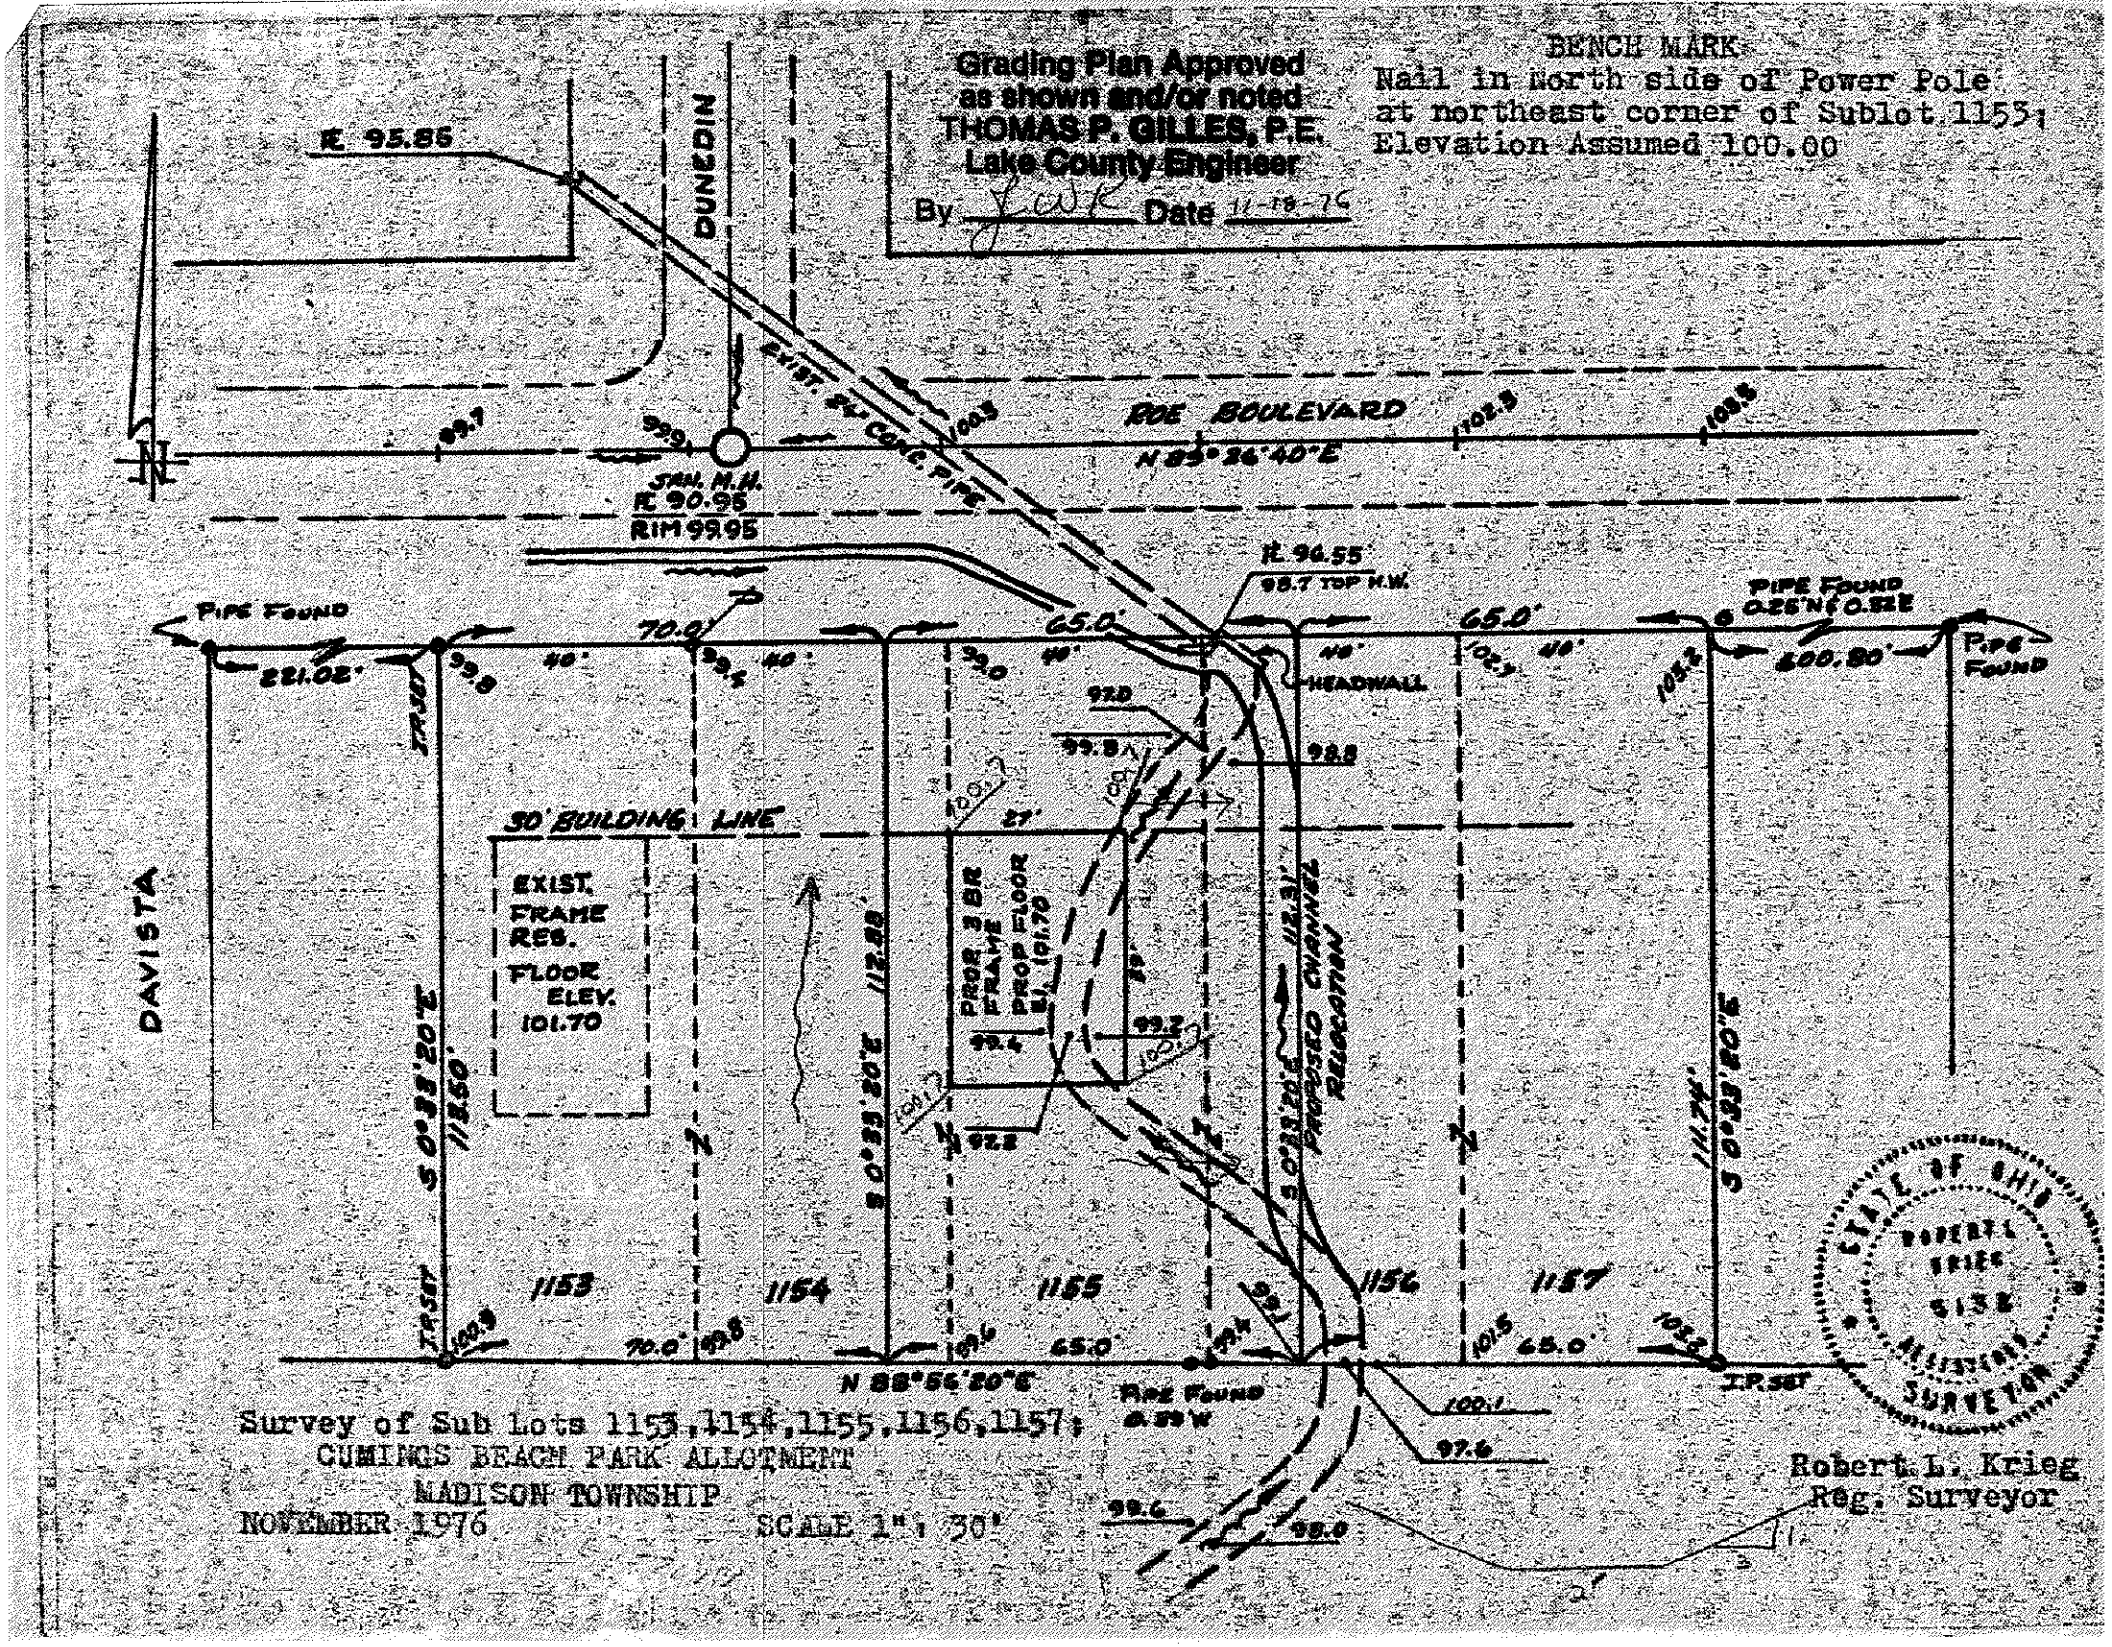

Survey of Sub Lots 1153,1154,1155,1156,1157;
CUMINGS BEACH PARK ALLOTMENT
MADISON TOWNSHIP
NOVEMBER 1976 SCALE 1": 30'

Robert L. Krieg
Reg. Surveyor