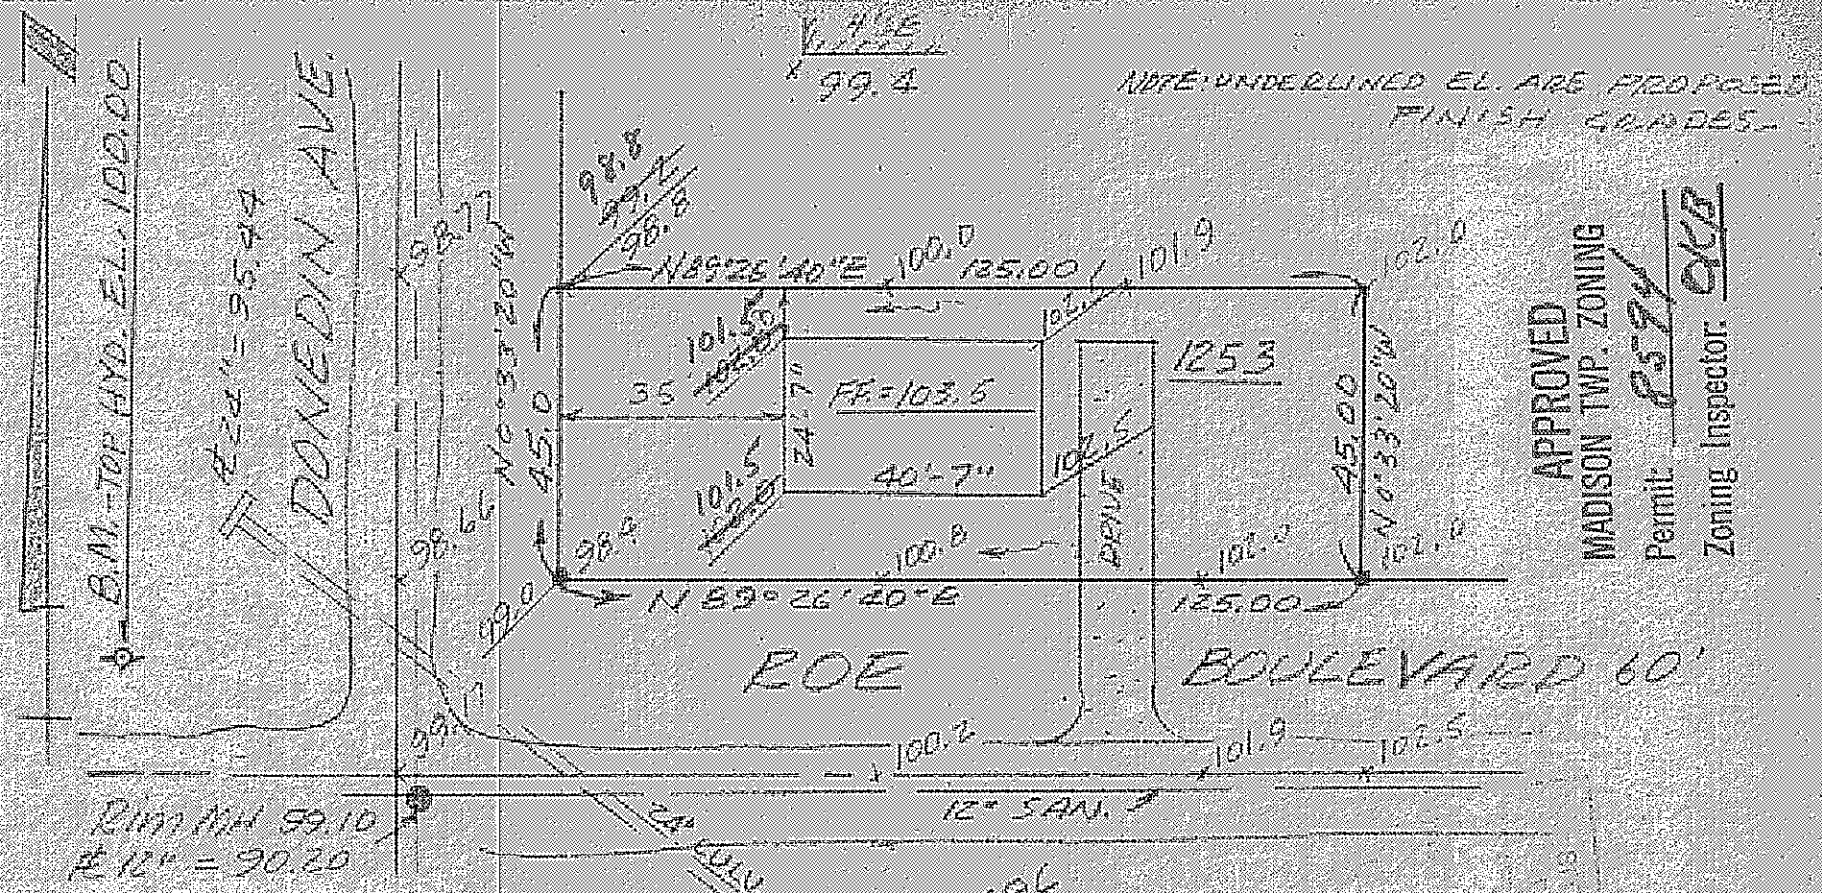

Grading Plan Approved
as shown and/or noted
THOMAS P. GILLES, P.E.
Lake County Engineer

AS BUILT CERTIFICATION

GRADING PLAN By [signature] Date 17 Aug 72 I HEREBY CERTIFY THAT THE CIRCLED GRADES ARE EXISTING FINISH GRADES CHECKED IN THE FIELD ON 197 SURVEY IS CORRECT TO THE BEST OF MY KNOWLEDGE AND BELIEF.

FOR

GINGER CONSTR. CO.

S/L 1253 CUMINGS BEACH PARK

MADISON TWP. - LAKE COUNTY, OHIO

SCALE: 1" = 30' MAY, 1972

FULLERTON-KERR & ASSOC.

by _____
REG. SURVEYOR No.